

3/3 HARPORT. PROFILE + DECK PLAN

SHOWING


ARRANGEMENT OF OIL-CARGO TANKS

SCALE 1/8" = 1 FOOT.

For correct position of bulkhead etc. please see
General arrangement as follows

13.6.12
19.6.12
27.6.12
31.7.12
8.8.12
16.8.12

Long oil tank at
middle of
deck. Double
special apparatus
means of oil tank
in this tank


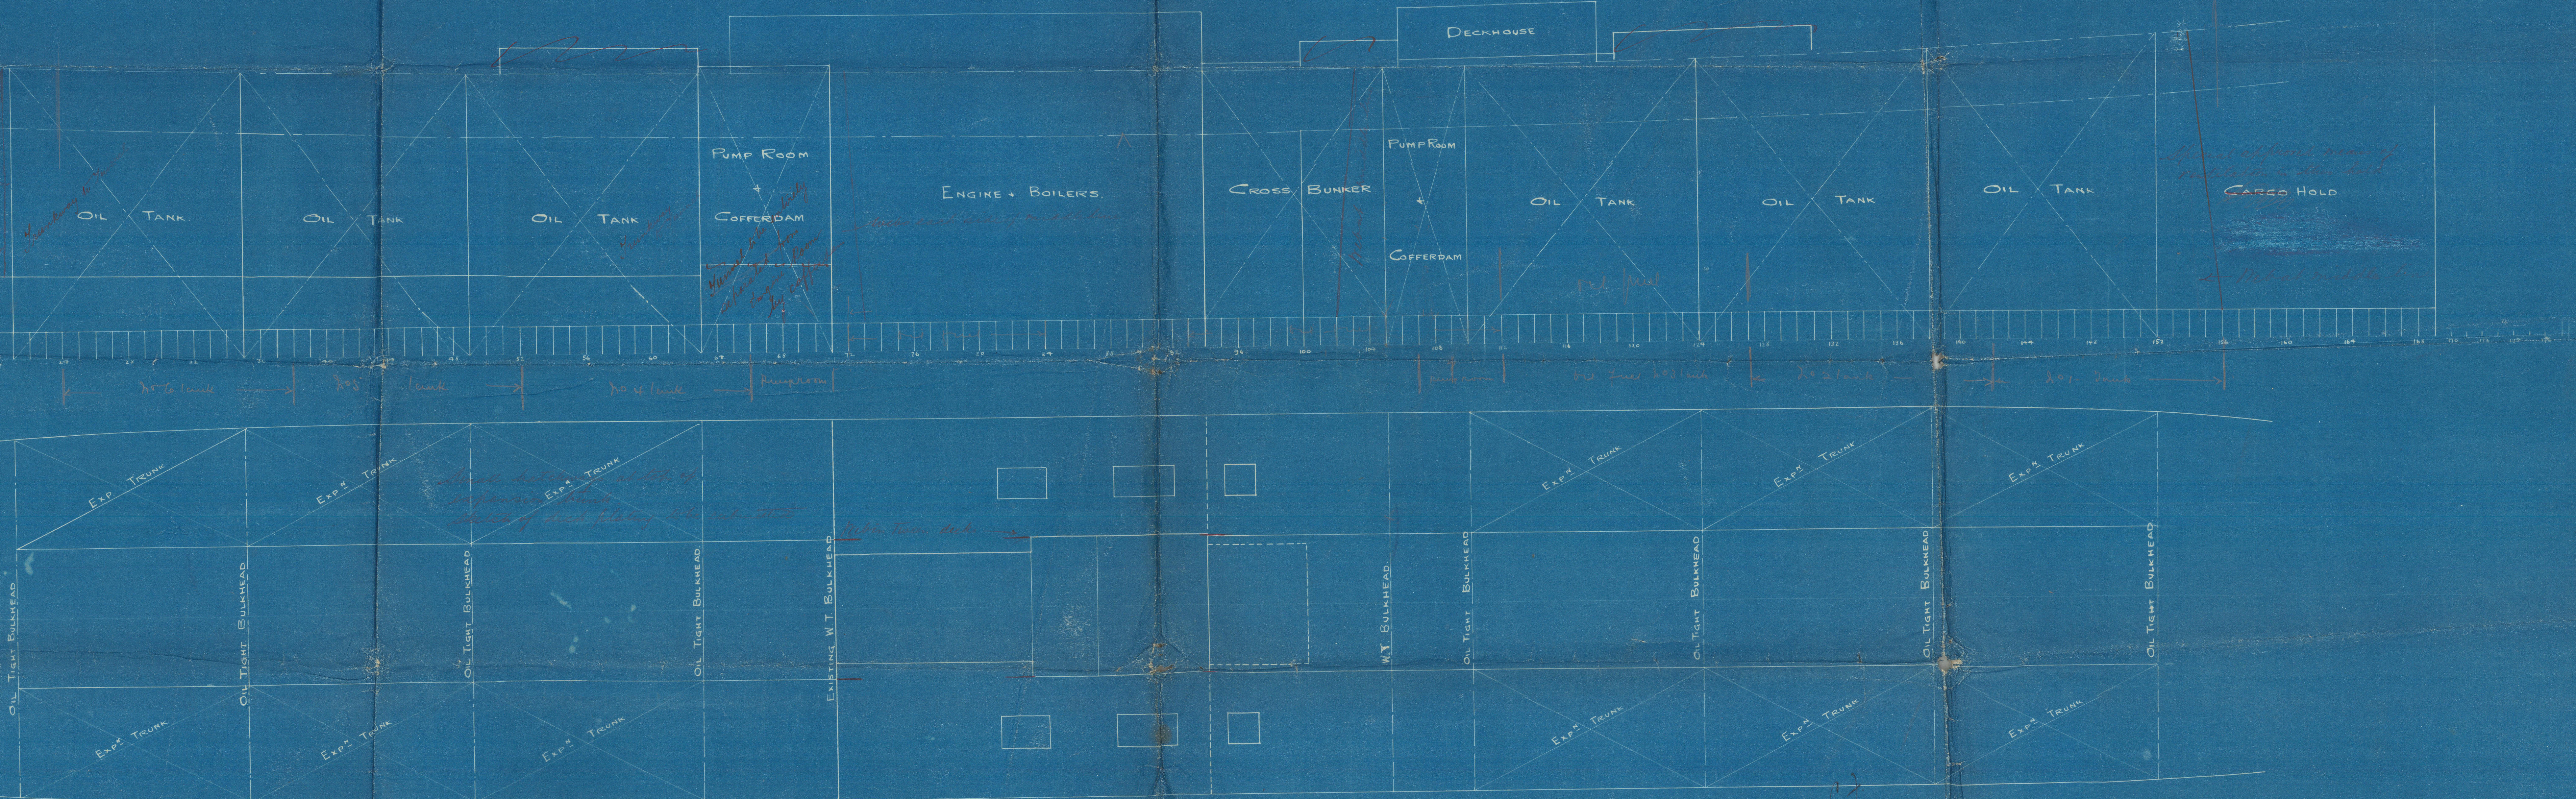


S.S. "Harport"

Proper Deck plan
shown

Arrangement of Oil Tank

Reb. Report 7629

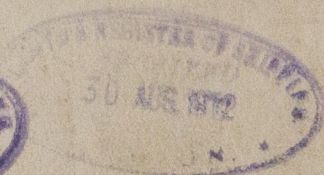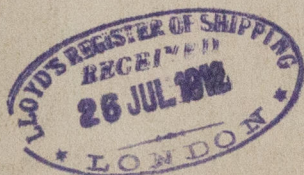

W 109-0013



Lloyd's Register
Foundation