


S/S HARPORT.  
PLAN SHEWING AMENDED POSITION OF OIL HATCHES ON BRIDGE DECK.  
SCALE 1/8" = 1 FOOT.


Oil Hatch Coamings 6 x 8 . 45 ANGLE  
WITH 9" RADIUS CORNERS  
BEAMS CONTINUED THRO OIL HATCHES.

143  
25-7-12.  
LLOYD'S REGISTER OF SHIPPING

C.B.  
8-8-12.

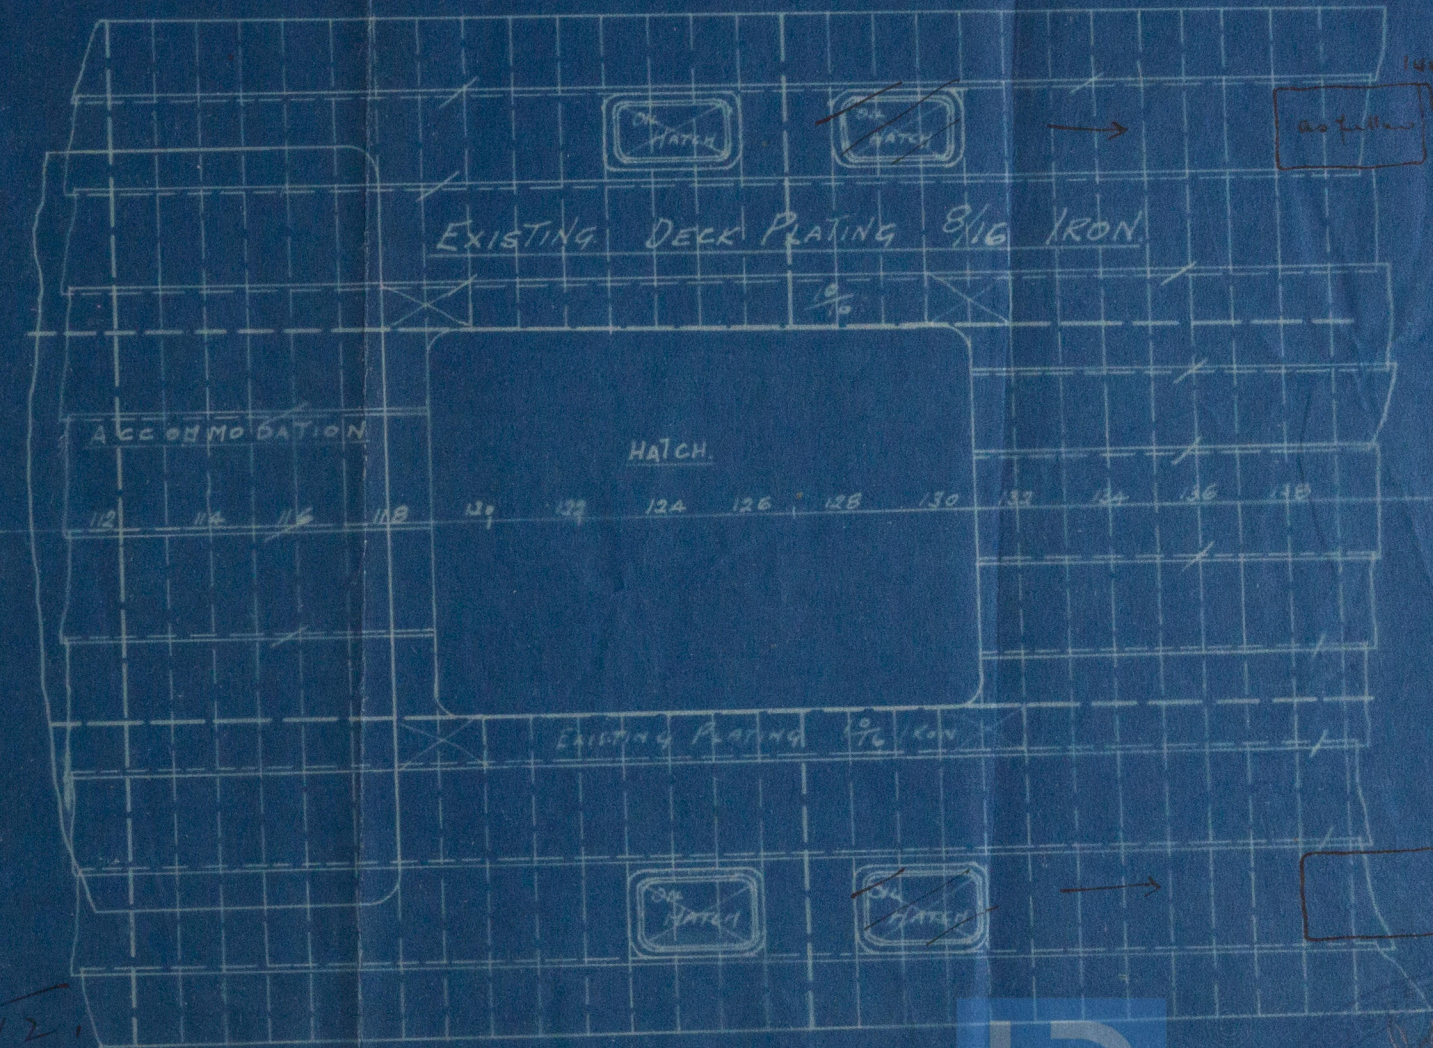

W109-00


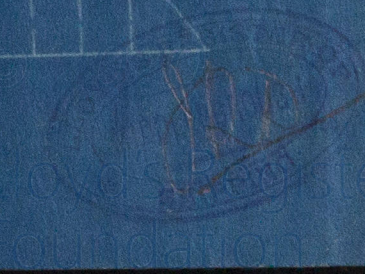




S.S. Harpore

Grounded position of  
Ore. hatch on Bridge Deck

Lab. Report 7623

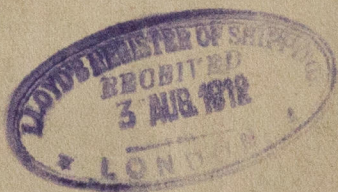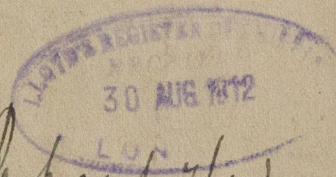

W/109-0014



Lloyd's Register  
Foundation