


SECTION AT WEB FRAMES.

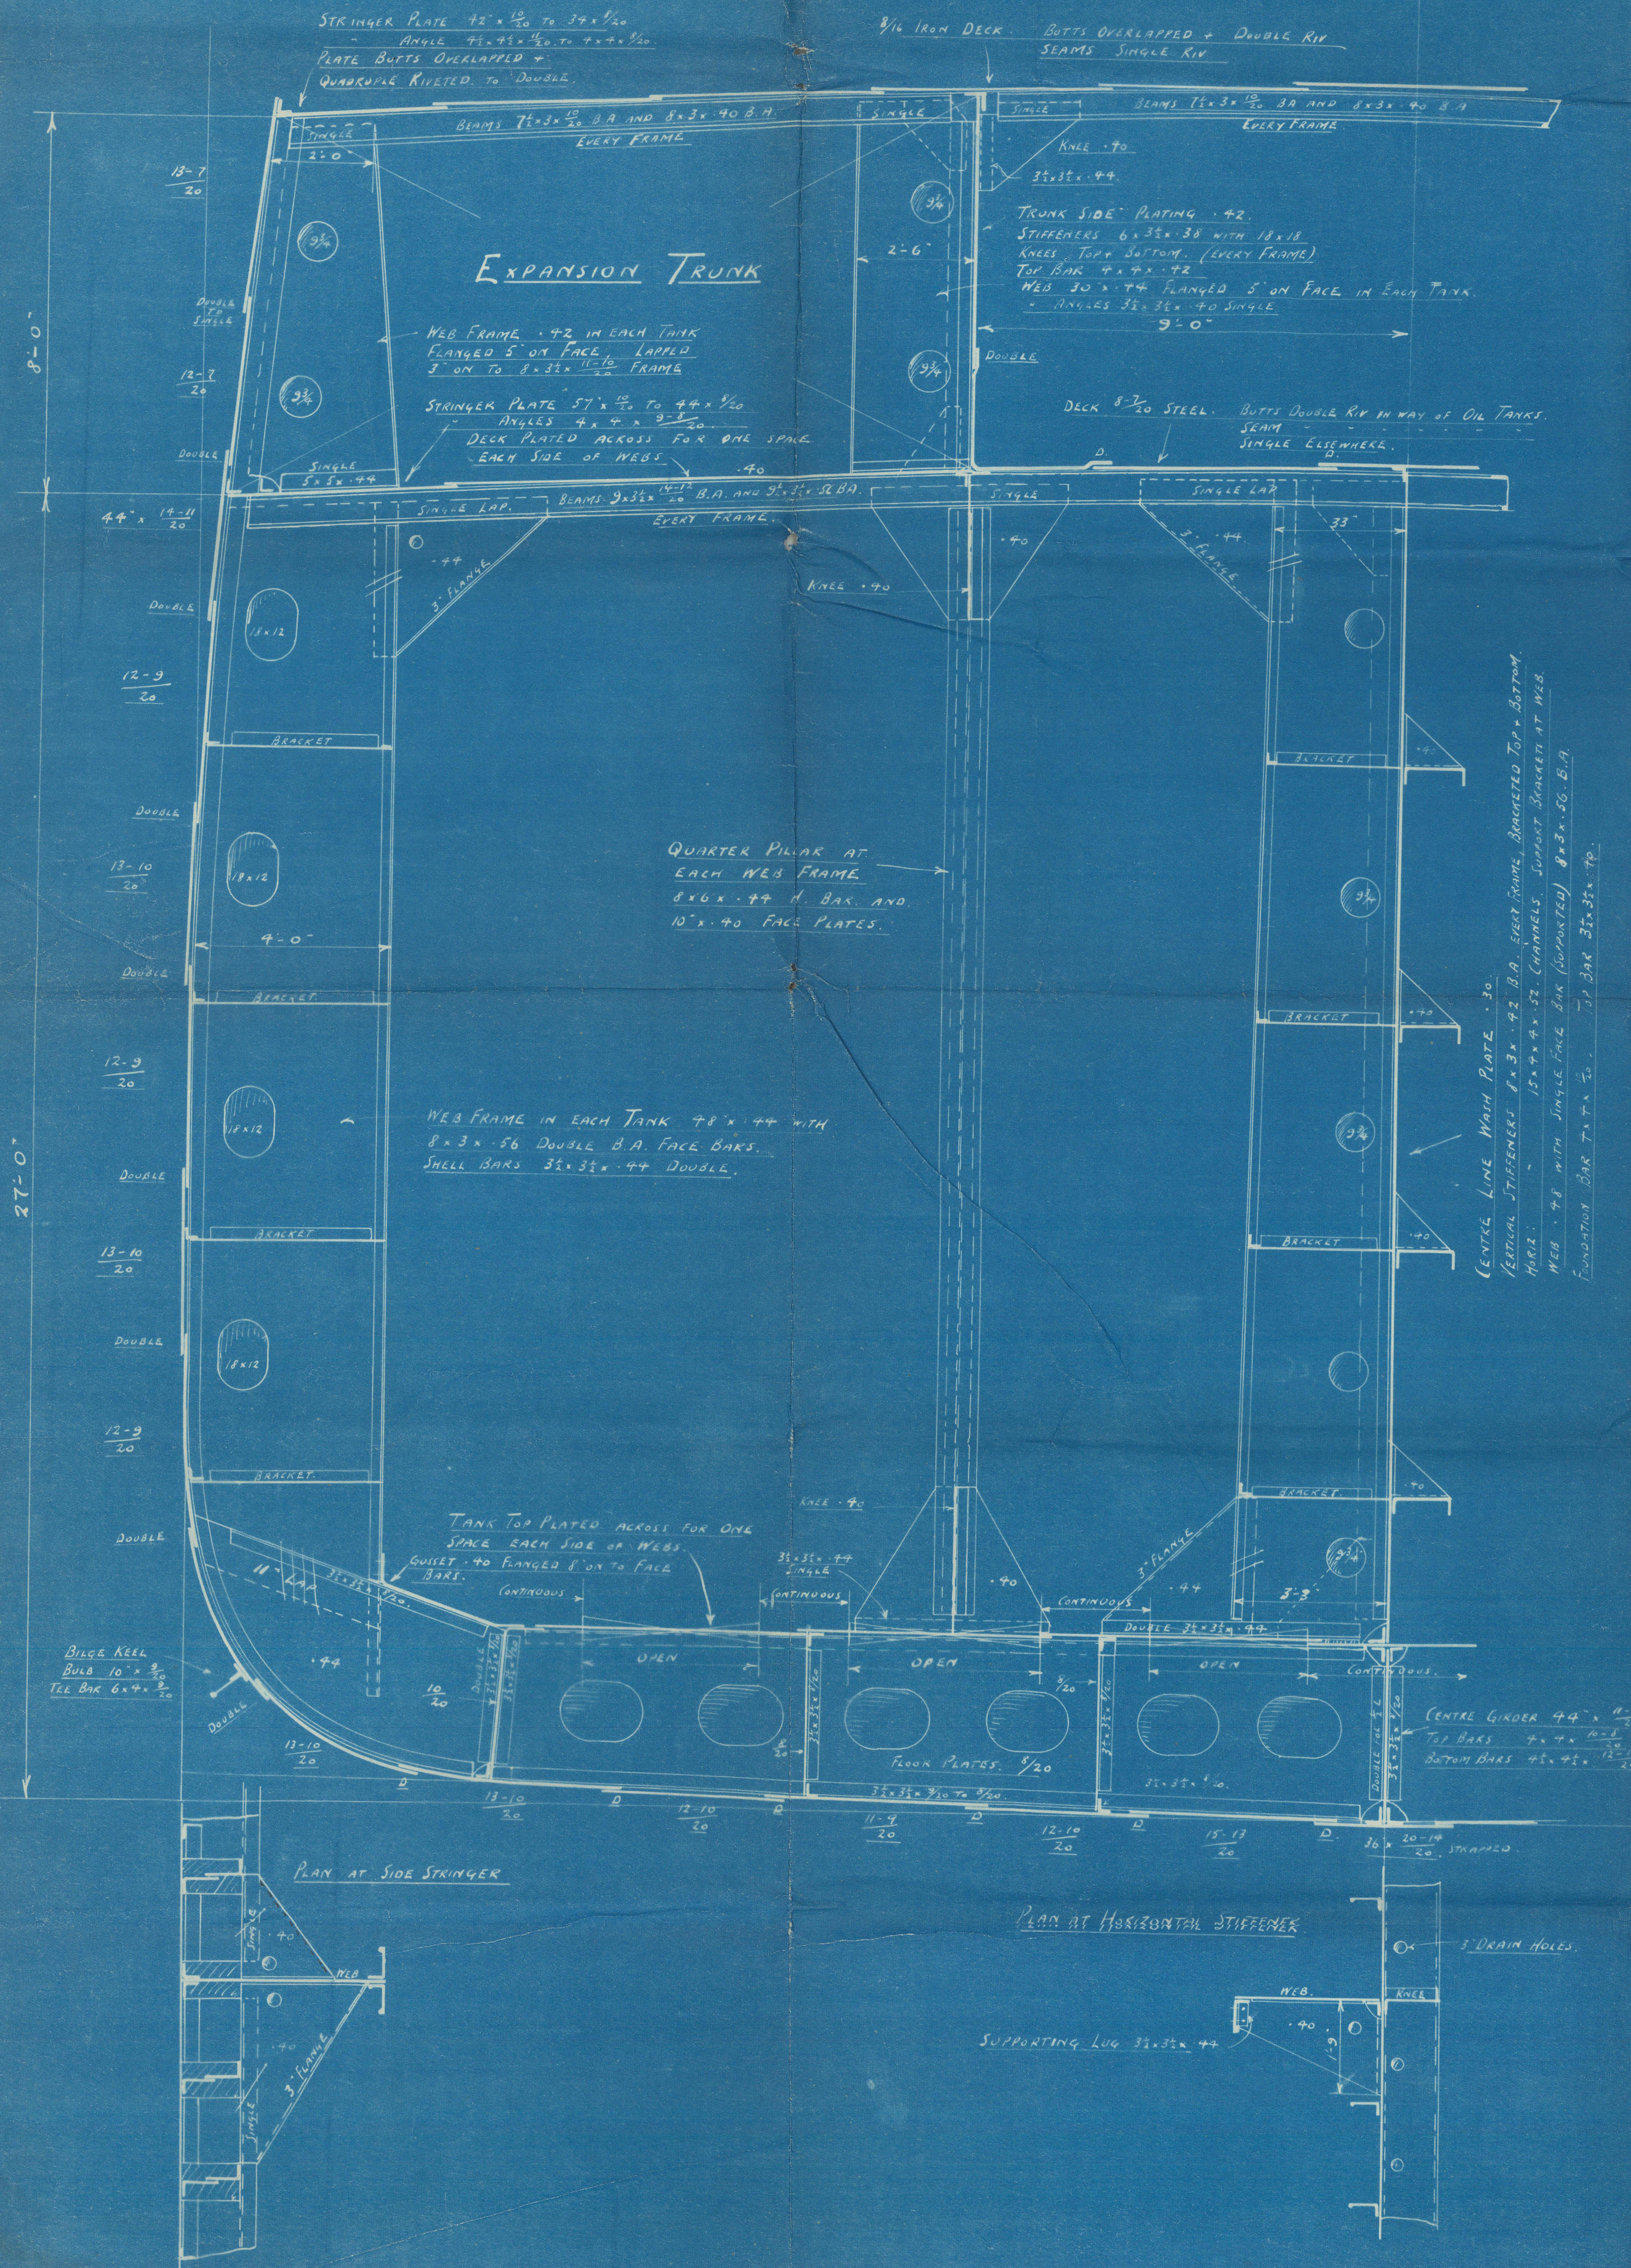

"HARPORT"

TO CLASS 100 A.I. AT LLOYD'S

SCALE $\frac{1}{2} = 1$ FOOT


PRINCIPAL DIMENSIONS.

LENGTH B.P. --- 370'-0"


BREADTH E.T. --- 50'-0"

DEPTH MLD --- 27'-0"

SECTION AT TUNNEL

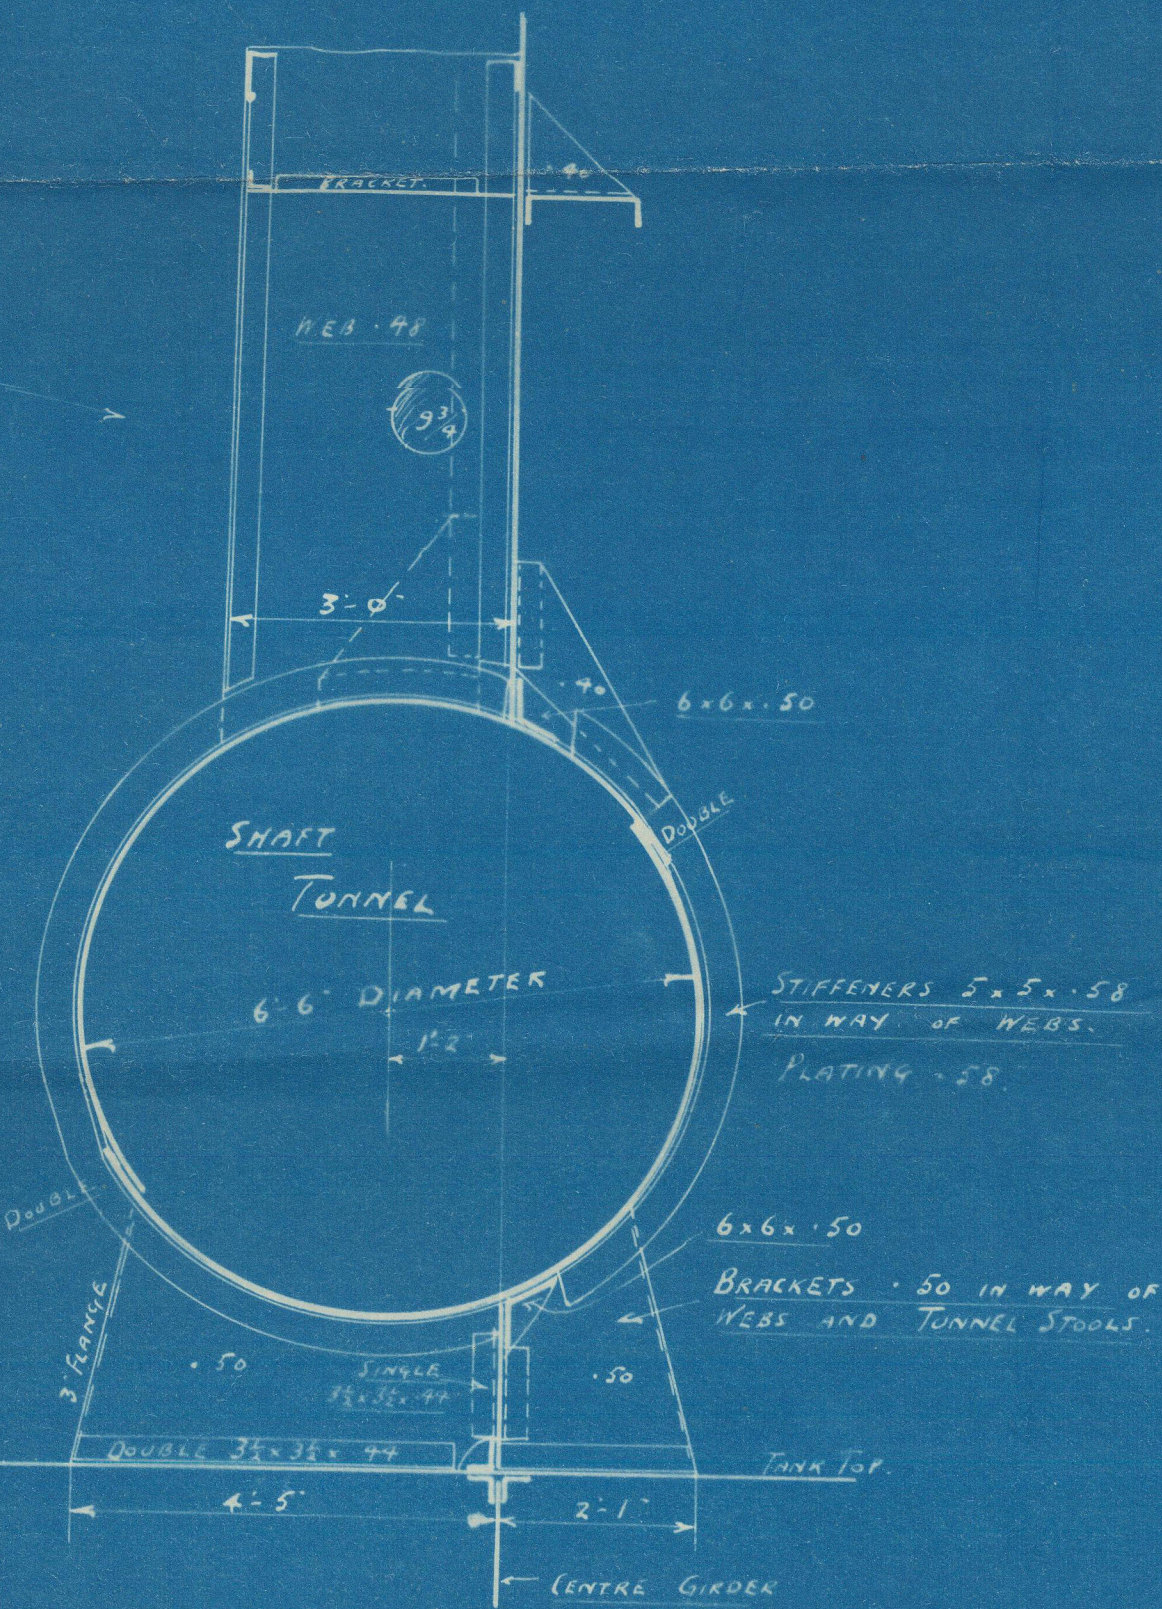

SECTION CLEAR OF WEB FRAME

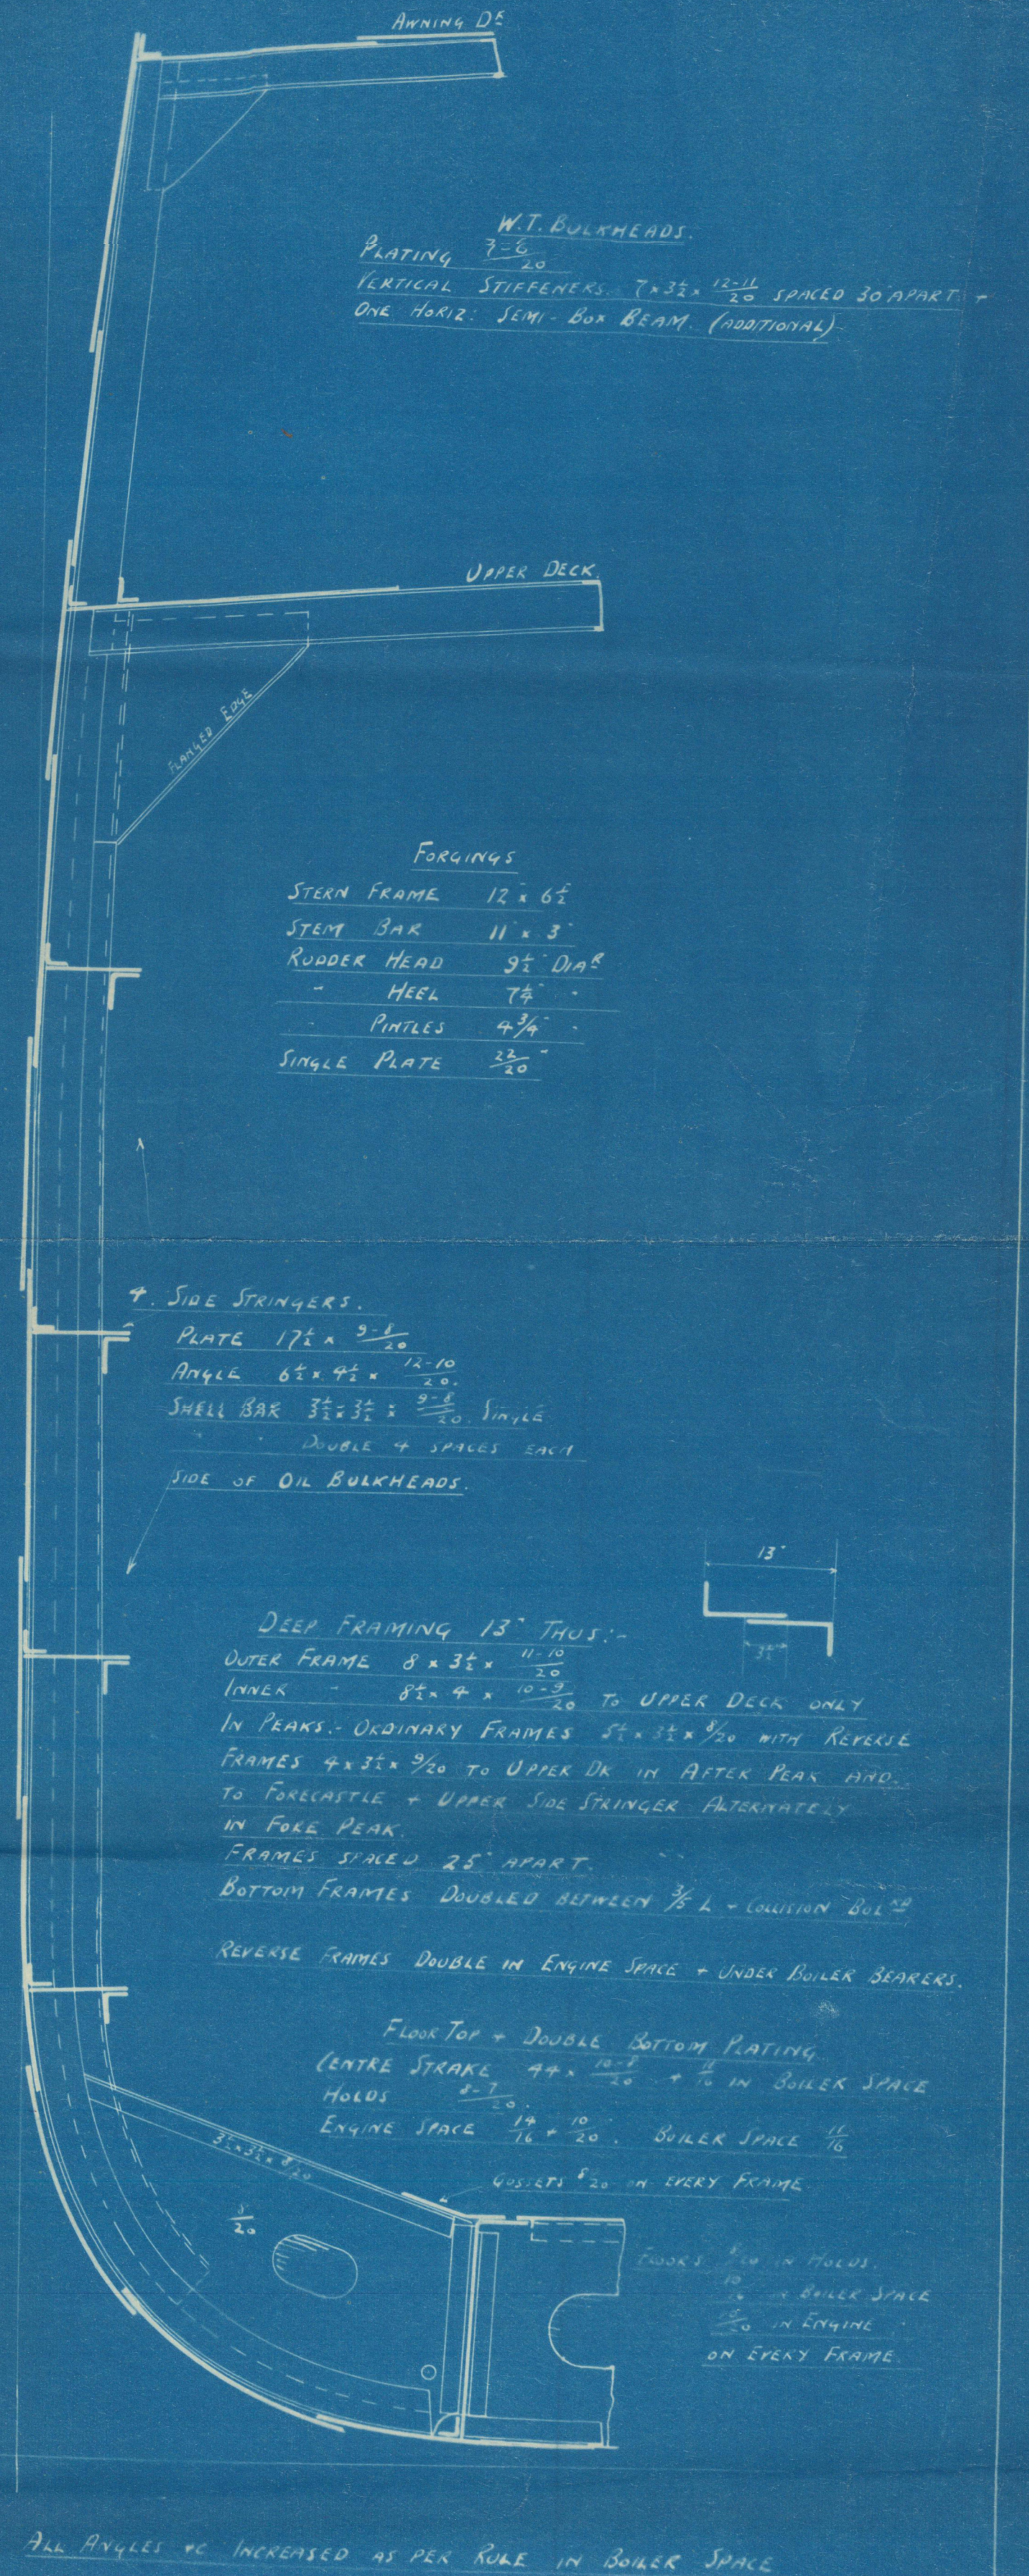

" S. S. Harport "

Ownership Section

(as filled)

Mat. Report 7/6/23



W109- 0015



© 2020

Lloyd's Register
Foundation