


S. S. Harport.

Amended arrangement
of pumping, water
compartment

W. B. Report 7623

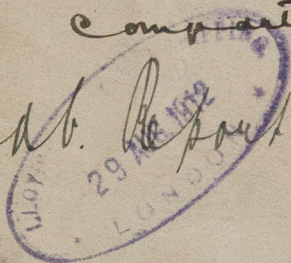


W109-0020



© 2020

Lloyd's Register
Foundation

29/8/12.
 TREASURY OF SHIPS
 LONDON

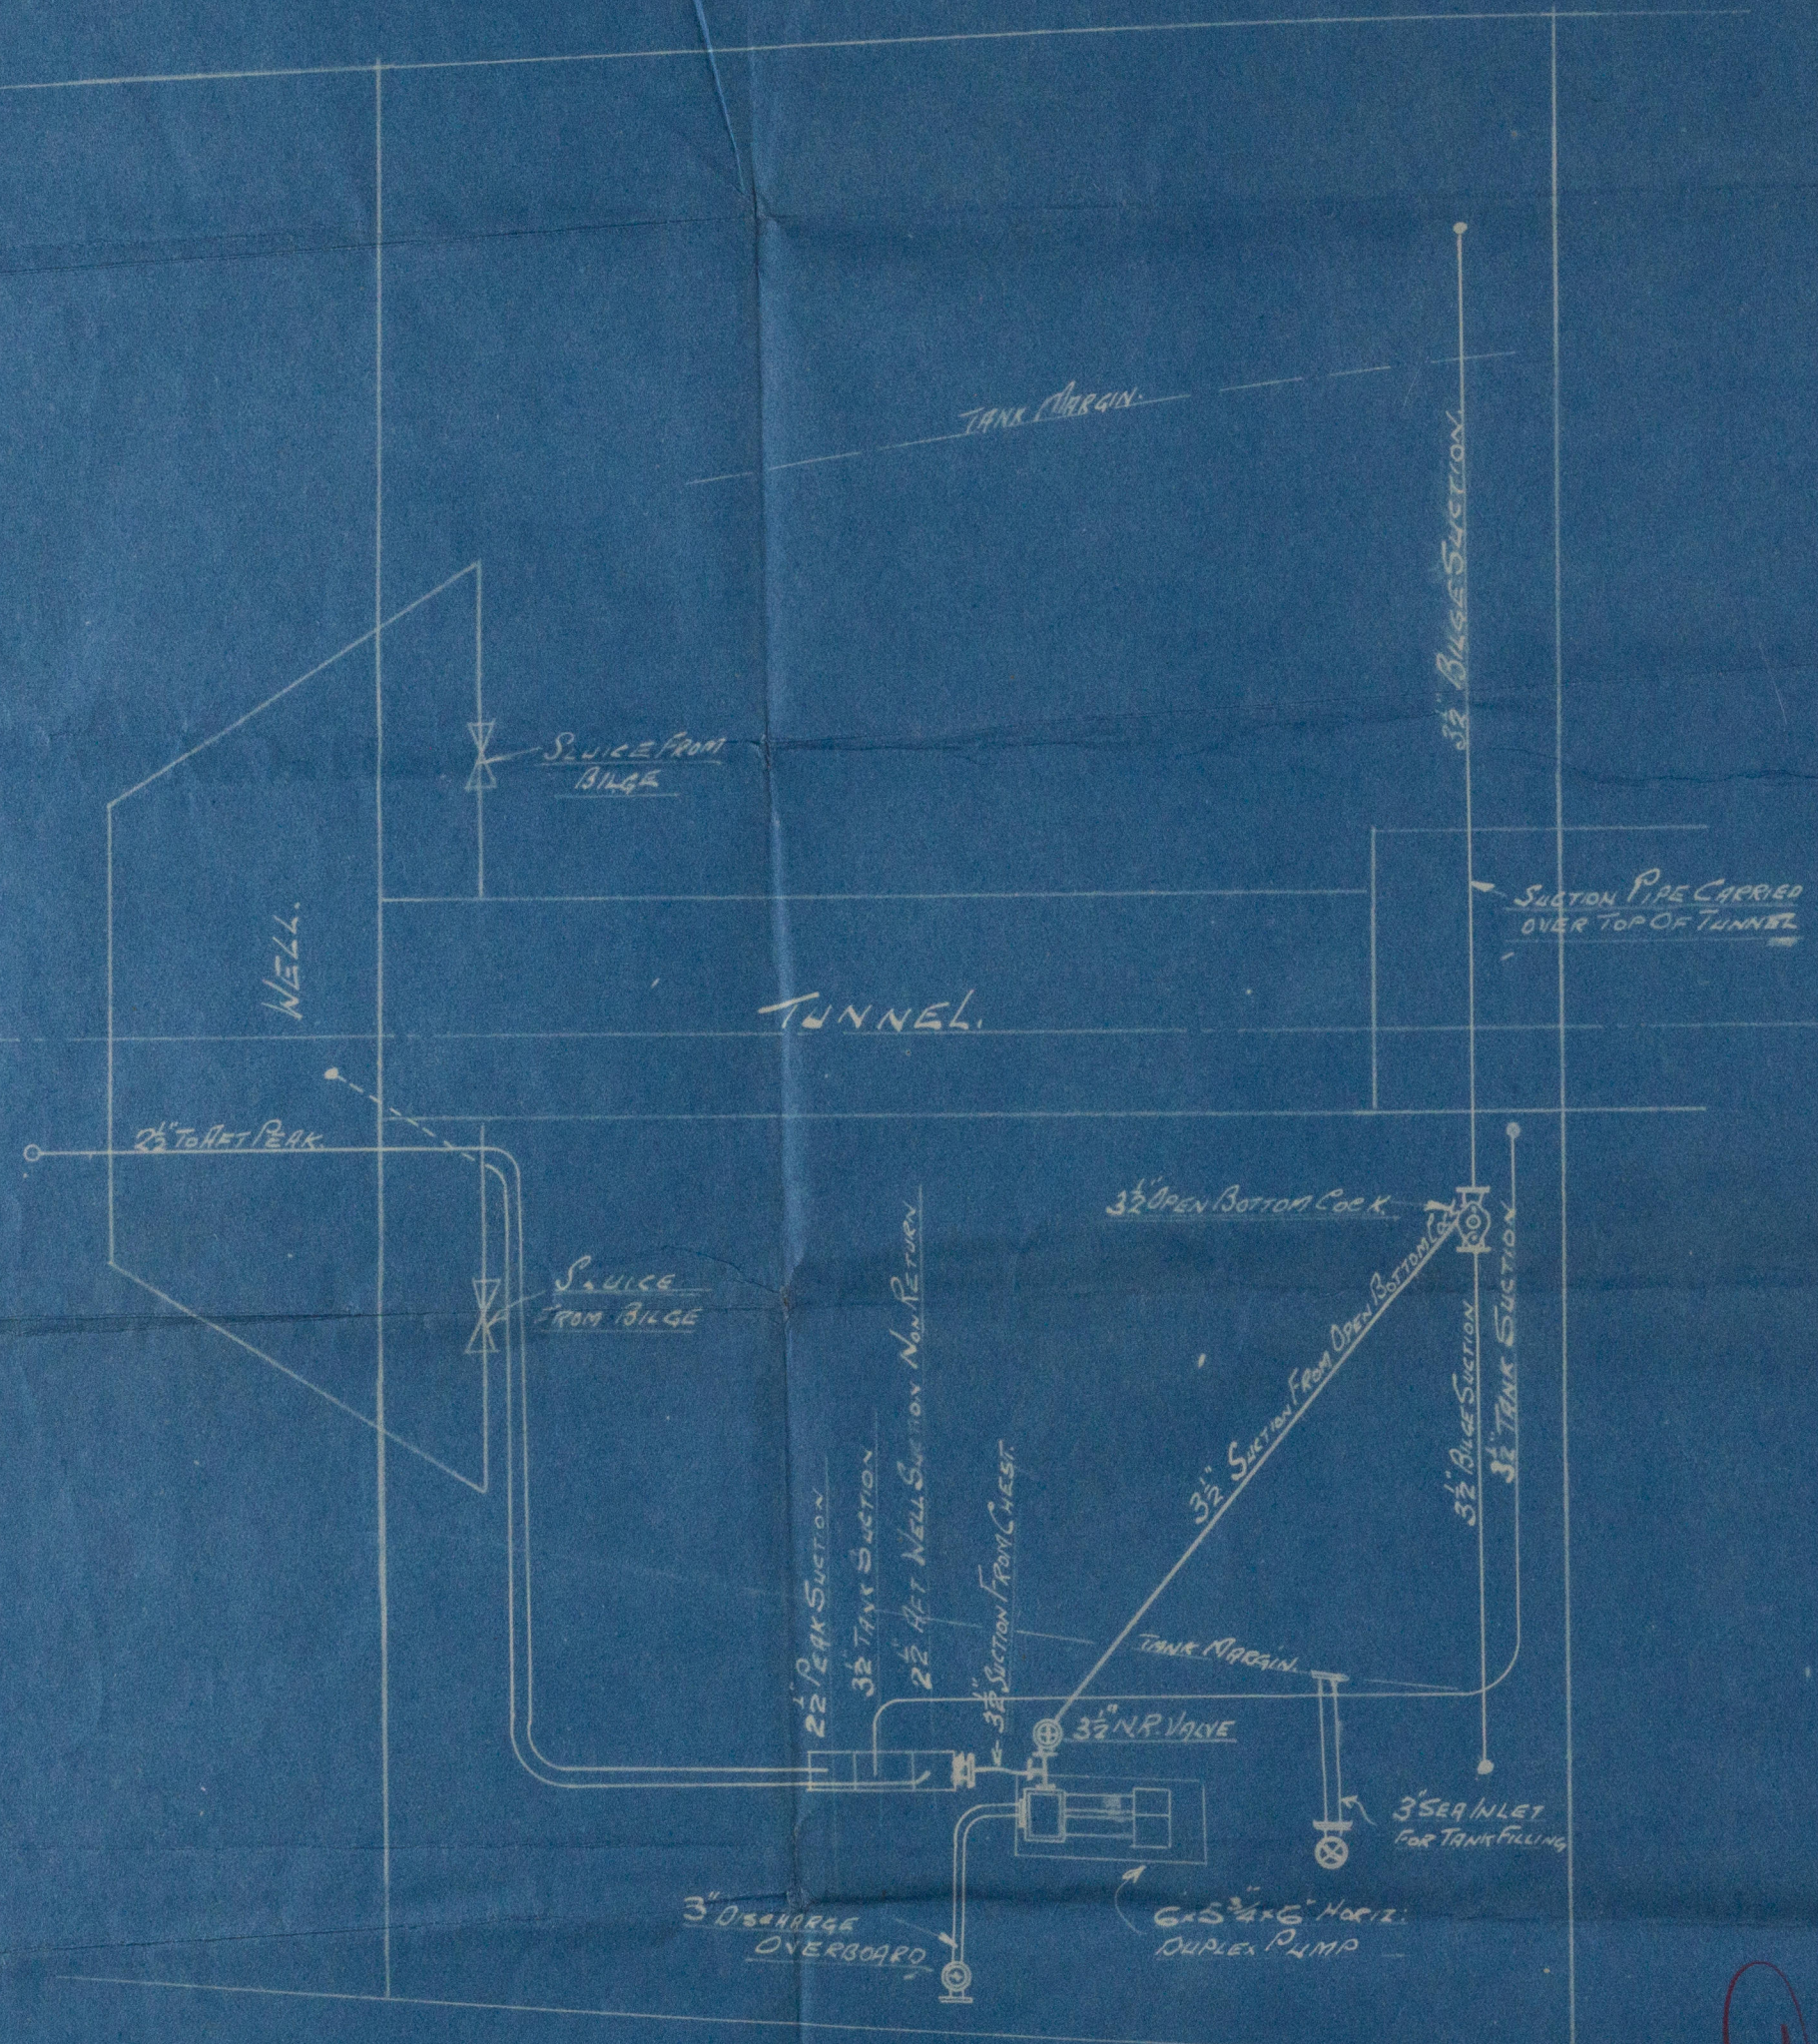

AMENDED SKETCH SHOWING PUMPING
 ARRANGEMENT. FOR AFT COMPARTMENTS
 S/S HARPORT.

Approved by
 Lloyd's
 30/8/12

SMITH'S DOCK CO. LTD.
 ENGINE
 27 AUG 1912
 DEPARTMENT
 SOUTH BANK, MIDDLEBROUGH

R

Lloyd's Register
 1009-0020