



16.5.12


ELEVATION.

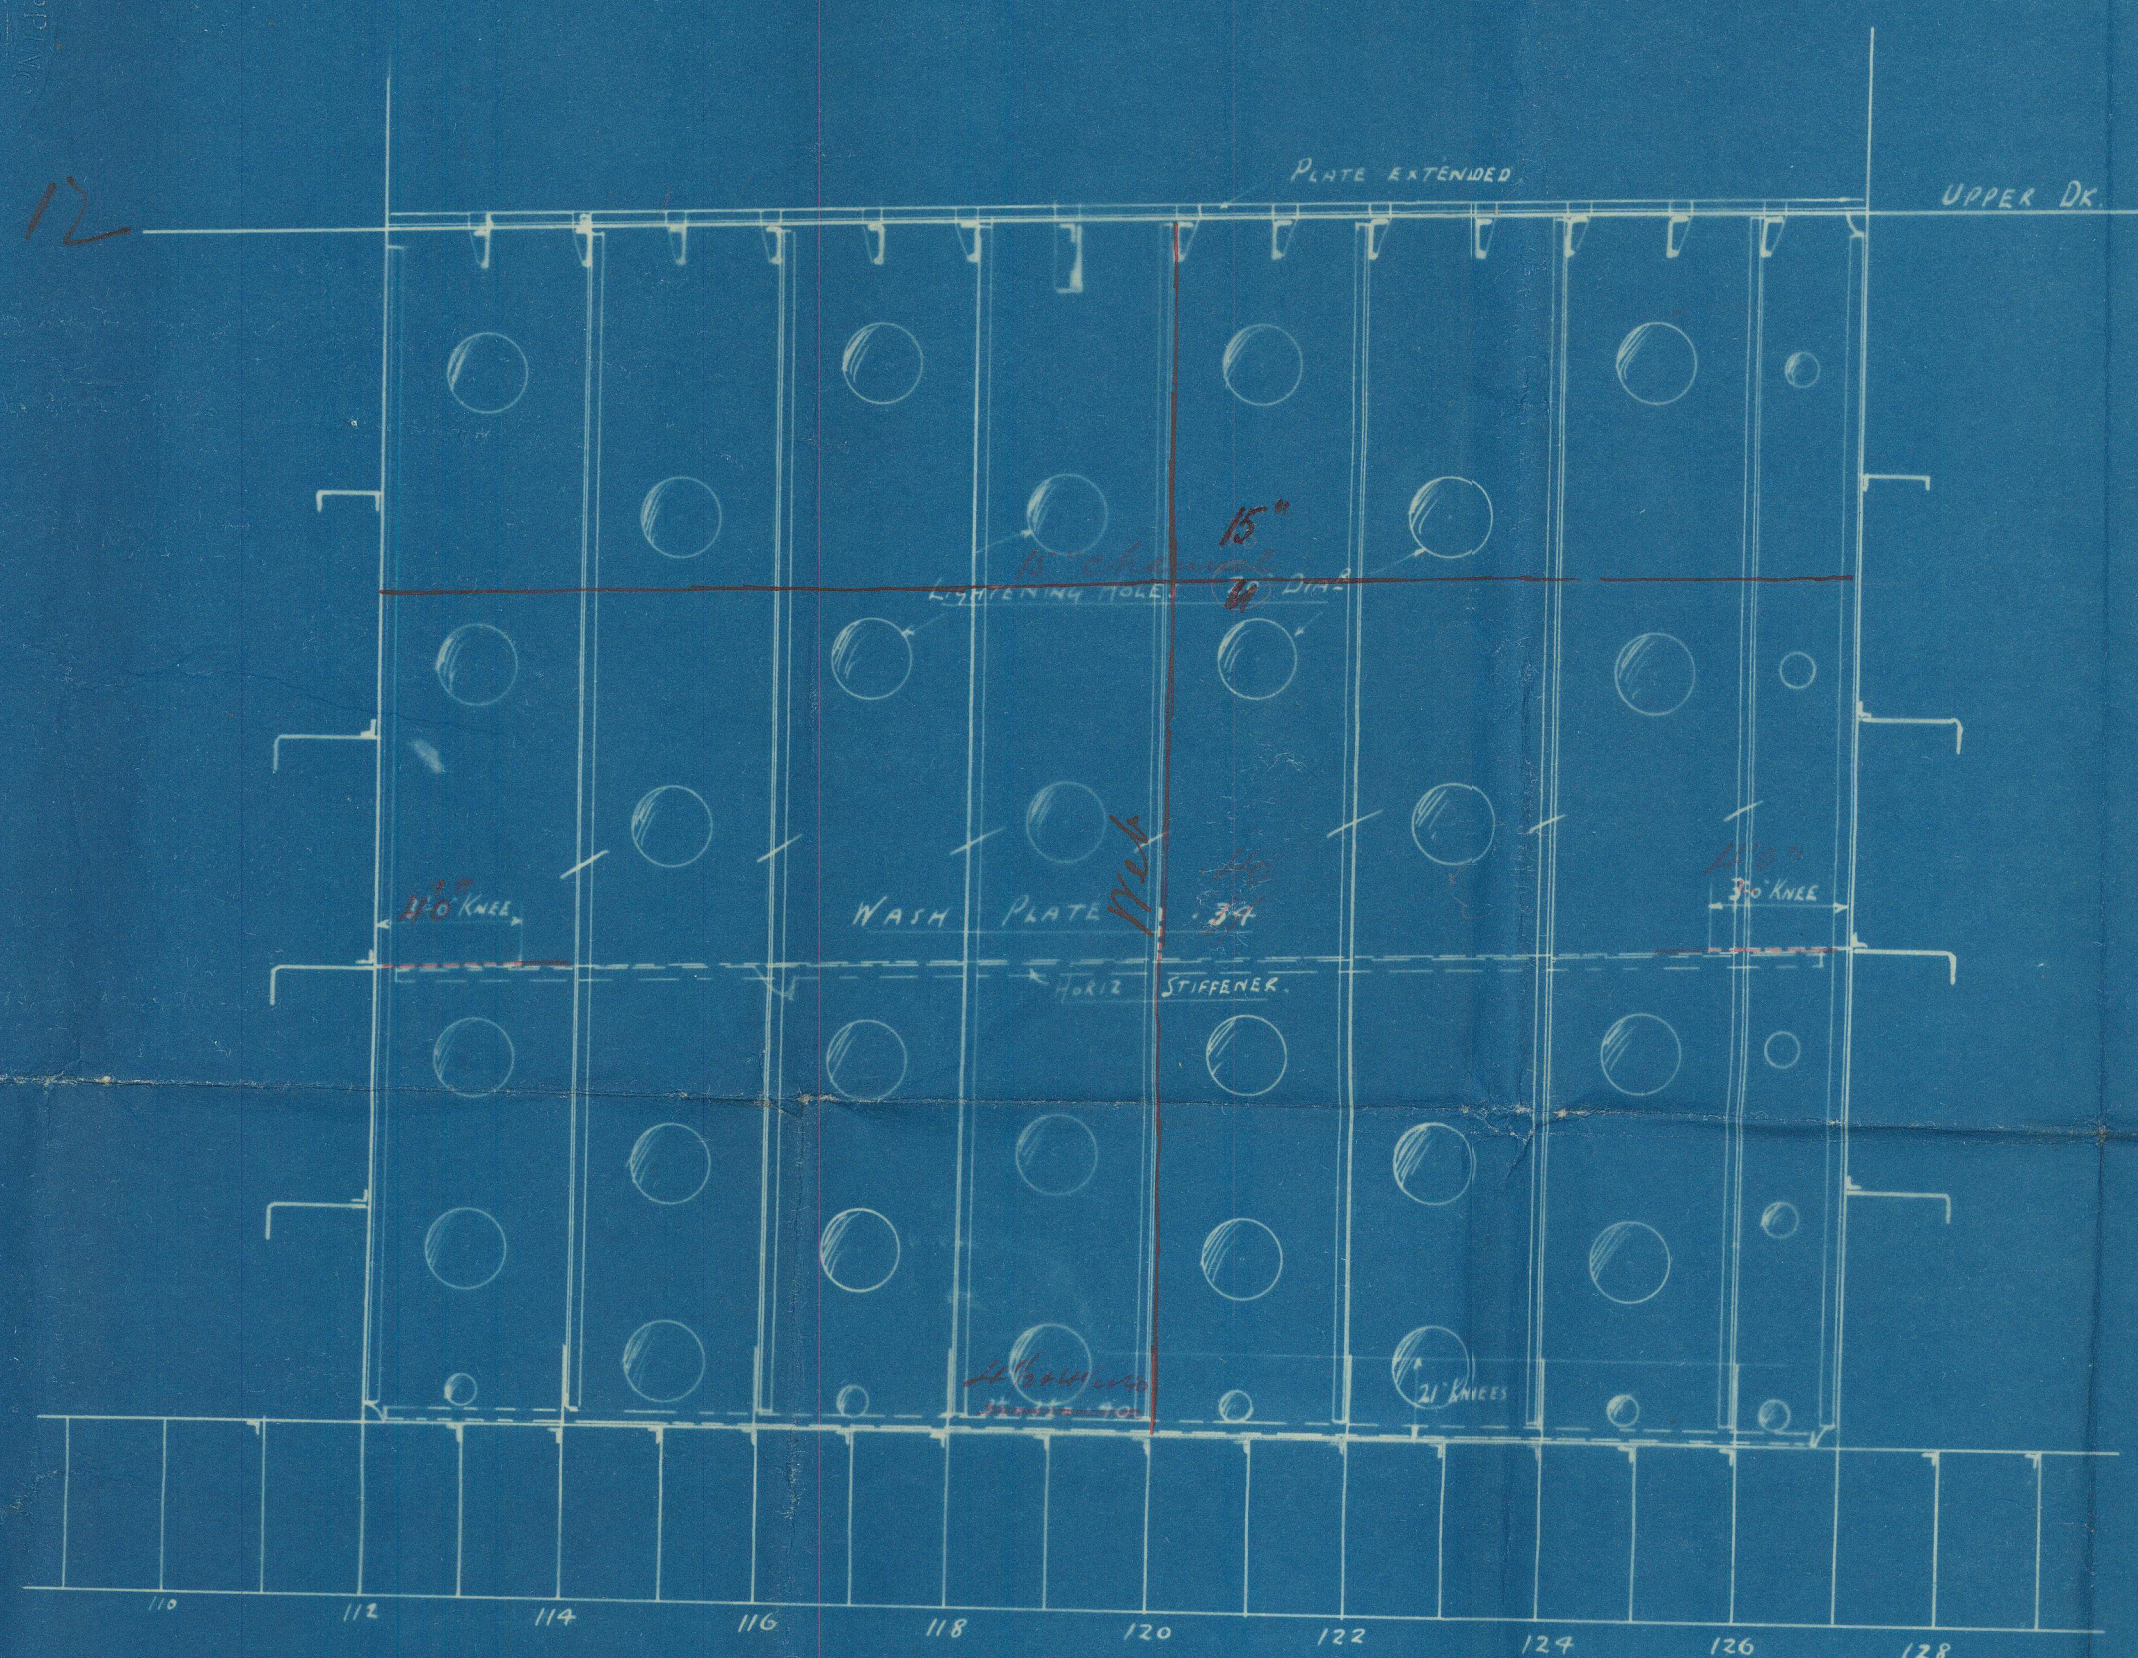

PLAN.

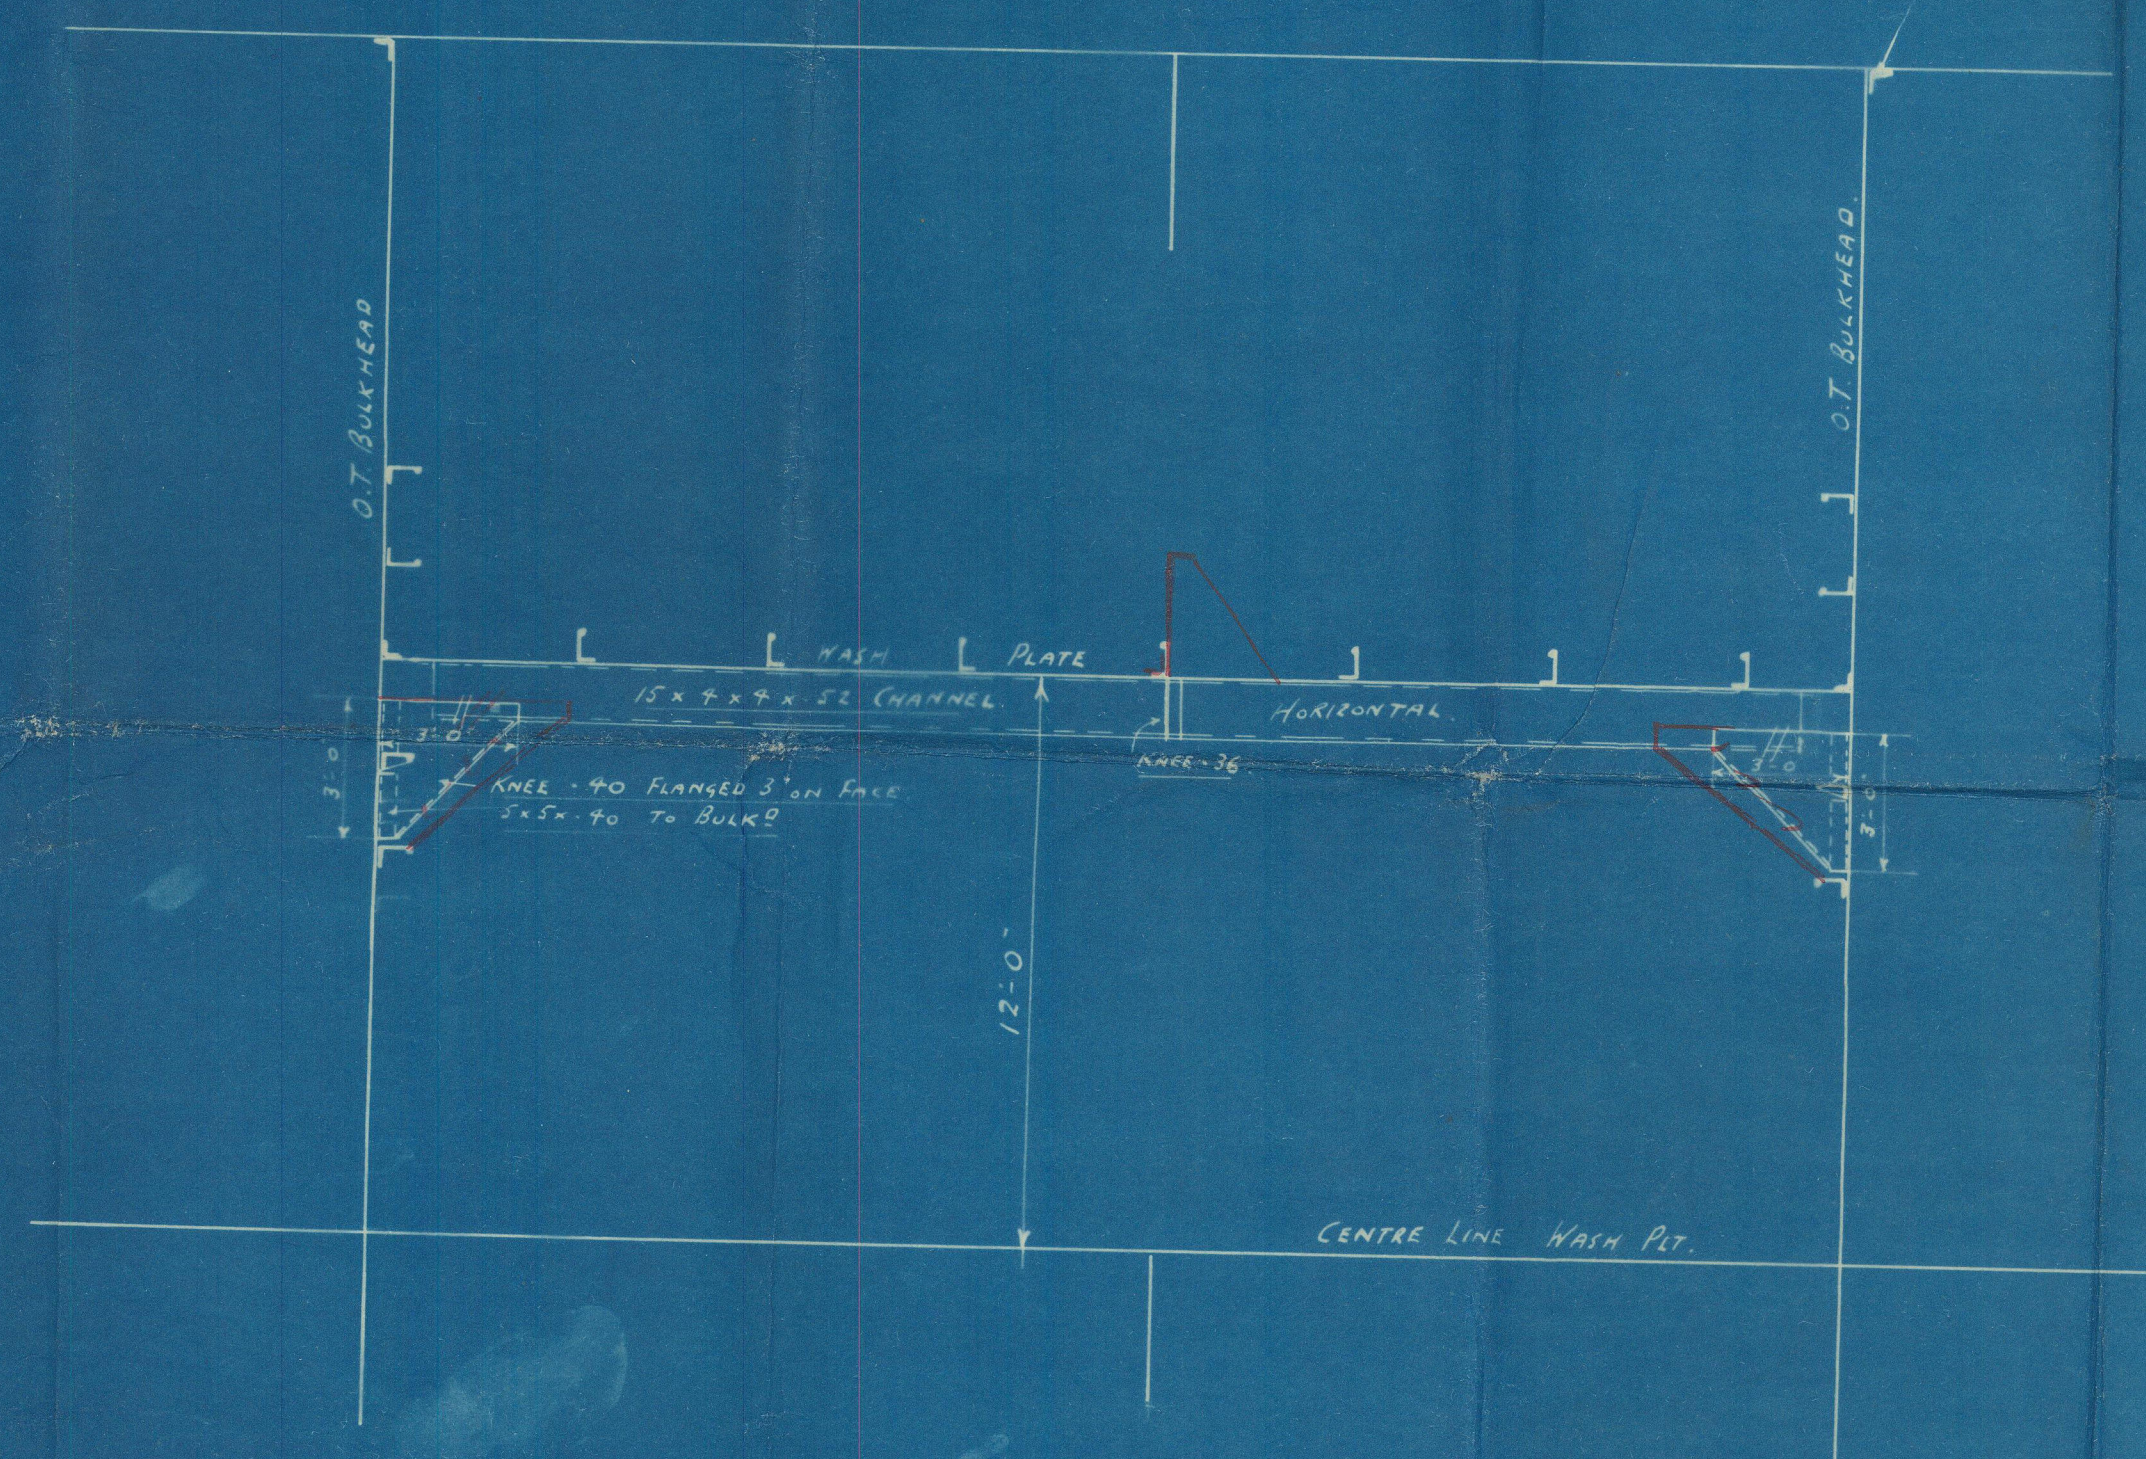

SECTION.

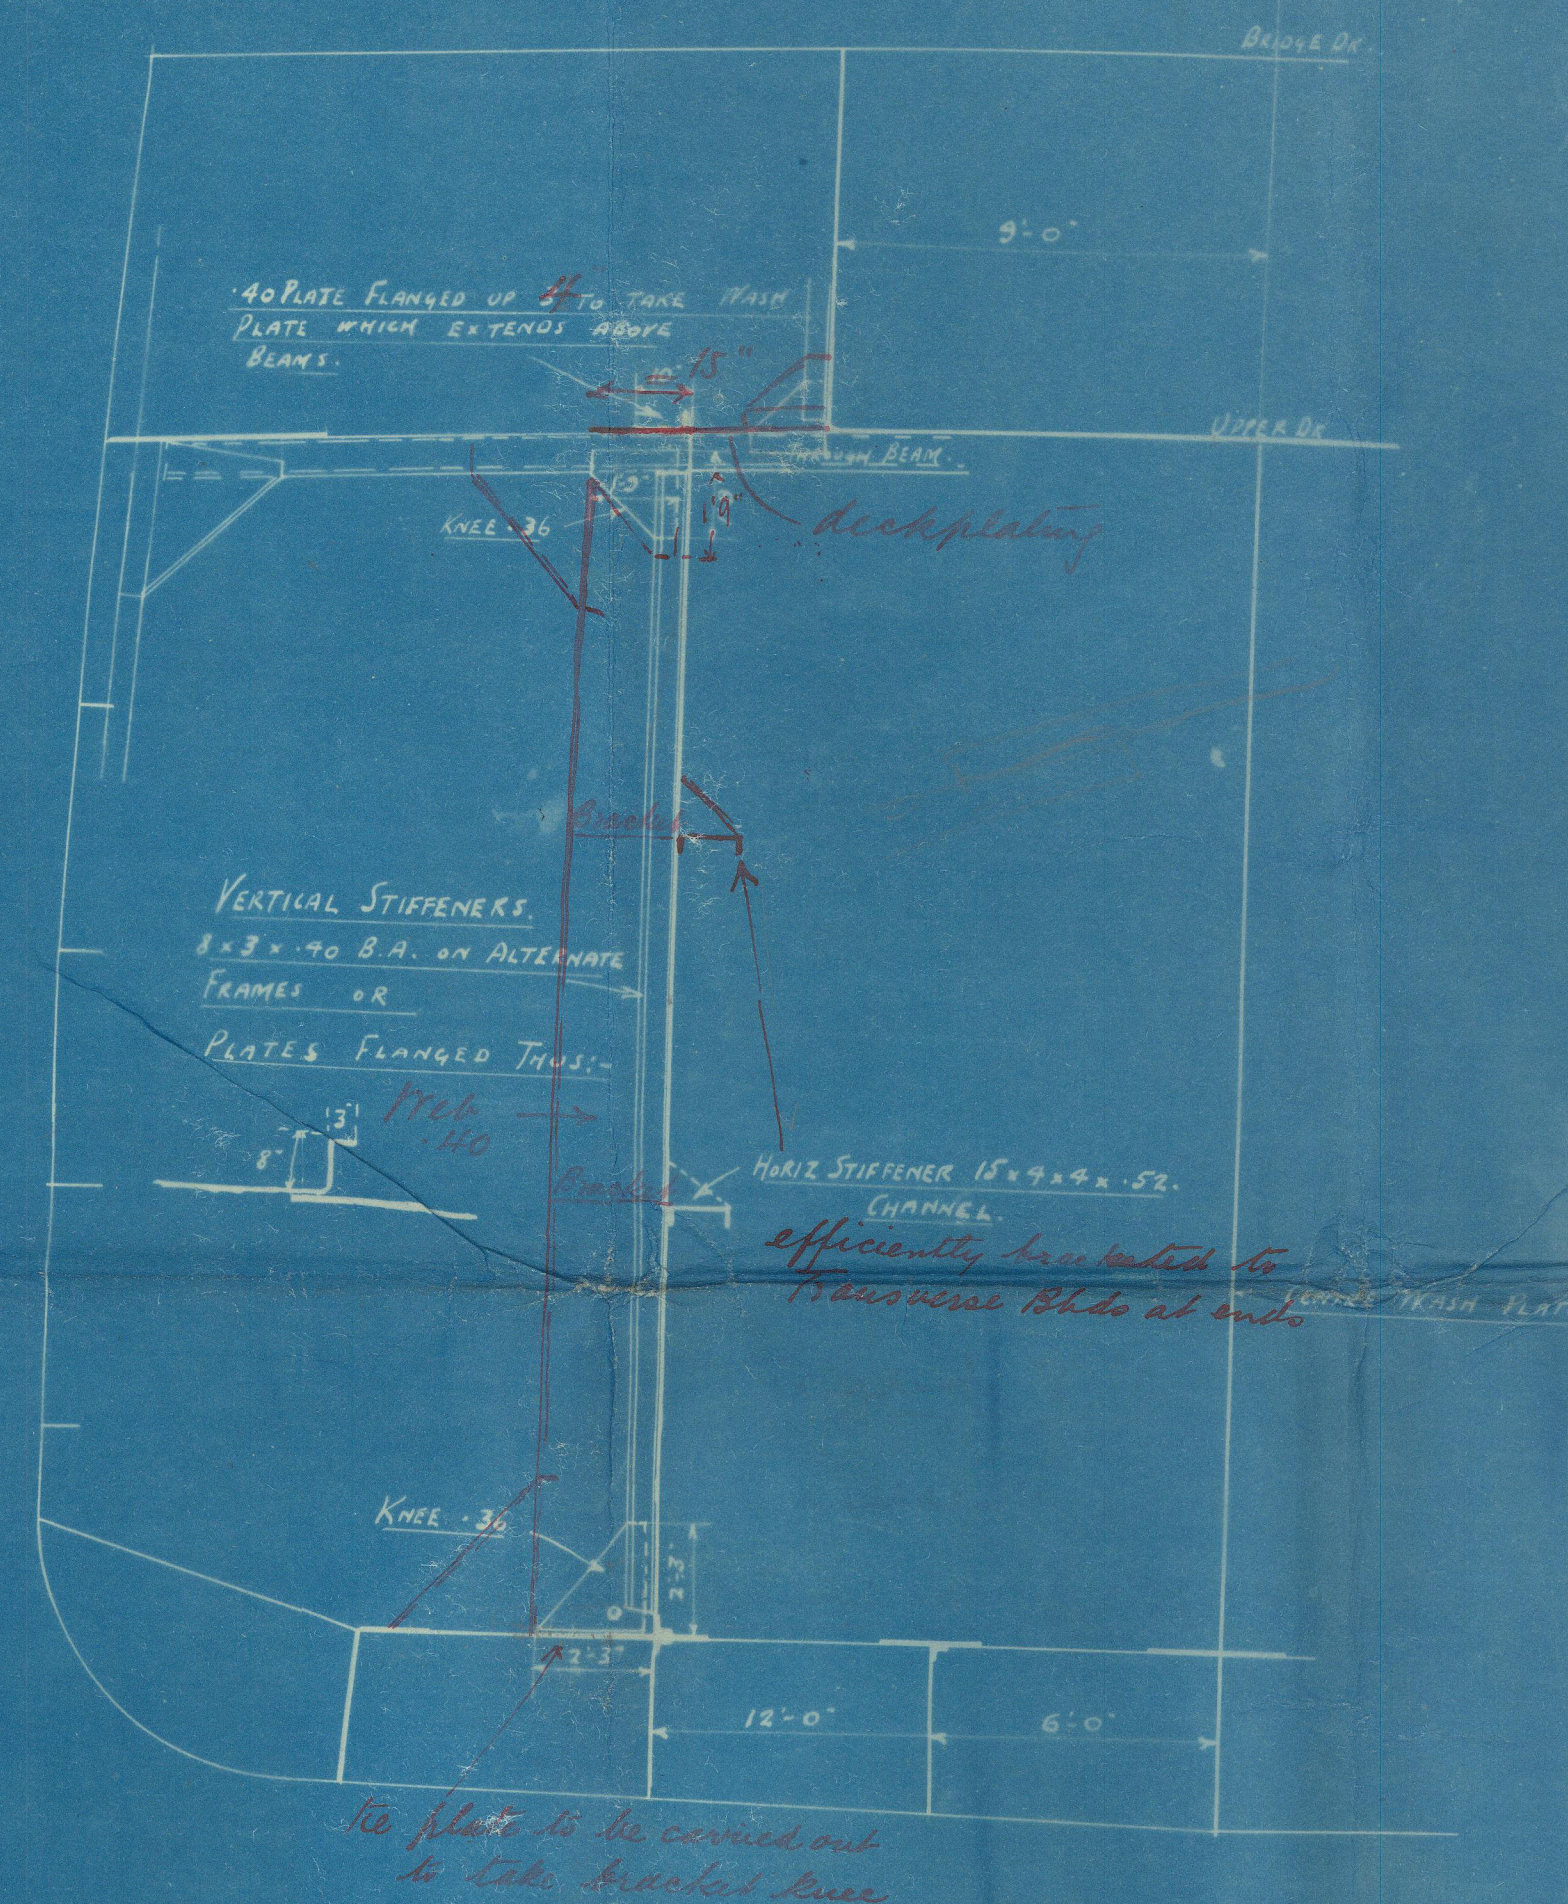



S/S HARPORT.

SIDE WASH PLATES IN NO 3 TANK FITTED FOR OIL FUEL.

SCALE 1/4" = 1 FOOT.

Plates 3/4" Dia 7' Dia apart

16.5.12

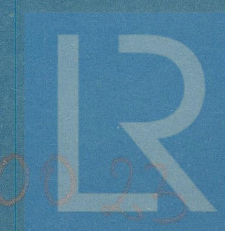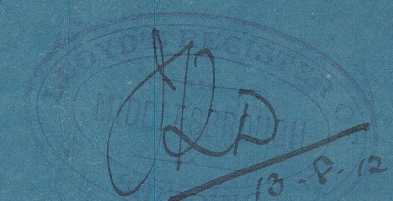





S. S. Harport

Wash. Bulkhead in

Oil Fuel Tank

Inst. Report 762

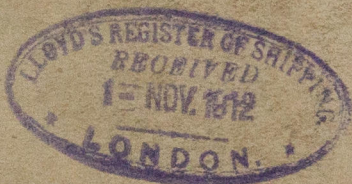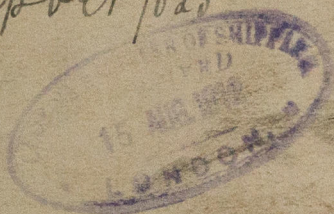

W/109-0023



© 2020

Lloyd's Register  
Foundation