
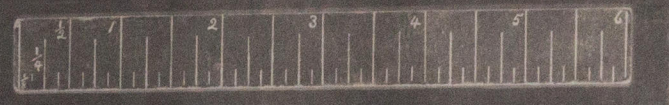




COAMING AT TONNAGE OPENING
 DECK PLATING 32"
 18' x 18' 6"
 17' x 13'

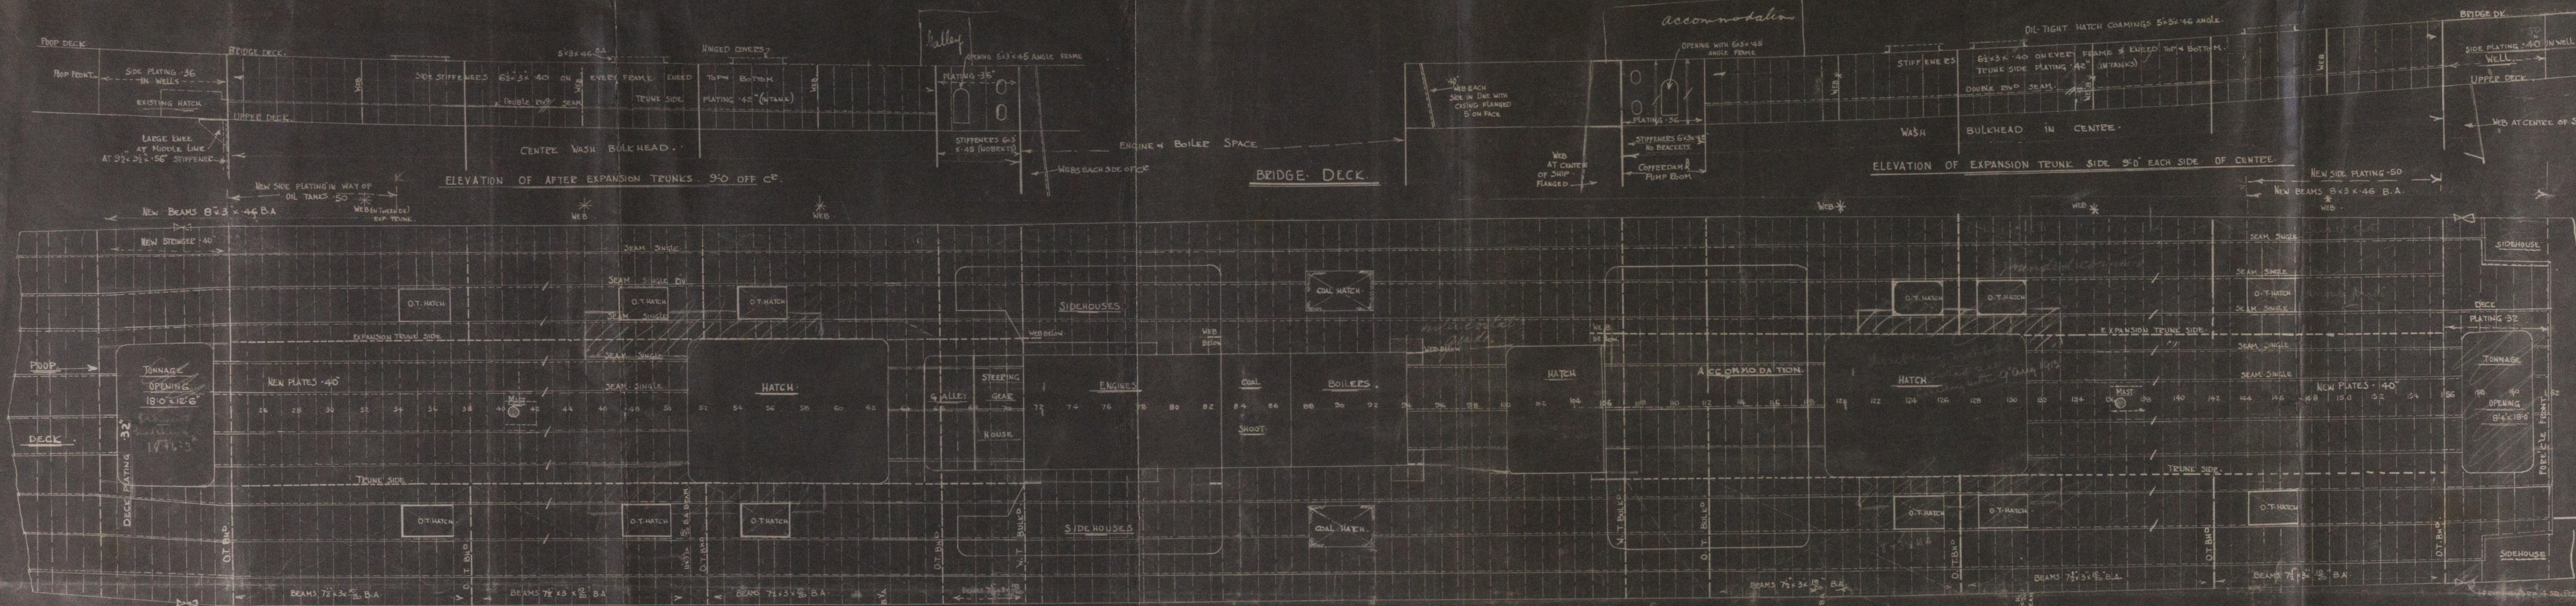

BRIDGE DECK (EXISTING)		BRIDGE DECK (NEW)	
SEAMS 3/4" DIA	4 1/2" DIA'S APART	SEAMS 3/4" DIA	3 1/2" DIA'S APART
LAPS	4"	LAPS	6"
BEAMS	7"	NEW BEAMS	6"
MAIN DECK (EXISTING) AT OIL TANK TOP		MAIN DECK NEW AT OIL TANK TOP	
SEAMS 3/4" DIA	4 1/2" DIA'S APART	SEAMS 3/4" DIA	3 1/2" DIA'S APART
LAPS	4"	LAPS	6"
BEAMS	7"	NEW BEAMS	6"

SKETCH SHOWING ARRANGEMENT OF DECK PLATING
 SCALE 1/8" = 1 FOOT

947
 20-6-1912

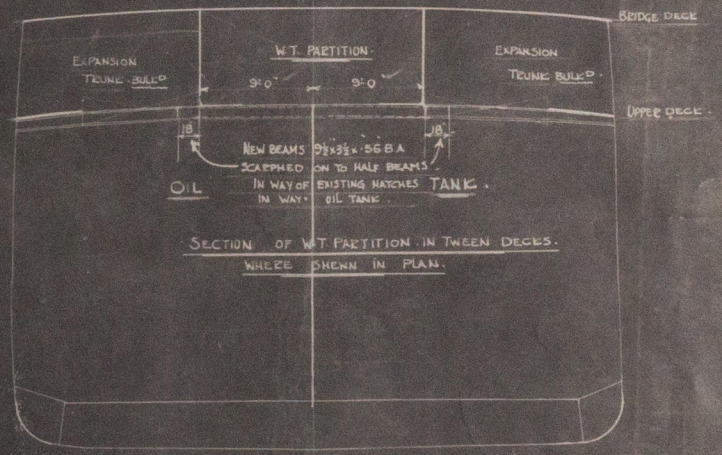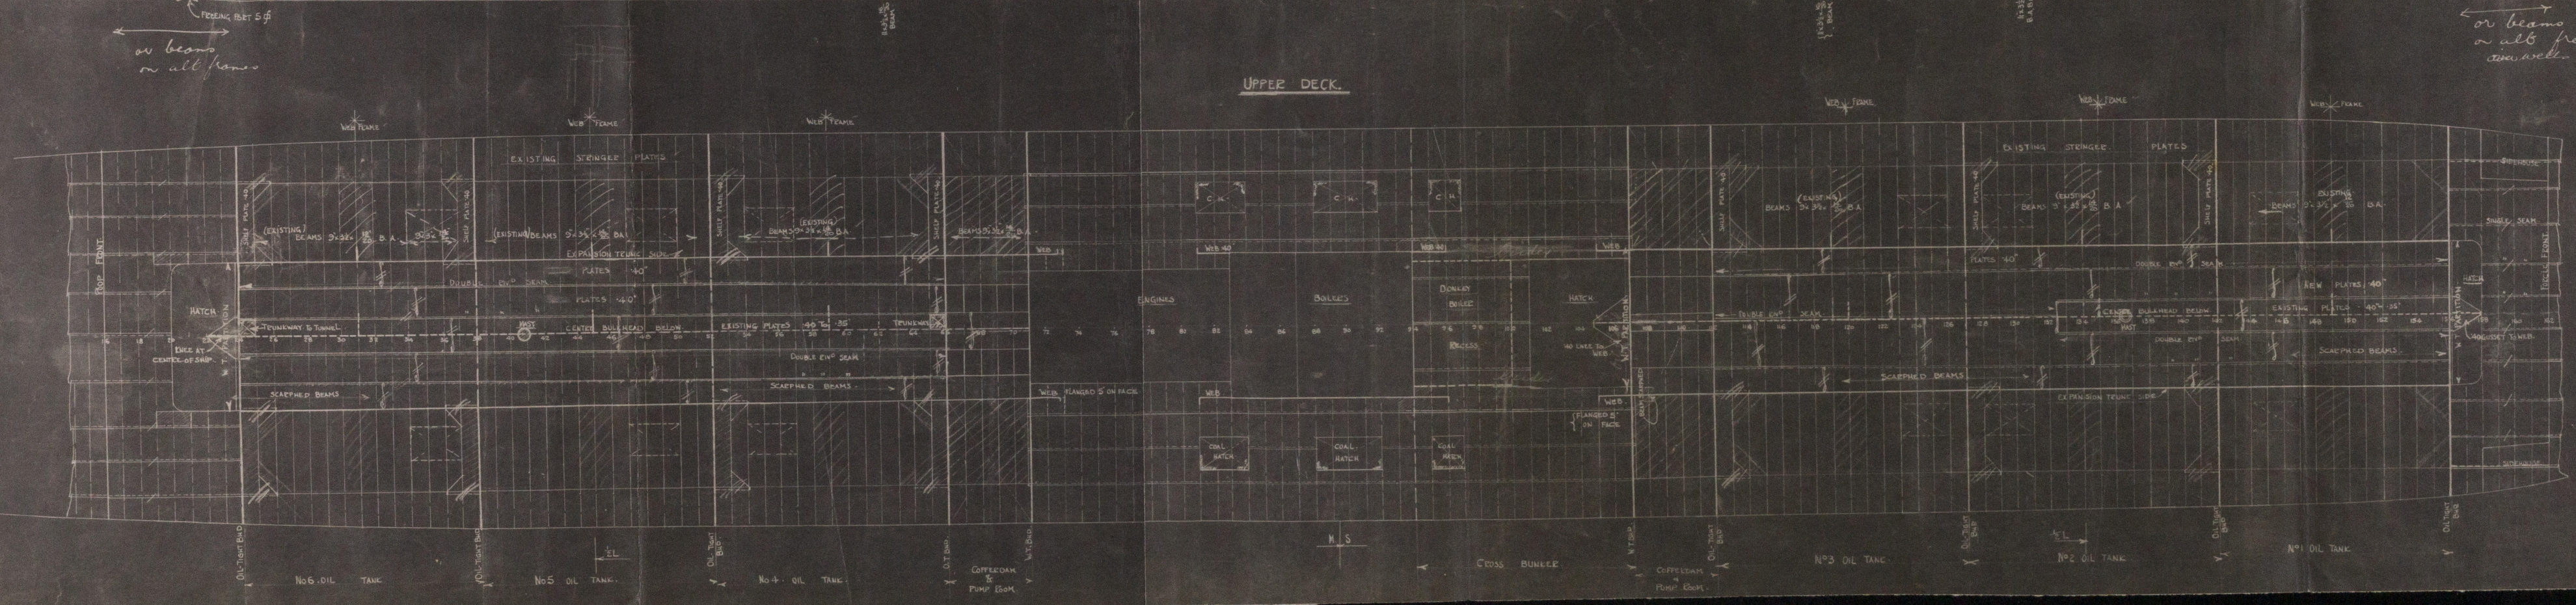

S/S "Olympic"
Arrangement of Deck
Plating

Gal. 4137.

W/109-0044



© 2020

Lloyd's Register
Foundation