


6.6.03

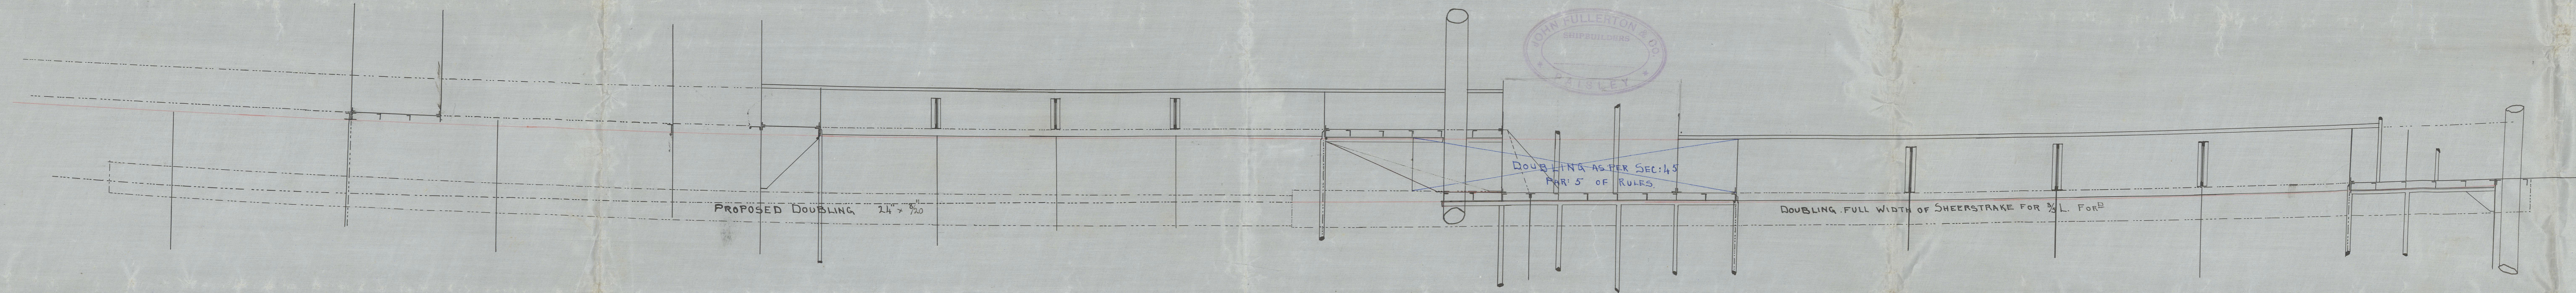

C.B.  
6.6.03.