


FREEBOARD PARTICULARS	
LENGTH ON LOAD LINE	413' 6"
DEPTH MOULDED	30' 8 1/2"
UNDER DECK TONNAGE COEFF. CORRECTED	74
SHEER FORWARD	92
AFT	42
MEAN SHEER	67
SHEER AT 1/8 LENGTH FROM FORWARD	54 1/2
AFT	24 1/2
MEAN SHEER AT 1/8 LENGTH	41
POOP	65' 5" 123' 6" ONLY
FILE	58' 6"

PROFILE
No 319 SS
TO CLASS 100 A.1 LLOYDS SPAR DECK RULE
SCALE 1/8" = 1 FOOT.

 

CHARLES CONNELL & CO. LTD.
SHIPBUILDERS AND
ENGINEERS
GLASGOW

Foundation

C. Cornwell & Co


N^o 319 1/2 S CADIZ

Profile

Glasgow ref. No 26 353

Copy

88 Barcelona

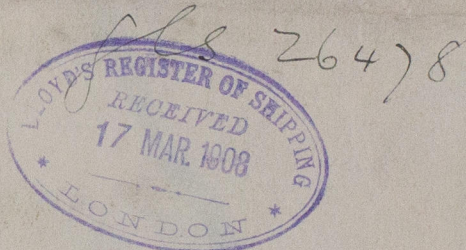

RETAIN



© 2020

Lloyd's Register
Foundation

W1094-2086