

28.6.19  
11.8.19 (N°398)

# N°400. 398 MIDSHIP SECTION

MOULDED DIMENSIONS 406'0" DP x 53'6" x 30'6" 38'6" TO SHELTER DECK

SCALE 1/2" = 1 FOOT

MILLAR'S SYSTEM OF FRAMING (PATENTED)


TO CLASS 100 A1 AT LLOYDS

INCREASE OF SCANTLING OVER CLASSIFICATION REQUIREMENTS REQUESTED BY  
OWNERS SHOWN THUS:

FLOORS & WT DIVISIONS FOR 3 SPACES UNDER BOILERS INCREASED	1/80
INTERCOSTALS FOR 3 SPACES UNDER BOILERS	1/80
TANK TOP PLATING UNDER BOILERS	1/80
BRIDGE DECK PLATING BETWEEN BOILER CASING AND SALOON HOUSE	1/80

SECTION IN WAY OF ORDINARY FRAMES SPACED 3'0" APART

SECTION IN WAY OF REINFORCED FRAMES SPACED 12'0" APART

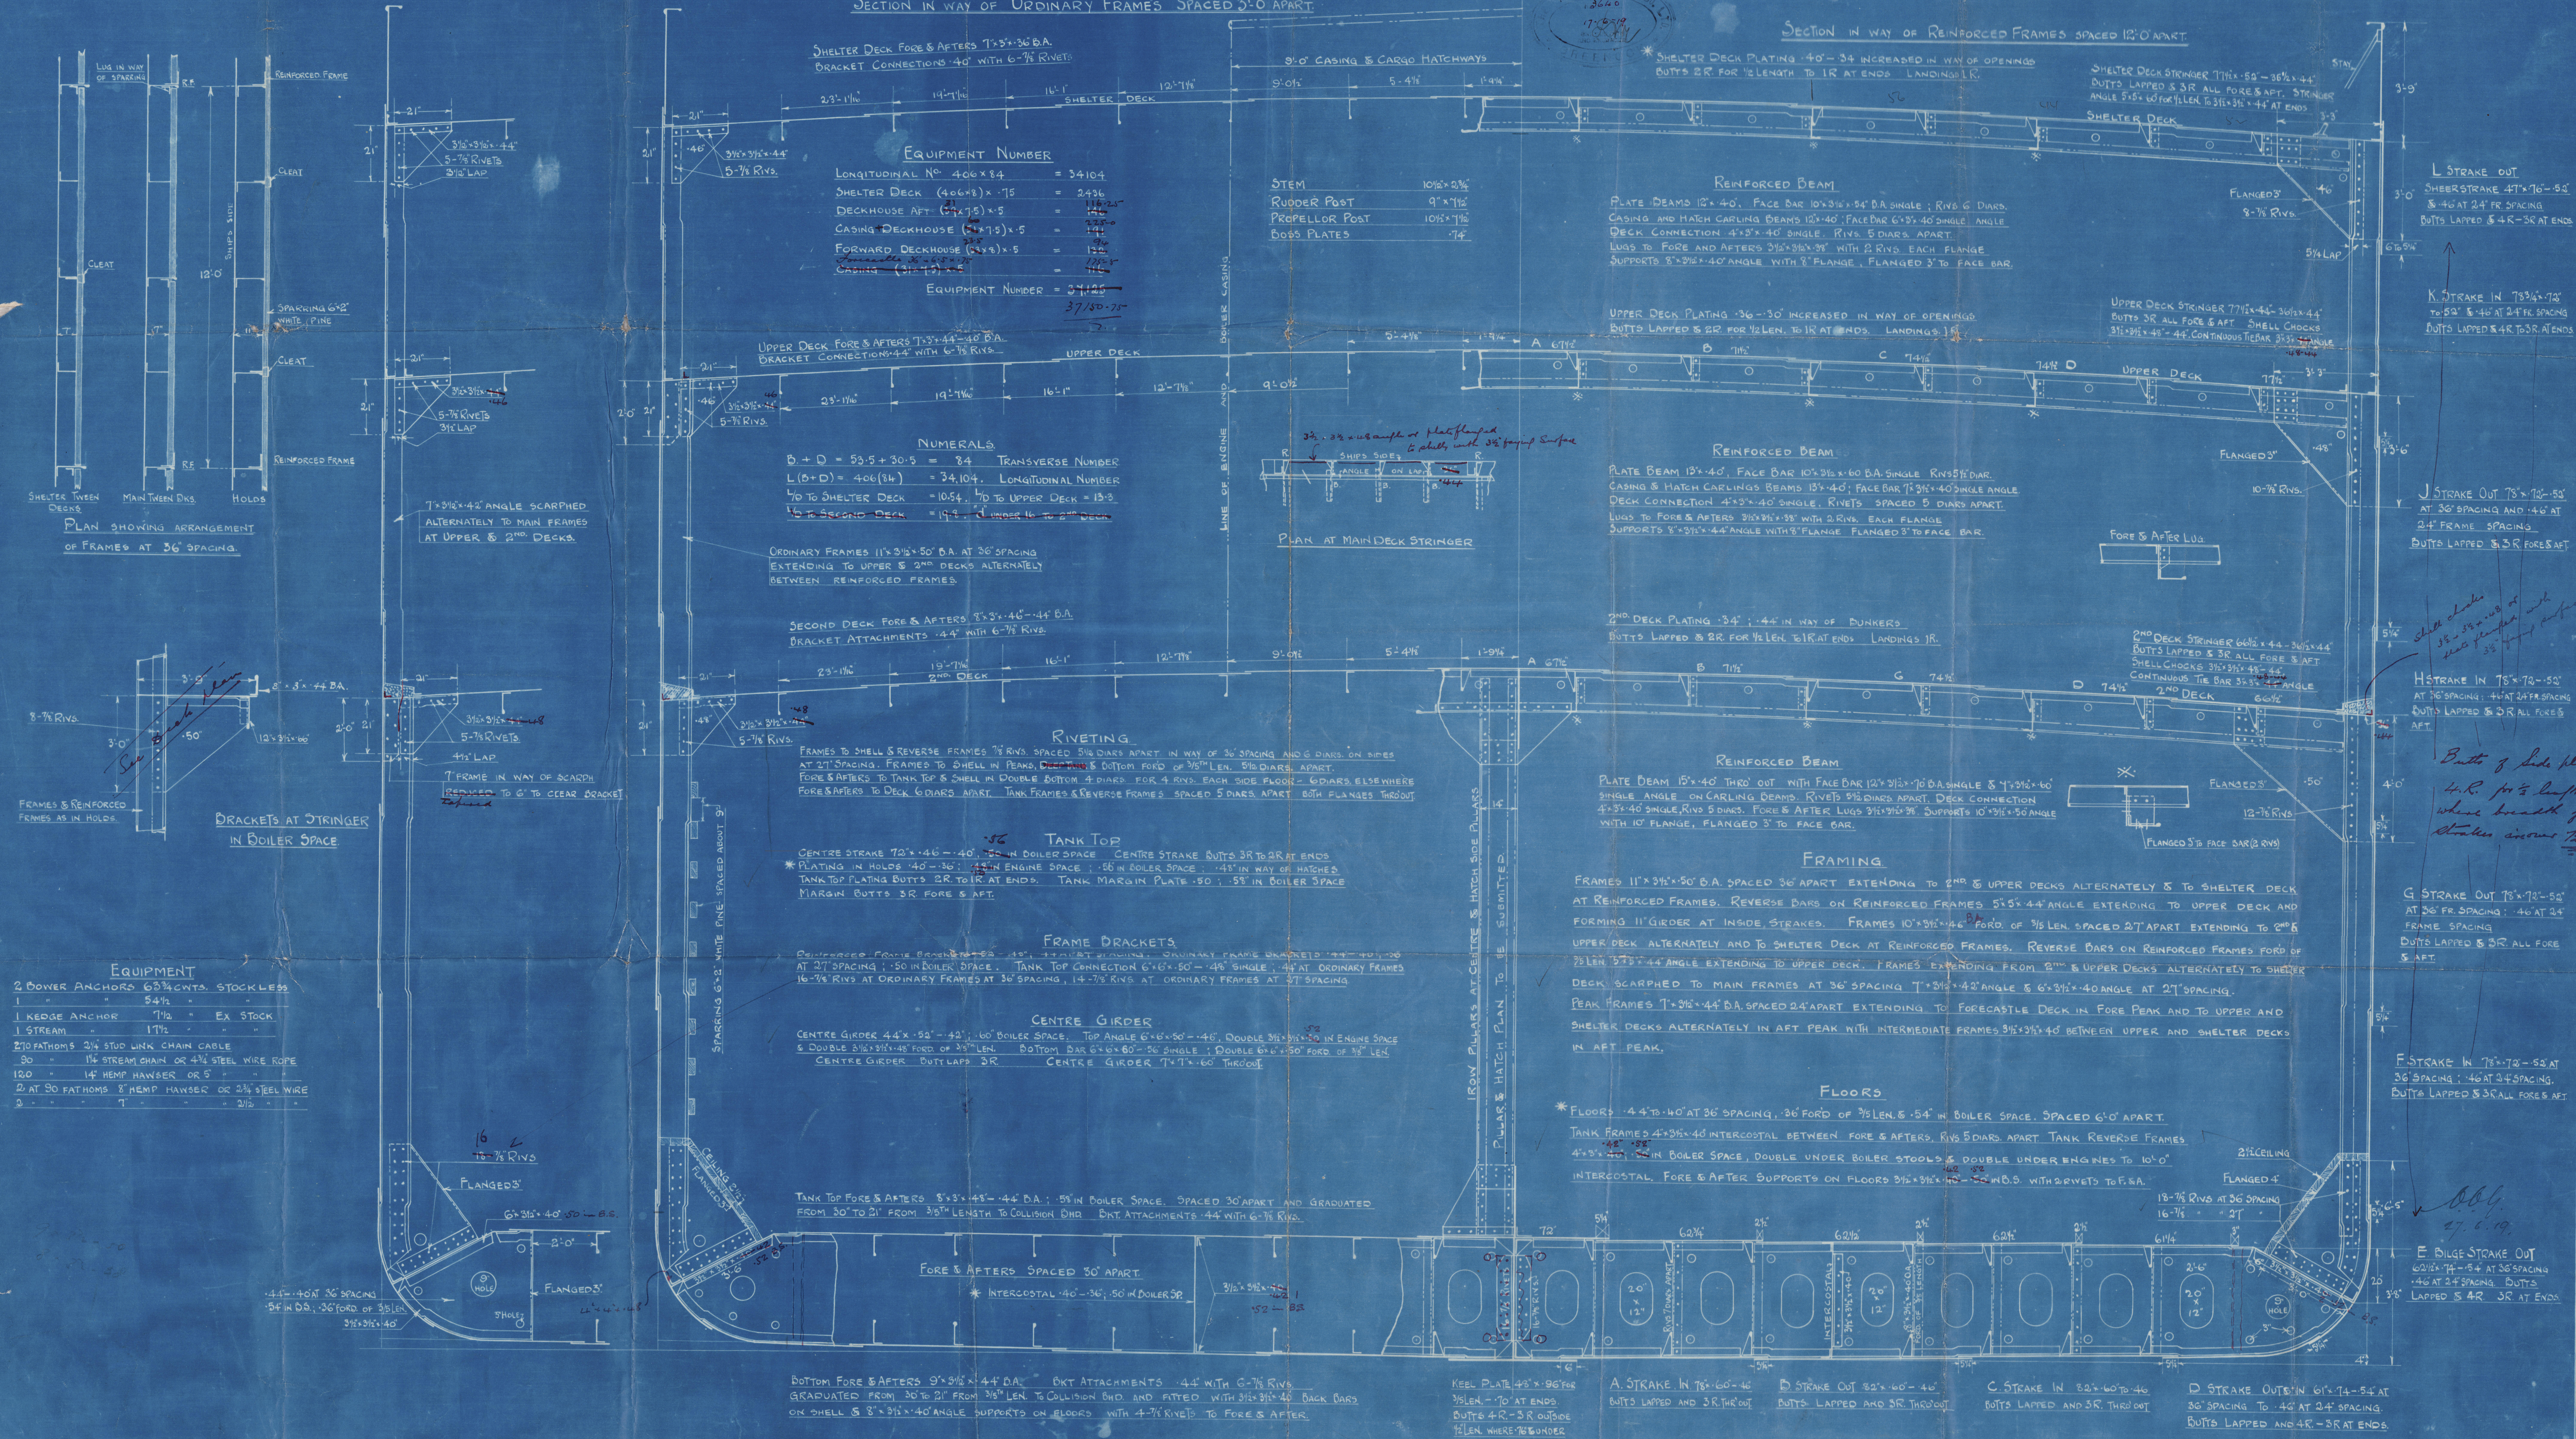

MIDSHIP THICKNESS MAINTAINED ON A.B.C. STRAKES TO COLLISION B'D.



To Lloyd's

17726

RANDFONTEIN

EX

The Greenock Stey "bok"

No 400 ~~1398~~

Madship Section

W1094-0142

No 400 S.S. "Staur"

GRK Rept No 17726



© 2020

Lloyd's Register  
Foundation

W1094-0142