


Nº 312 - 317 STERN TUBE & SHAFT

13/4/17

SCALE 1 1/2" = 1 FOOT.

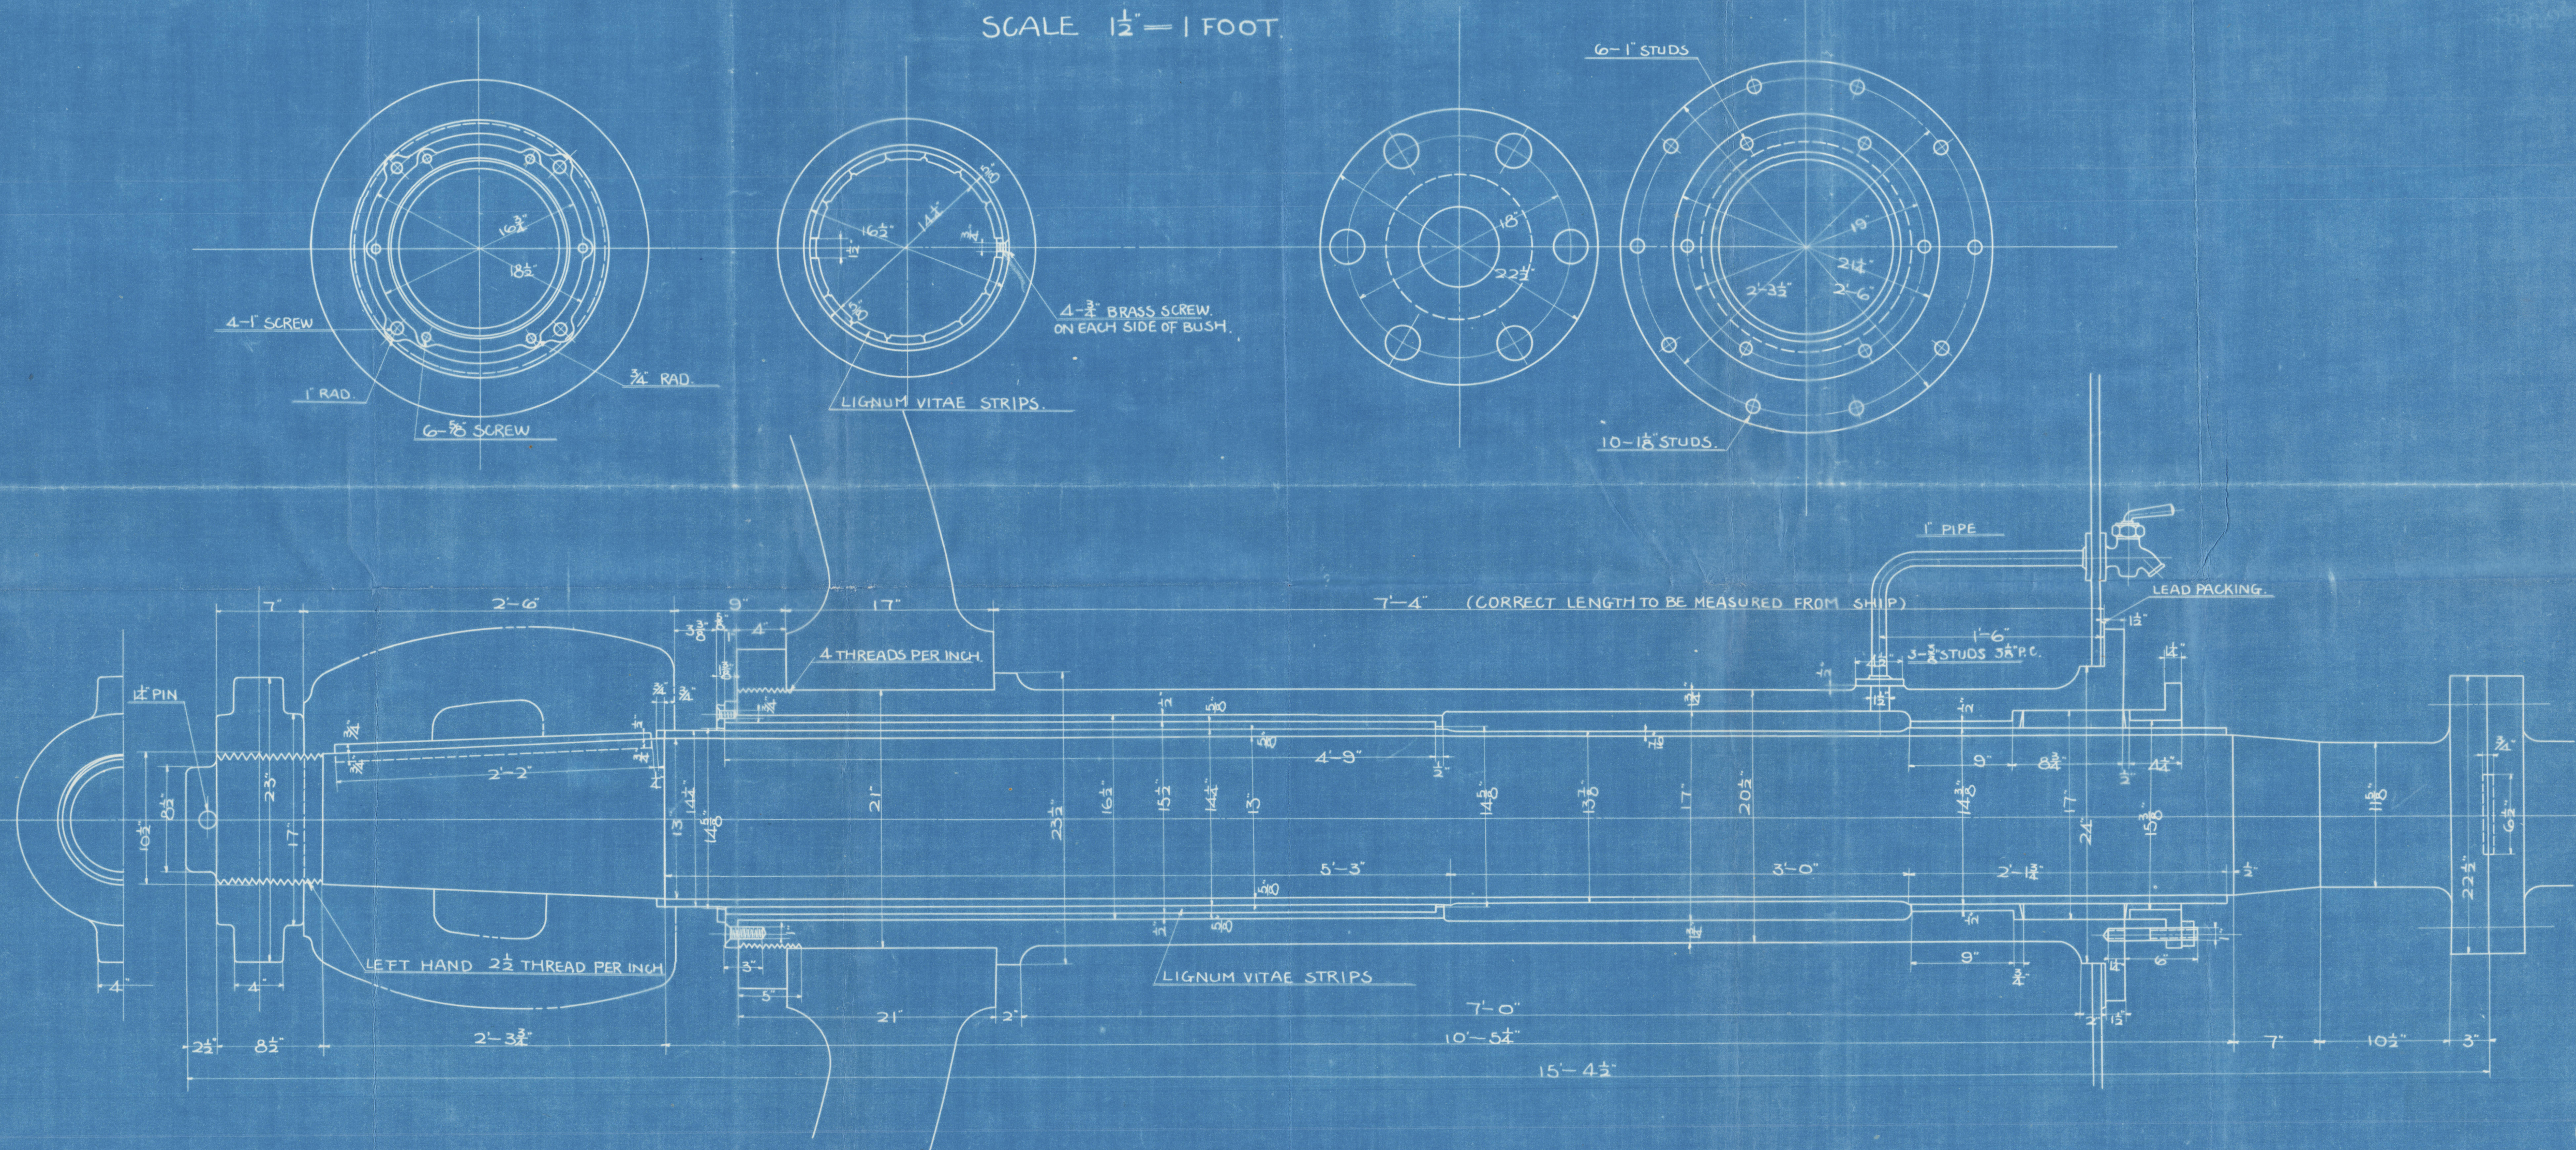

PC
13-4-17

~~Gen Box 2248~~

Stem Tube & Shaft.

"Shinryu Maru"
yKa 2398.

RETAI
RETAI



© 2020

Lloyd's Register
Foundation

W1096-0114