

SURVEYOR TO LLOYD'S REGISTER,
CLEVELAND, OHIO.

The American Shipbuilding Co
Main Boilers
W. 180 H.

Ship Nos.

467 - Cut 90 - 270 H. - 25.8.17 - WL.

468, Cut 94 - 270 H. 13.10.17. WL.

469, Cut 98. 270 H. 13.11.17. WL

470 Cut 105. 270 H. 13.12.17. WL.
(2nd Bl. tested by CFC. 13.12.17)

725, No 100. 270 H. WL. 21.11.17

726 No 106. 270 H. WL. 19.11.17

727 No 107. 270 H. WL. 31.12.17

1181. No 108 270 H. WL. 10.1.18

728 No 110. 270 H. WL. 2.2.18

729 112. 270 H. WL. CFC. 7.2.18

1182. No 109. 270 H. WL. 7.2.18.

730 119. 270 H. 9.4.18. WL


731 - 122. 270 H. 19.4.18. WL.

732 - 129. 270 H. 7.6.18. WL.

733 - 131. 270 H. 15.6.18. WL.

see amended plan

Christine Copy

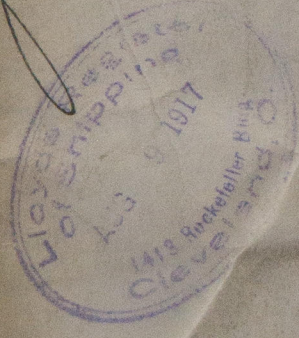

SURVEYOR TO LLOYD'S REGISTER,
CLEVELAND, OHIO.

SURVEYOR TO LLOYD'S REGISTER,
CLEVELAND, OHIO.



© 2020

Lloyd's Register
Foundation