



AUXILIARY ARCTIC SCHOONER "BAYMAUD".

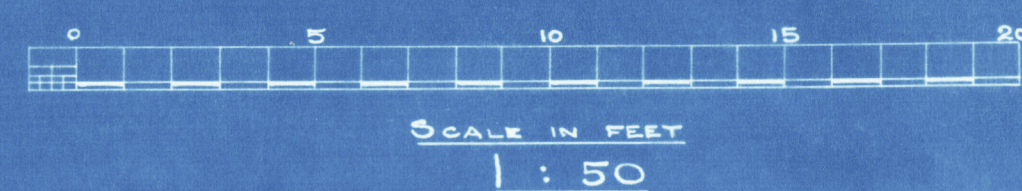

LENGTH O.A.	118.0 FEET
LENGTH B.P.	106.8 FEET
BEAM AT DECK ^(OVER H. BUNK)	40.0 "
DEPTH ^(TOP OF DECK AT SIDE TO BOTTOM OF KEEL)	18.2 "
DEPTH OF HOLD	15.3 "
TONNAGE	UNDER DECK 338.58
	CROSS 398.48
	NET REGISTER 29.12

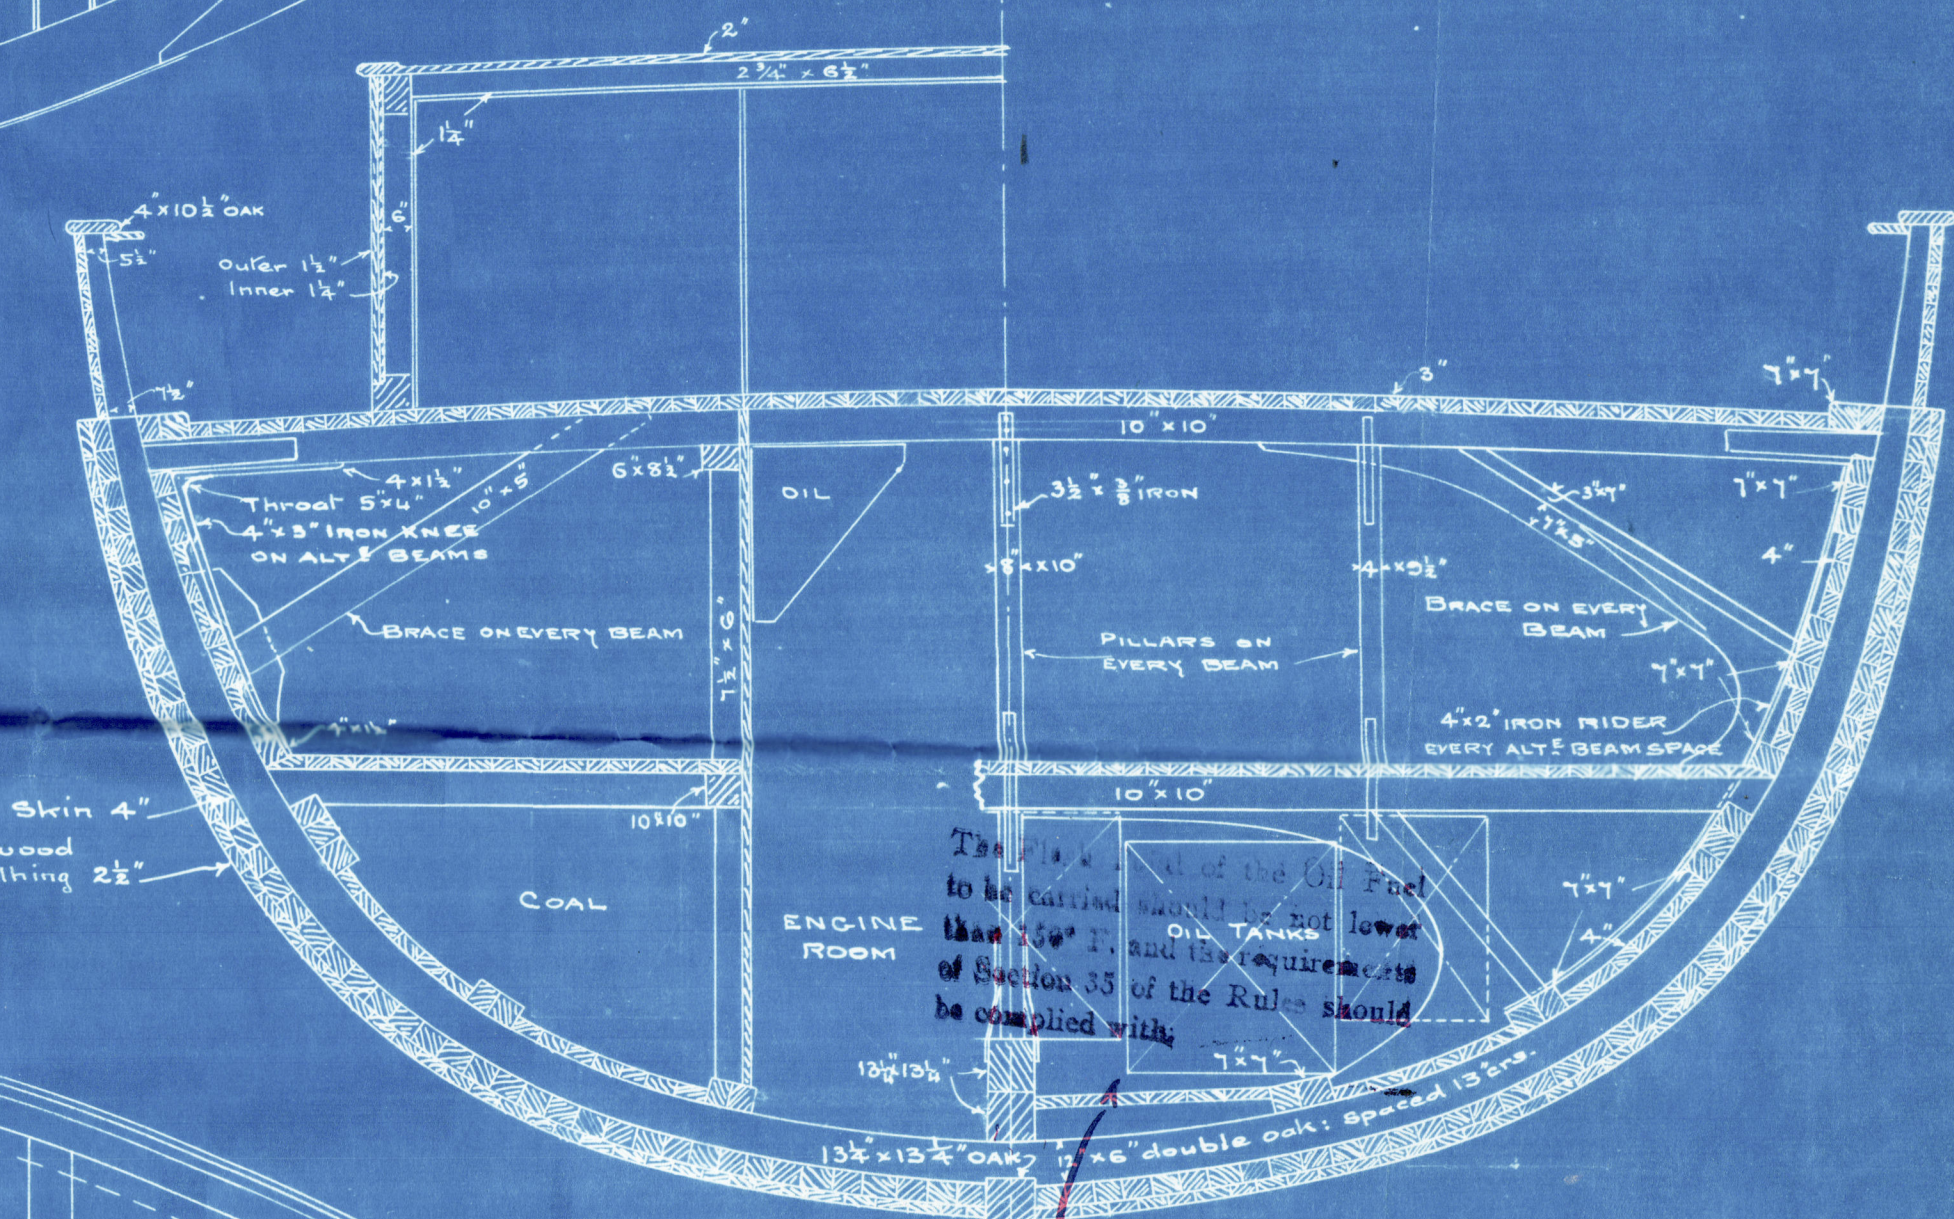

The stowage of the Oil Fuel to be carried should be not lower than 150° F. and the requirements of Section 35 of the Rules should be complied with.

MIDSHIP SECTION. Life trays (or other suitable arrangement) to be fitted under o/s seats to hold lifebags to prevent flotation.



Wood Aux. Schooner
"Baynard"

Drawn by: T. Halliday
Naval Architect
Vancouver B.C.
 Date March 22, 26

Profile & Midship Section

RETAIN

W1097-0227



© 2021

Lloyd's Register
Foundation