

N<sup>o</sup> 540  
~~N<sup>o</sup> 539-40~~

# MIDSHIP SECTION.

DIMENSIONS 141-2 BP x 23-0 EX x 13-0 M<sup>LD</sup>  
 STEEL TO CLASS 100 A FOR FISHING PURPOSES  
 SCALE 2=1 FOOT.




NUMERALS  
 DEPTH = 13.5  
 BREADTH = 14.3  
 GIRTH = 21.25  
 46.18 1<sup>st</sup> N  
 140.46 LENGTH  
 277.08  
 18472  
 184720  
 4618  
 6486422=2 N

$\frac{L}{B} = 6.14$   
 $\frac{L}{D} = 10.40$

## EQUIPMENT

ONE ANCHOR 6 1/4 CWT EX STOCK  
 3/4  
 3/4

120 FATHOMS 1 1/2 CABLE  
 60 6 HAWSER  
 60 5 WARP

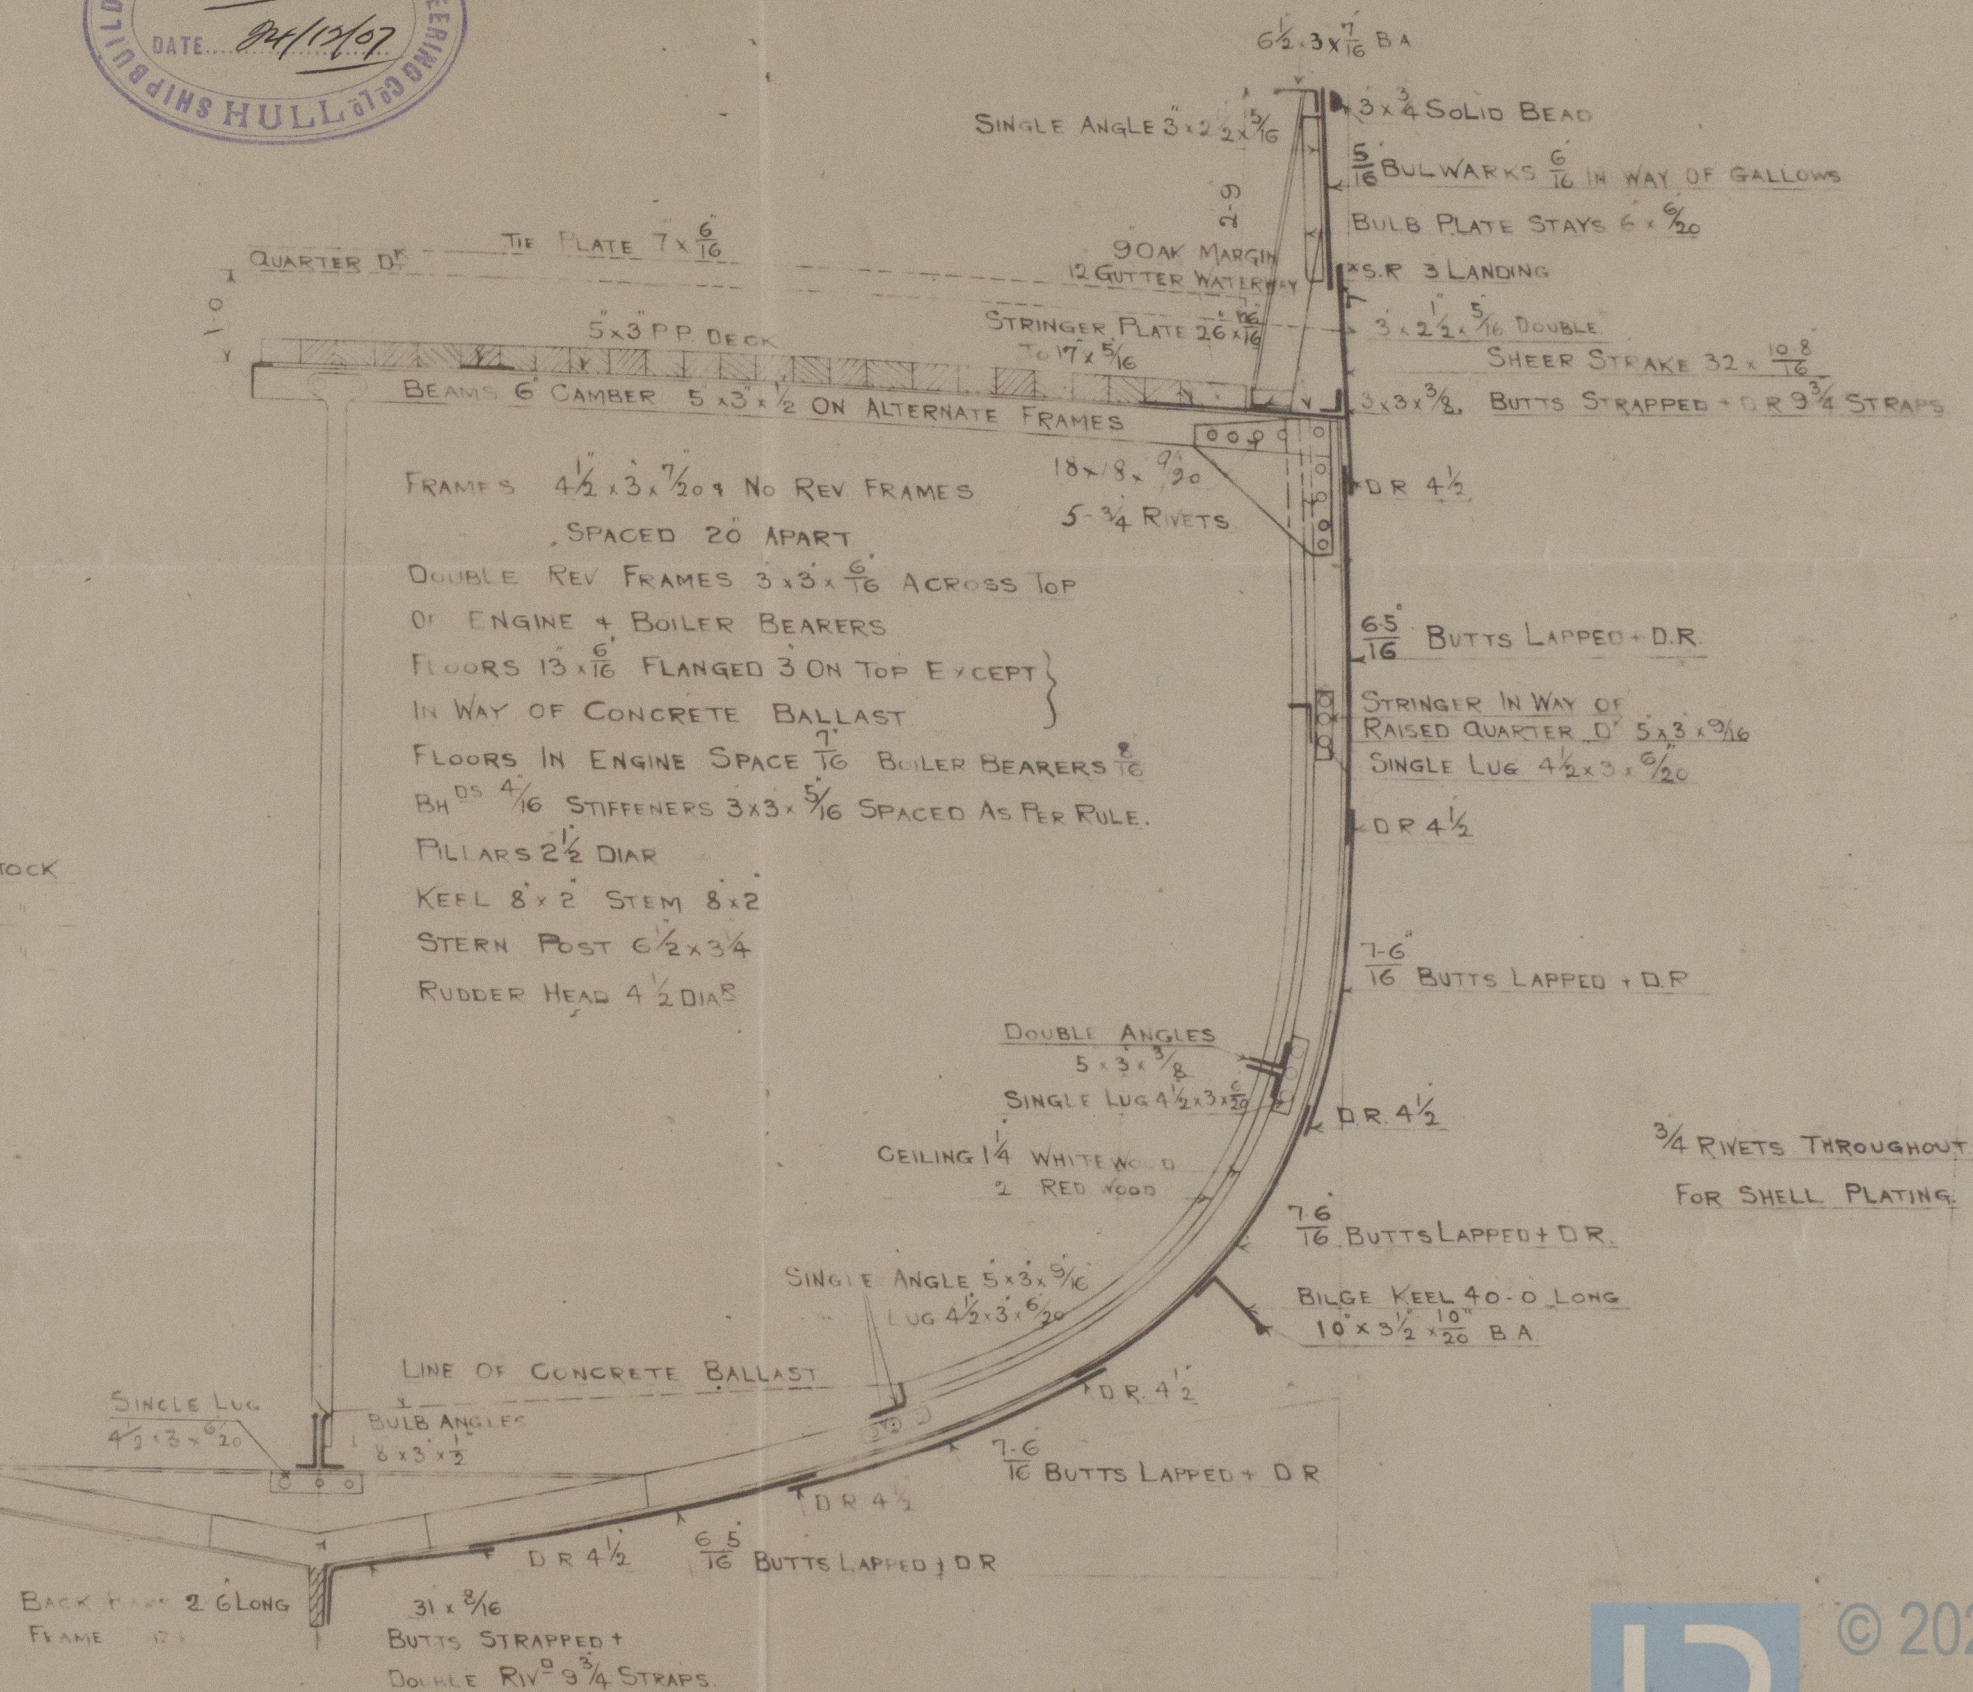

© 2021

Lloyd's Register  
 Foundation

W1011 0246