


SEIN 58
ALTERED PLAN
OF
BRIDGE AFT BULKHEAD
SCALE 1" = 10'



MATSUO	
DOCKYARD & ENGINE WORKS	
NAGASAKI	
SHEET NO.	
DRAWN BY	
TRACED BY	
CHECKED BY	
DATE	21-3-18.

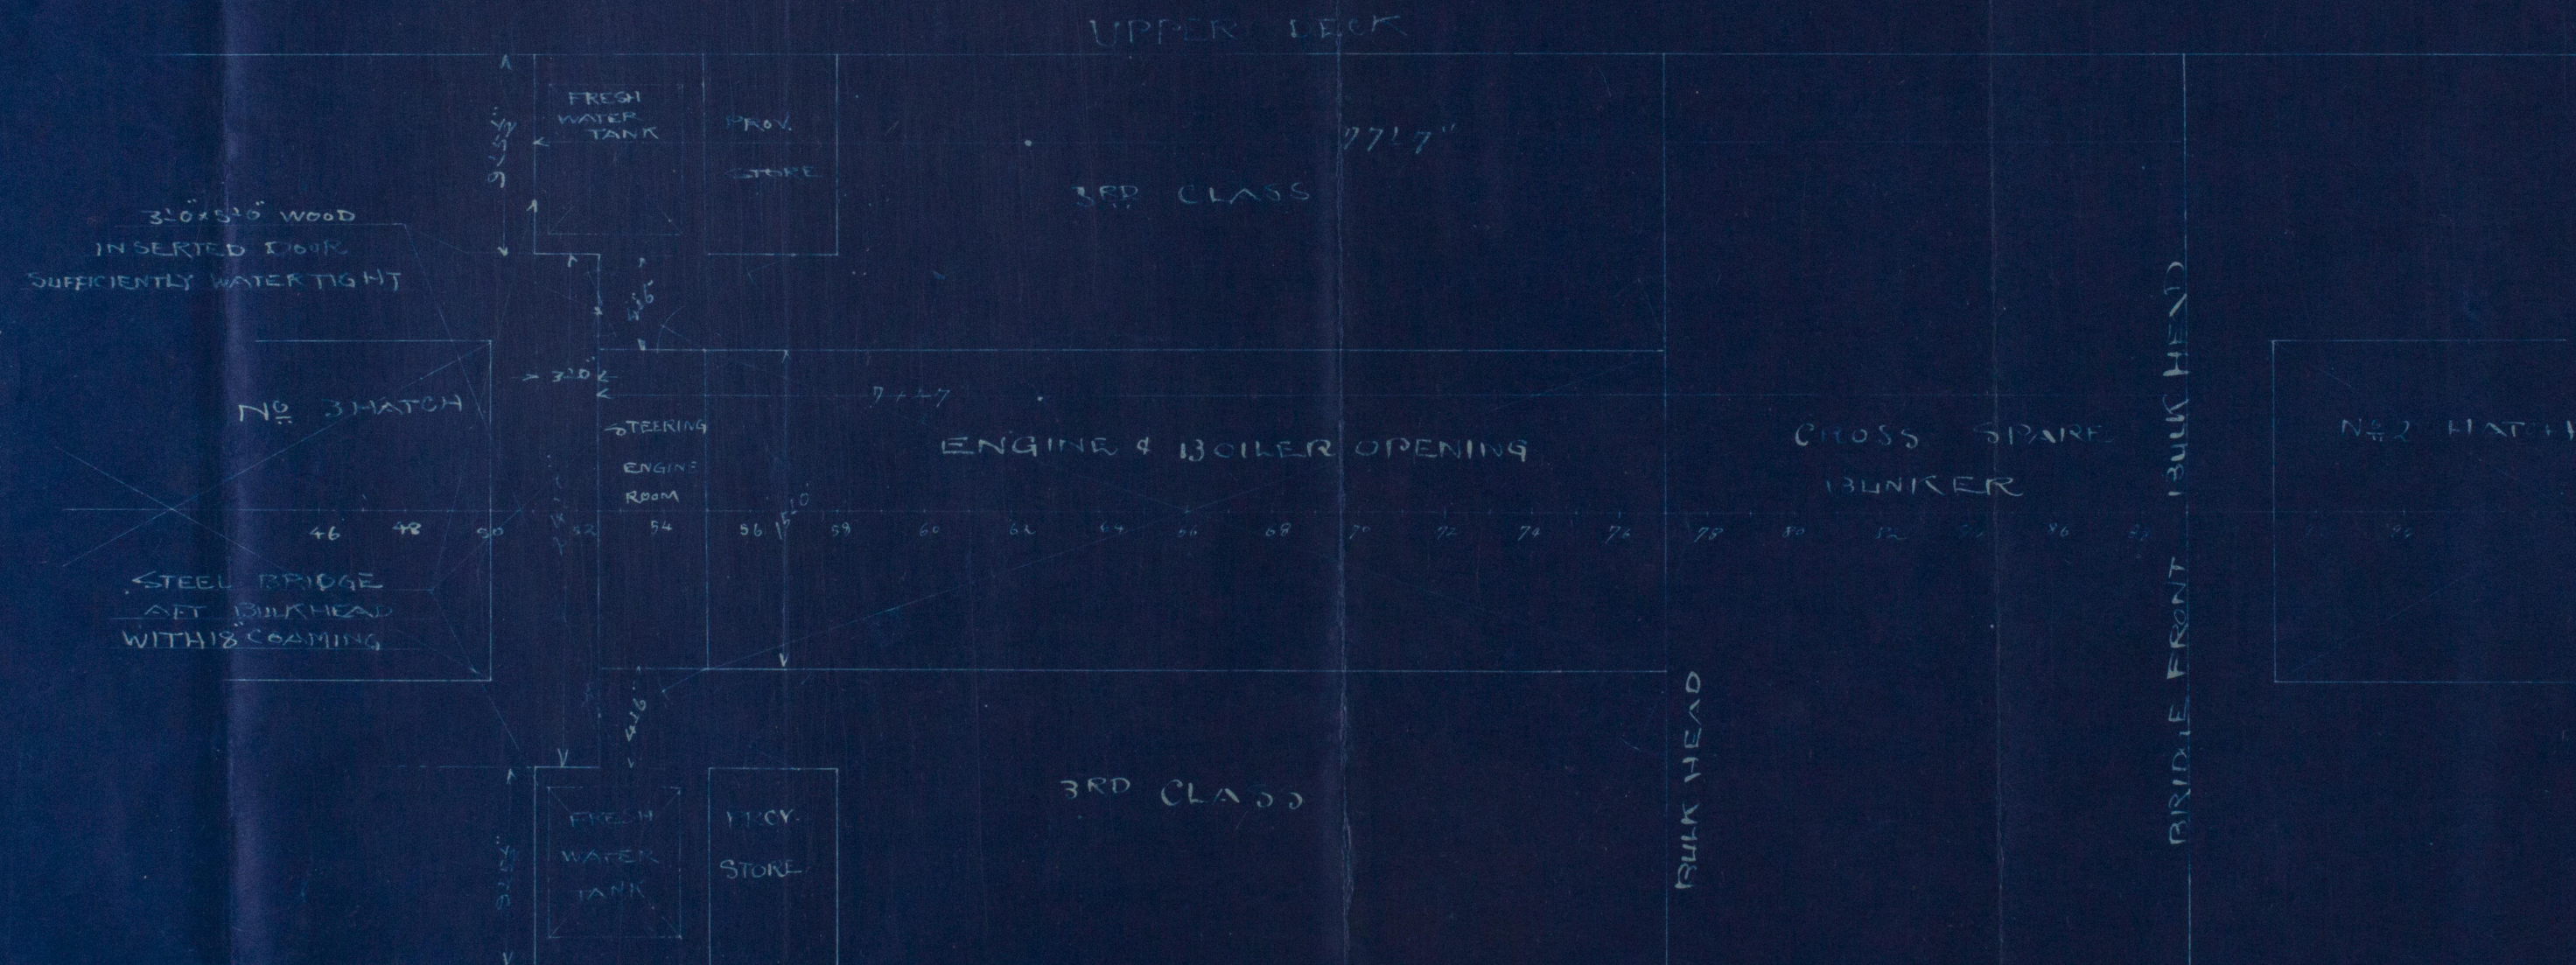

© 2020
Lloyd's Register
Foundation

Ok plan Alterations

N^o 58

S. S. Luma Main

Nagasaki Ref N^o 1174

W1099-0058



© 2020

Lloyd's Register
Foundation