
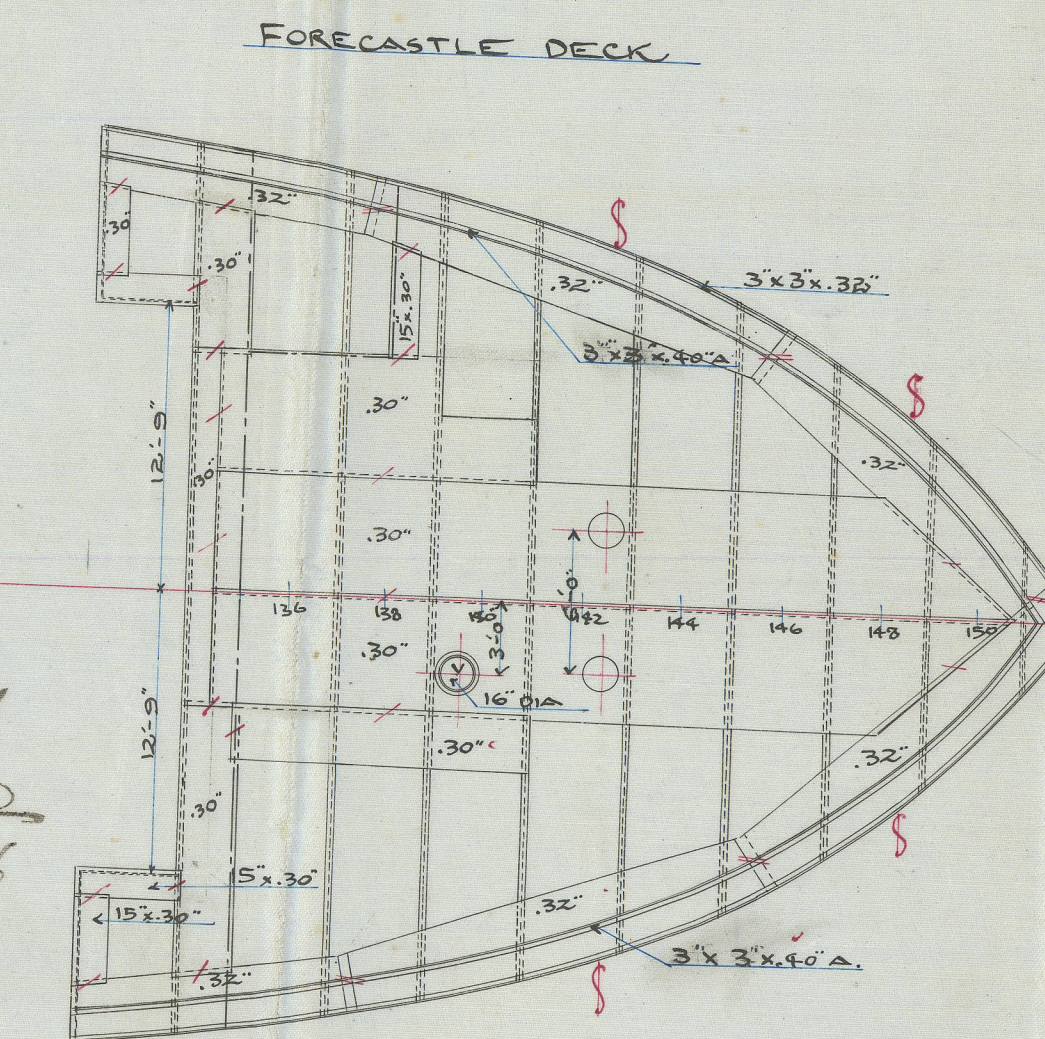
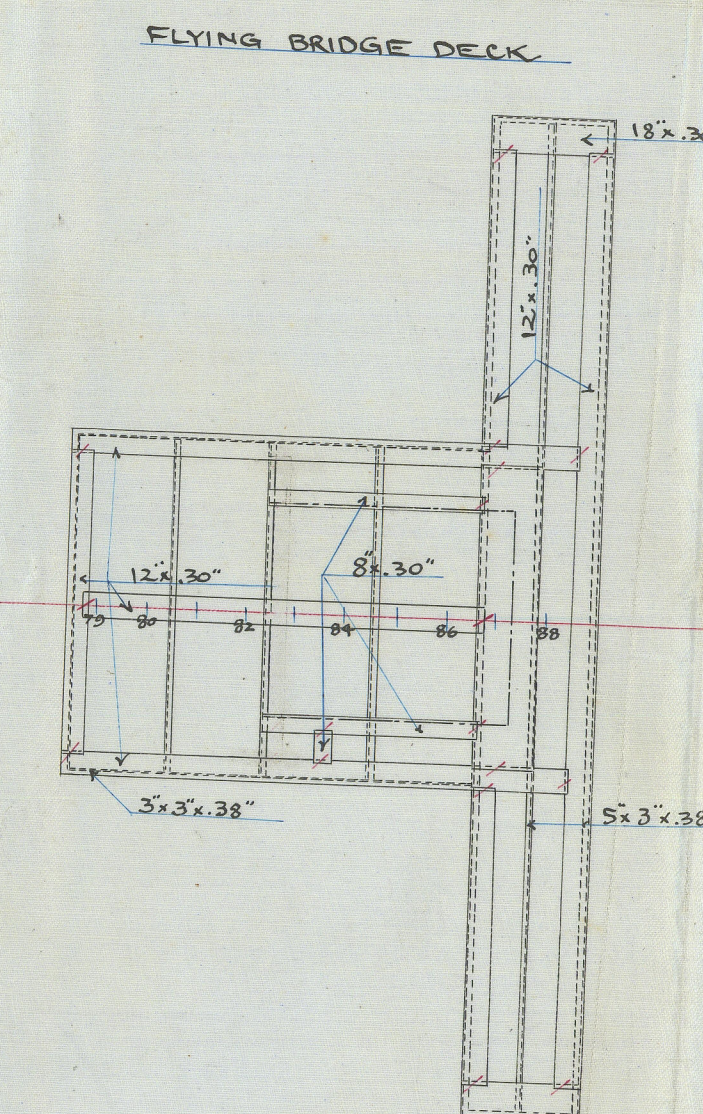
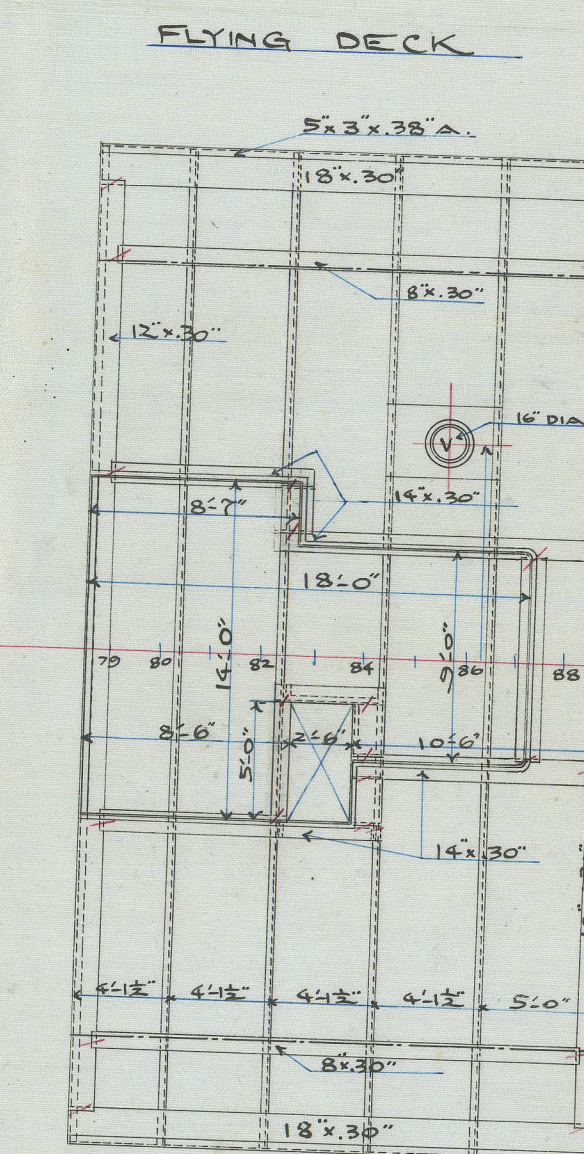
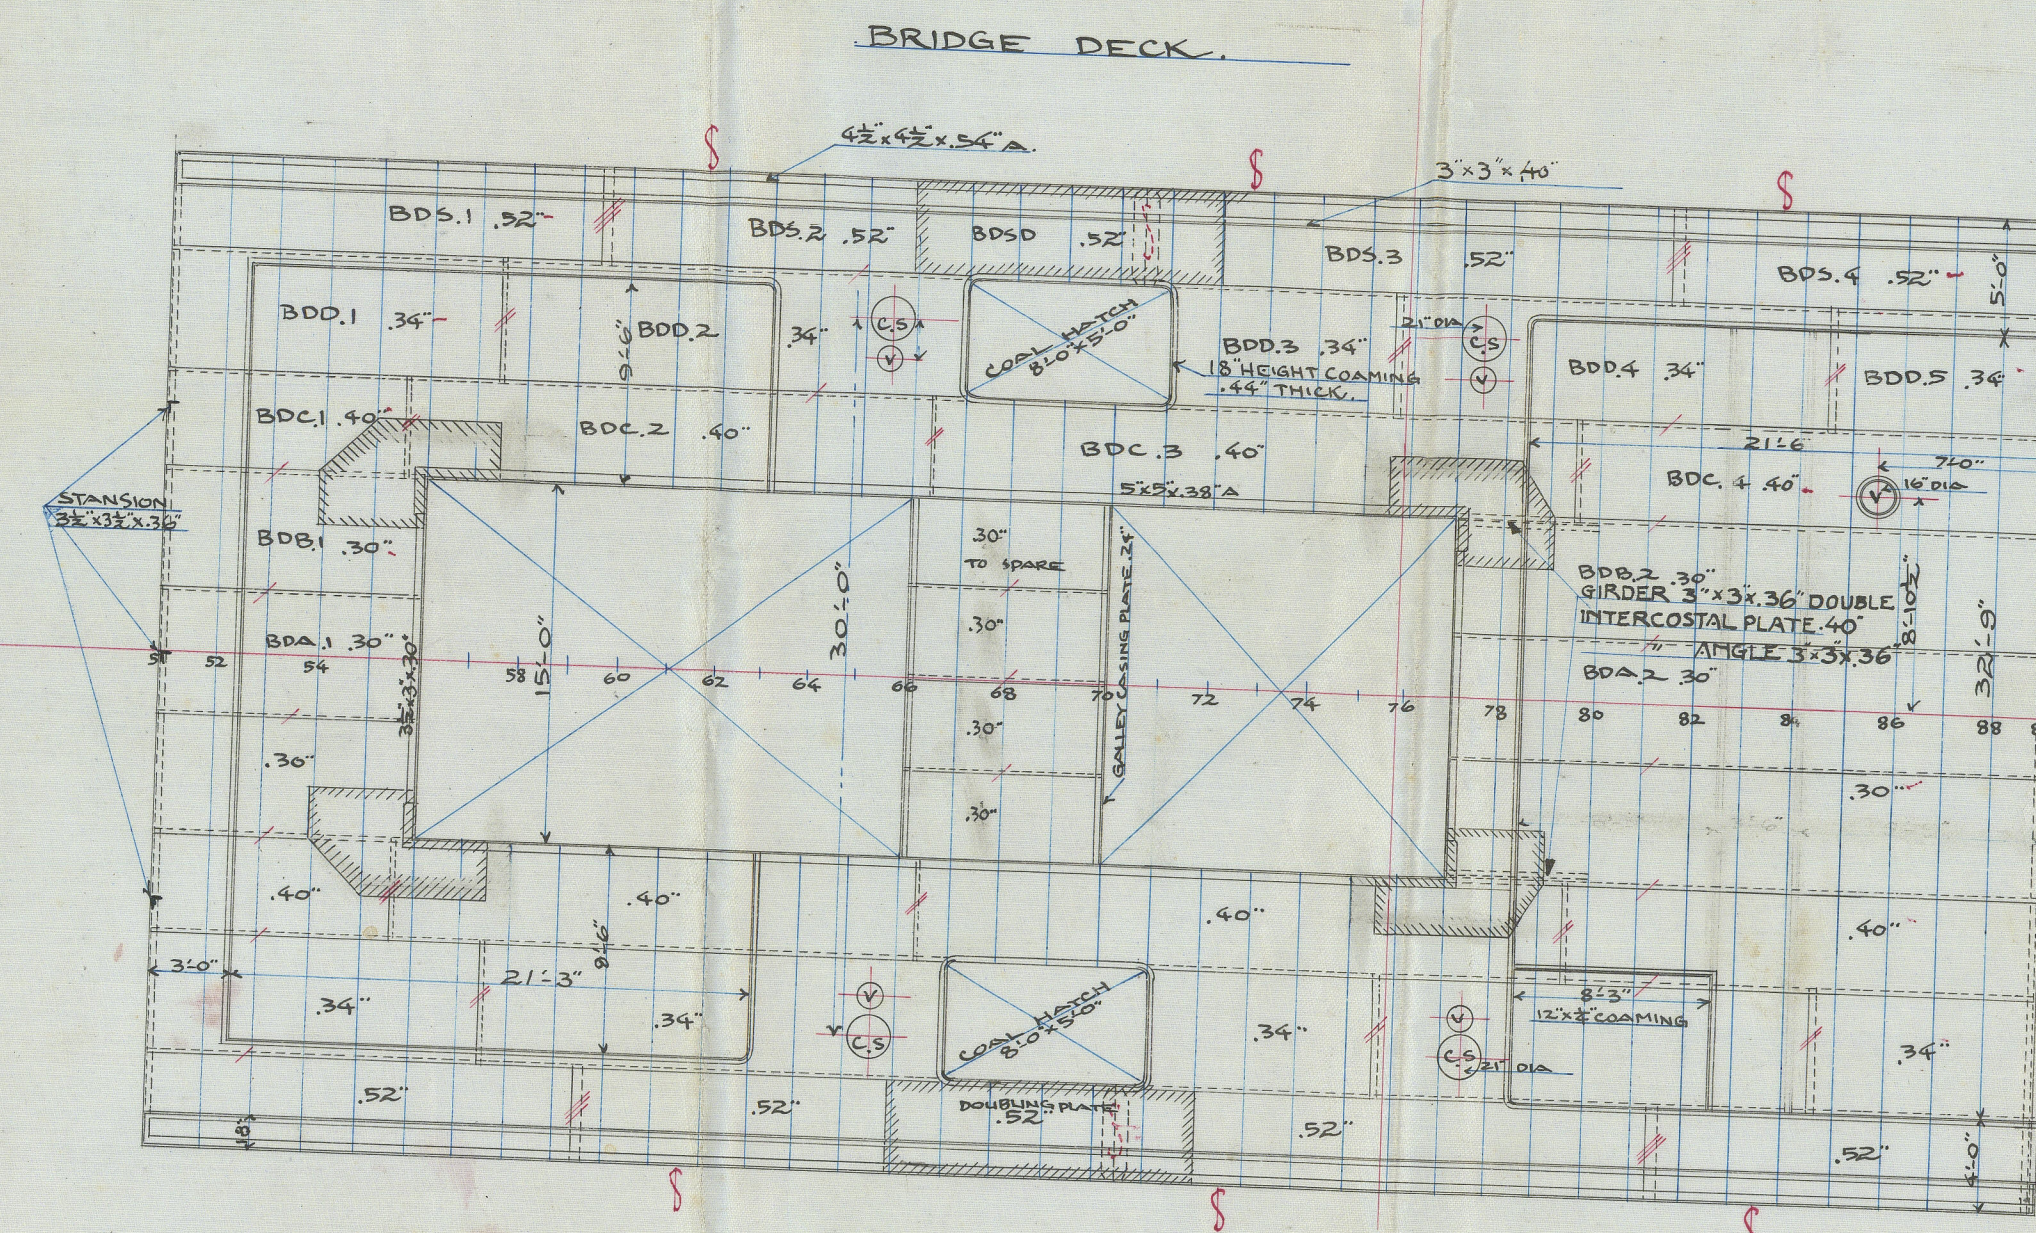
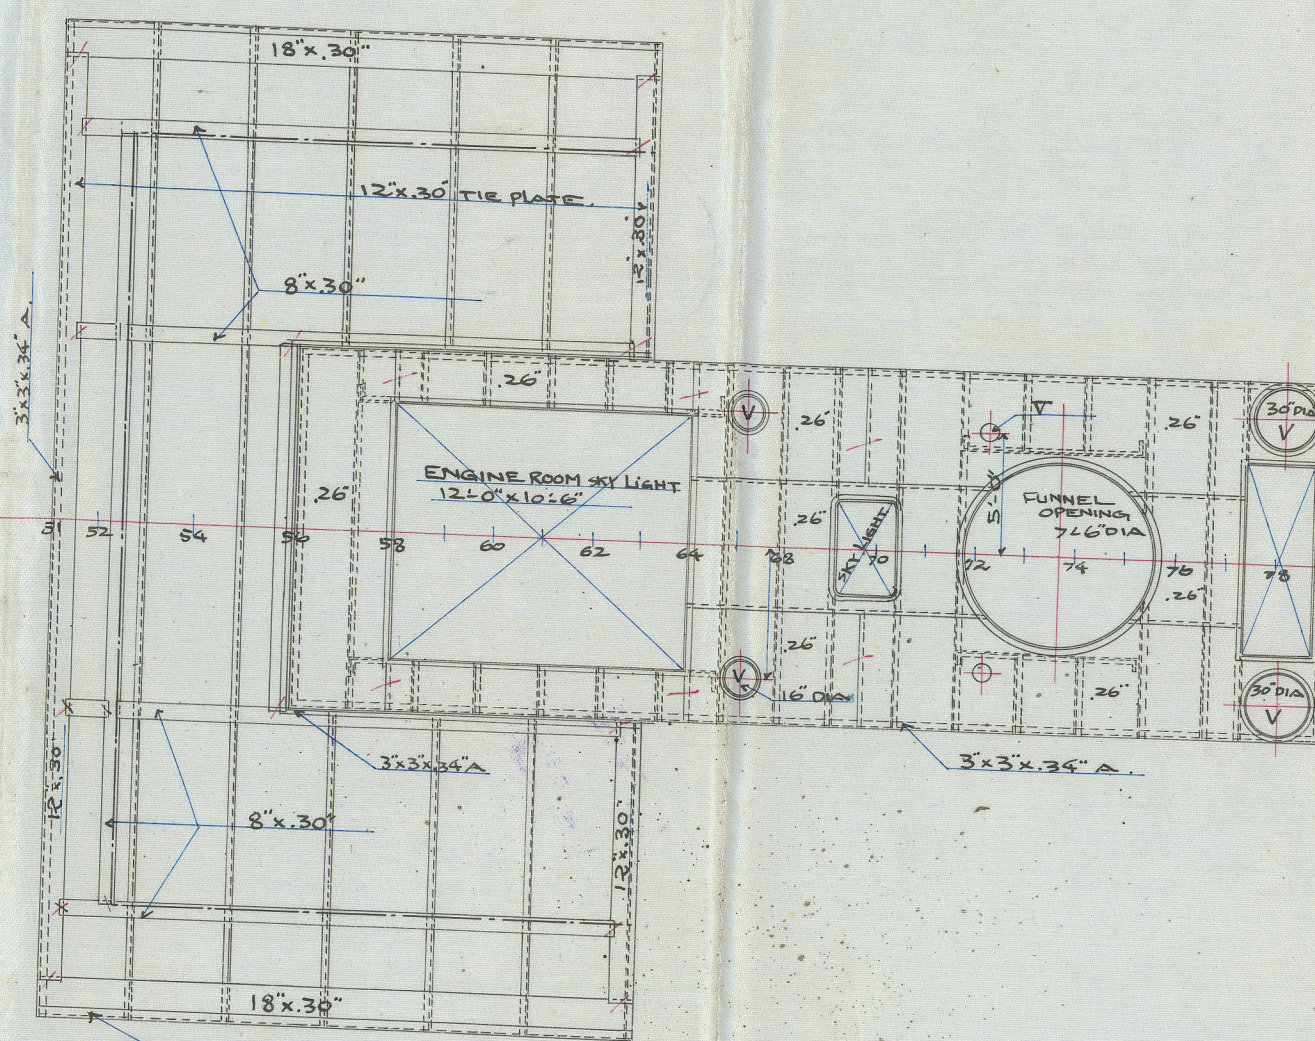


No 58.
CONSTRUCTION PROFILE & DECK PLAN.
SCALE $\frac{1}{8}$ INCH TO ONE FOOT

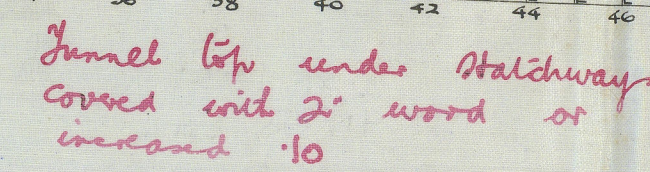

Shengdening - 2 bottom forward
as per Rules

BB/

16.6.16

MATSUO
DOCKYARD & ENGINE WORKS
NAGASAKI

DRAWN BY
TRACED BY
CHECKED BY
DATE

N^o 5-8

Nagasaki

Nagasaki Repl-^{to} 1174

