

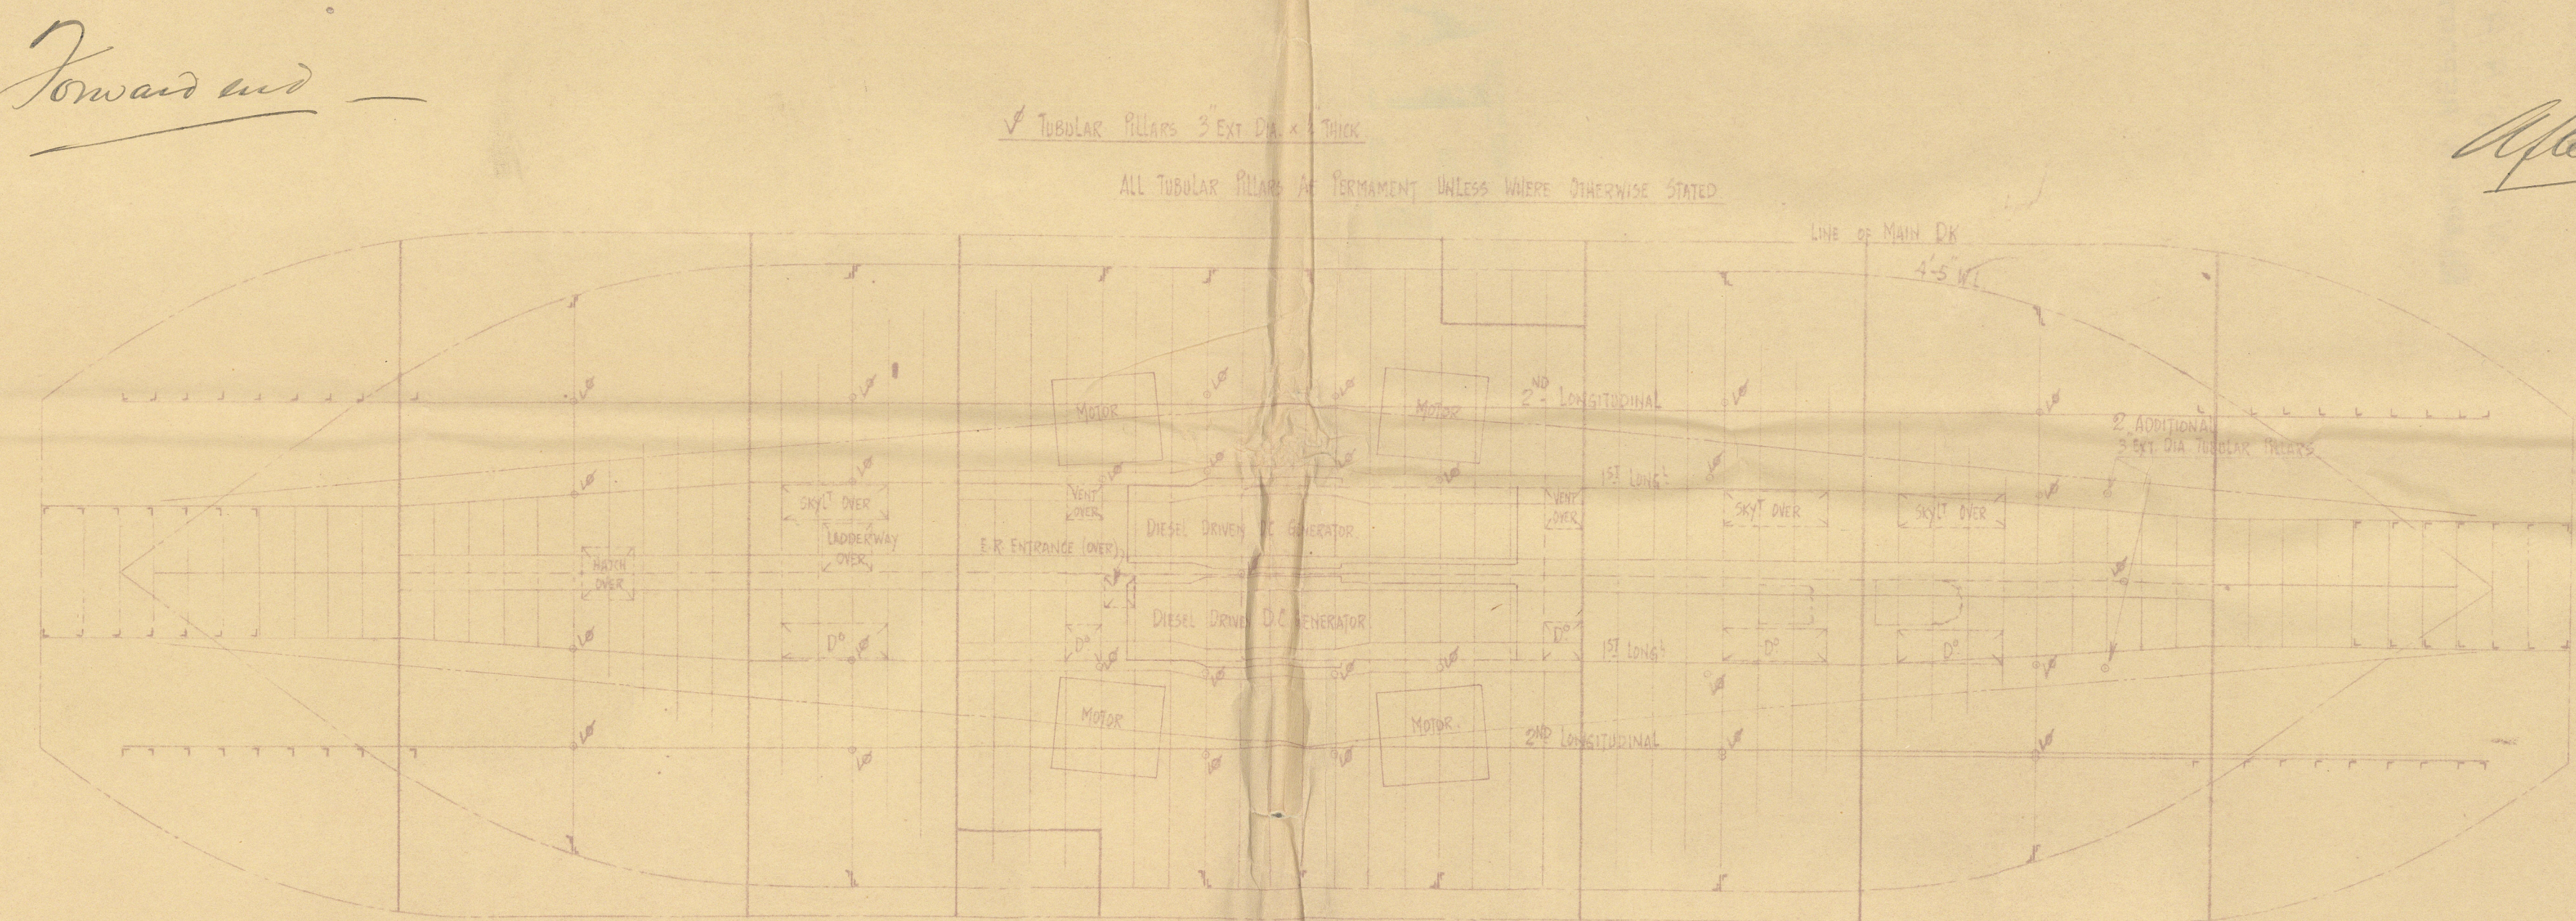
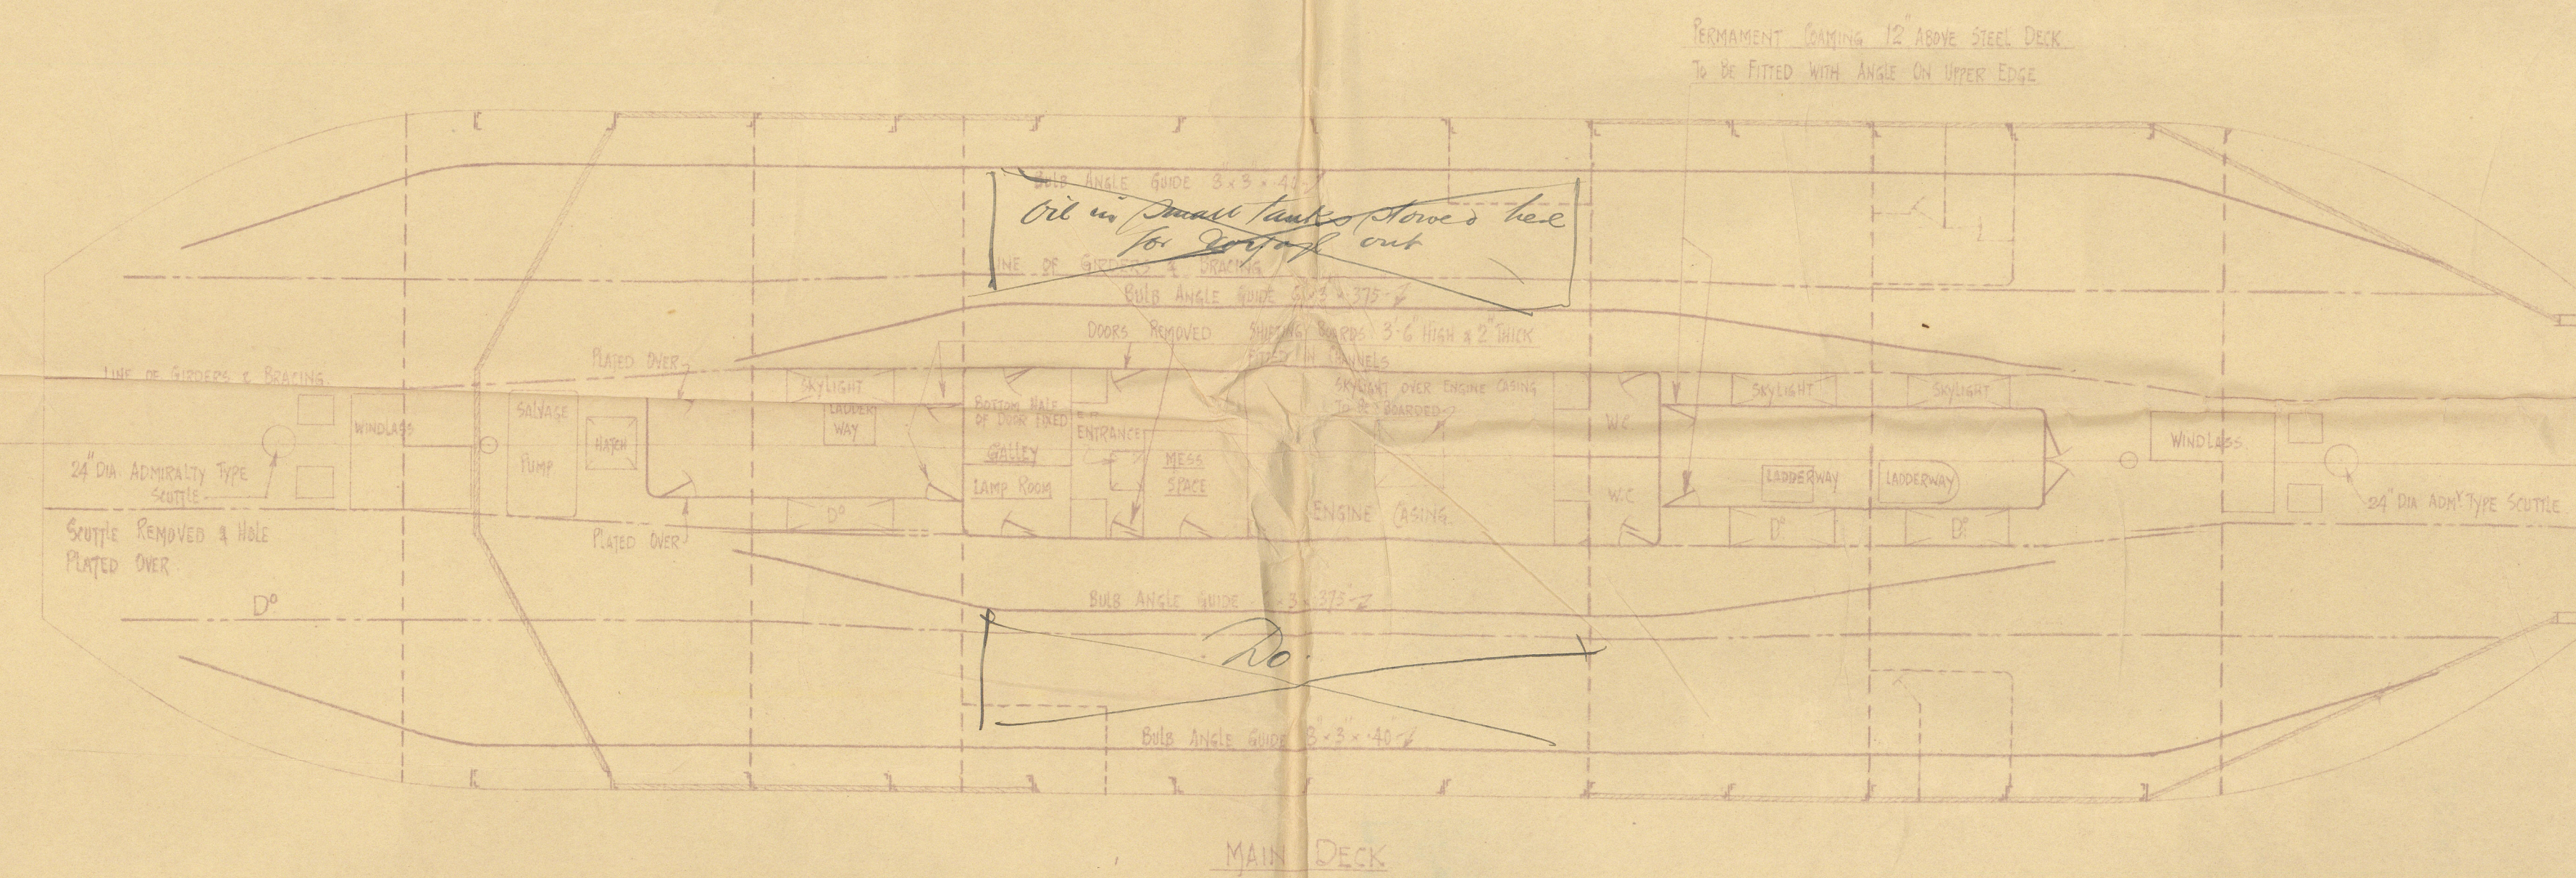
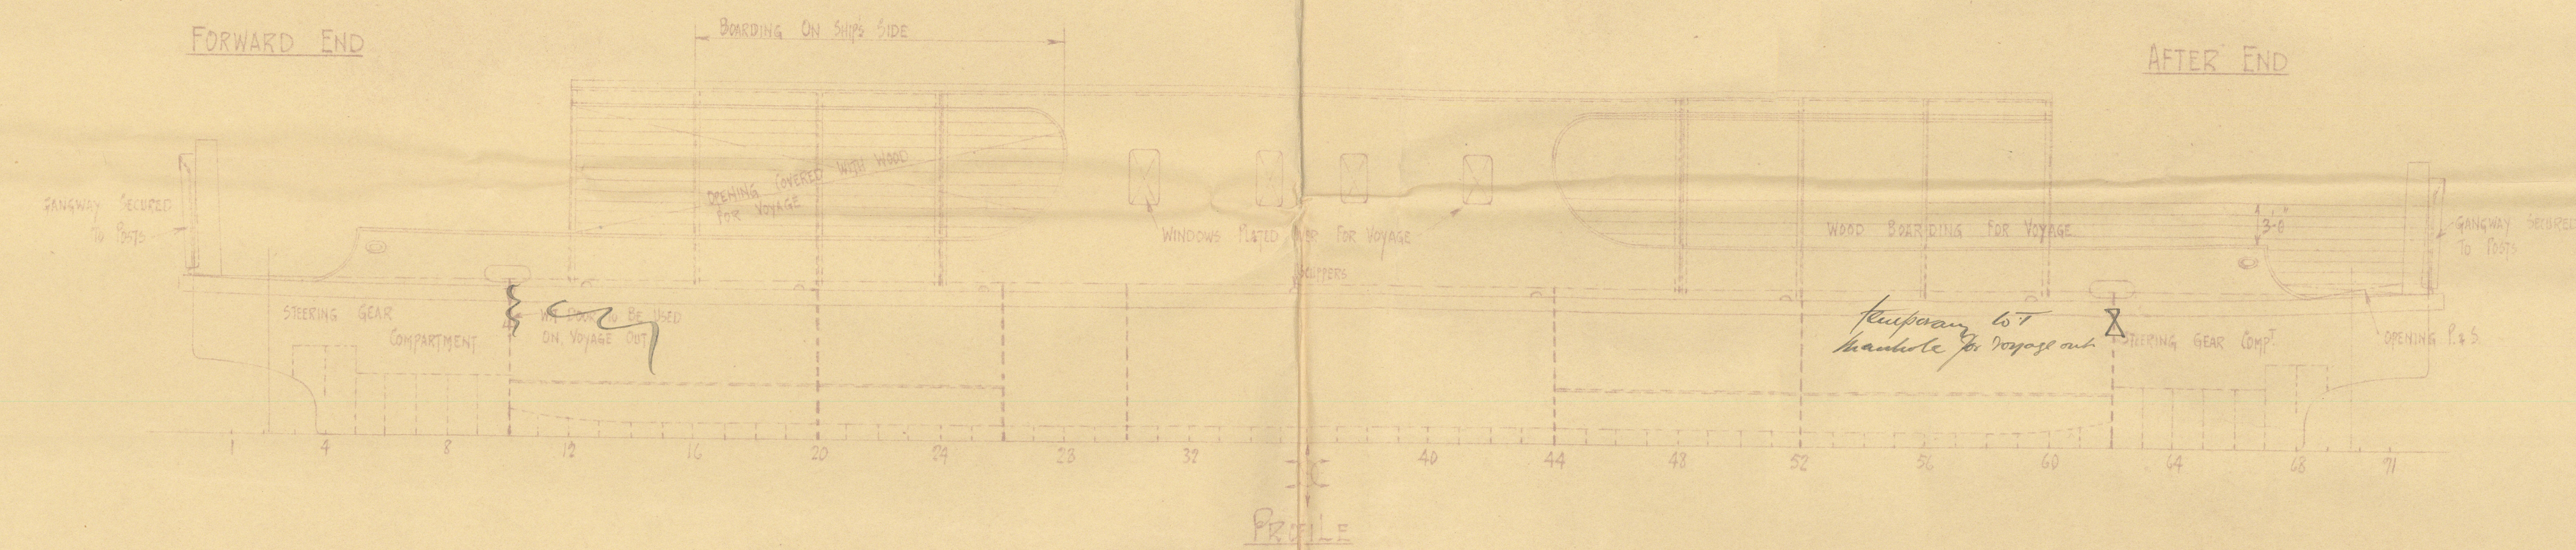


N^o 1559
 FINAL ARRANGEMENT OF BOARDING-UP ETC FOR VOYAGE OUT
 Scale - 1/8" = ONE FOOT

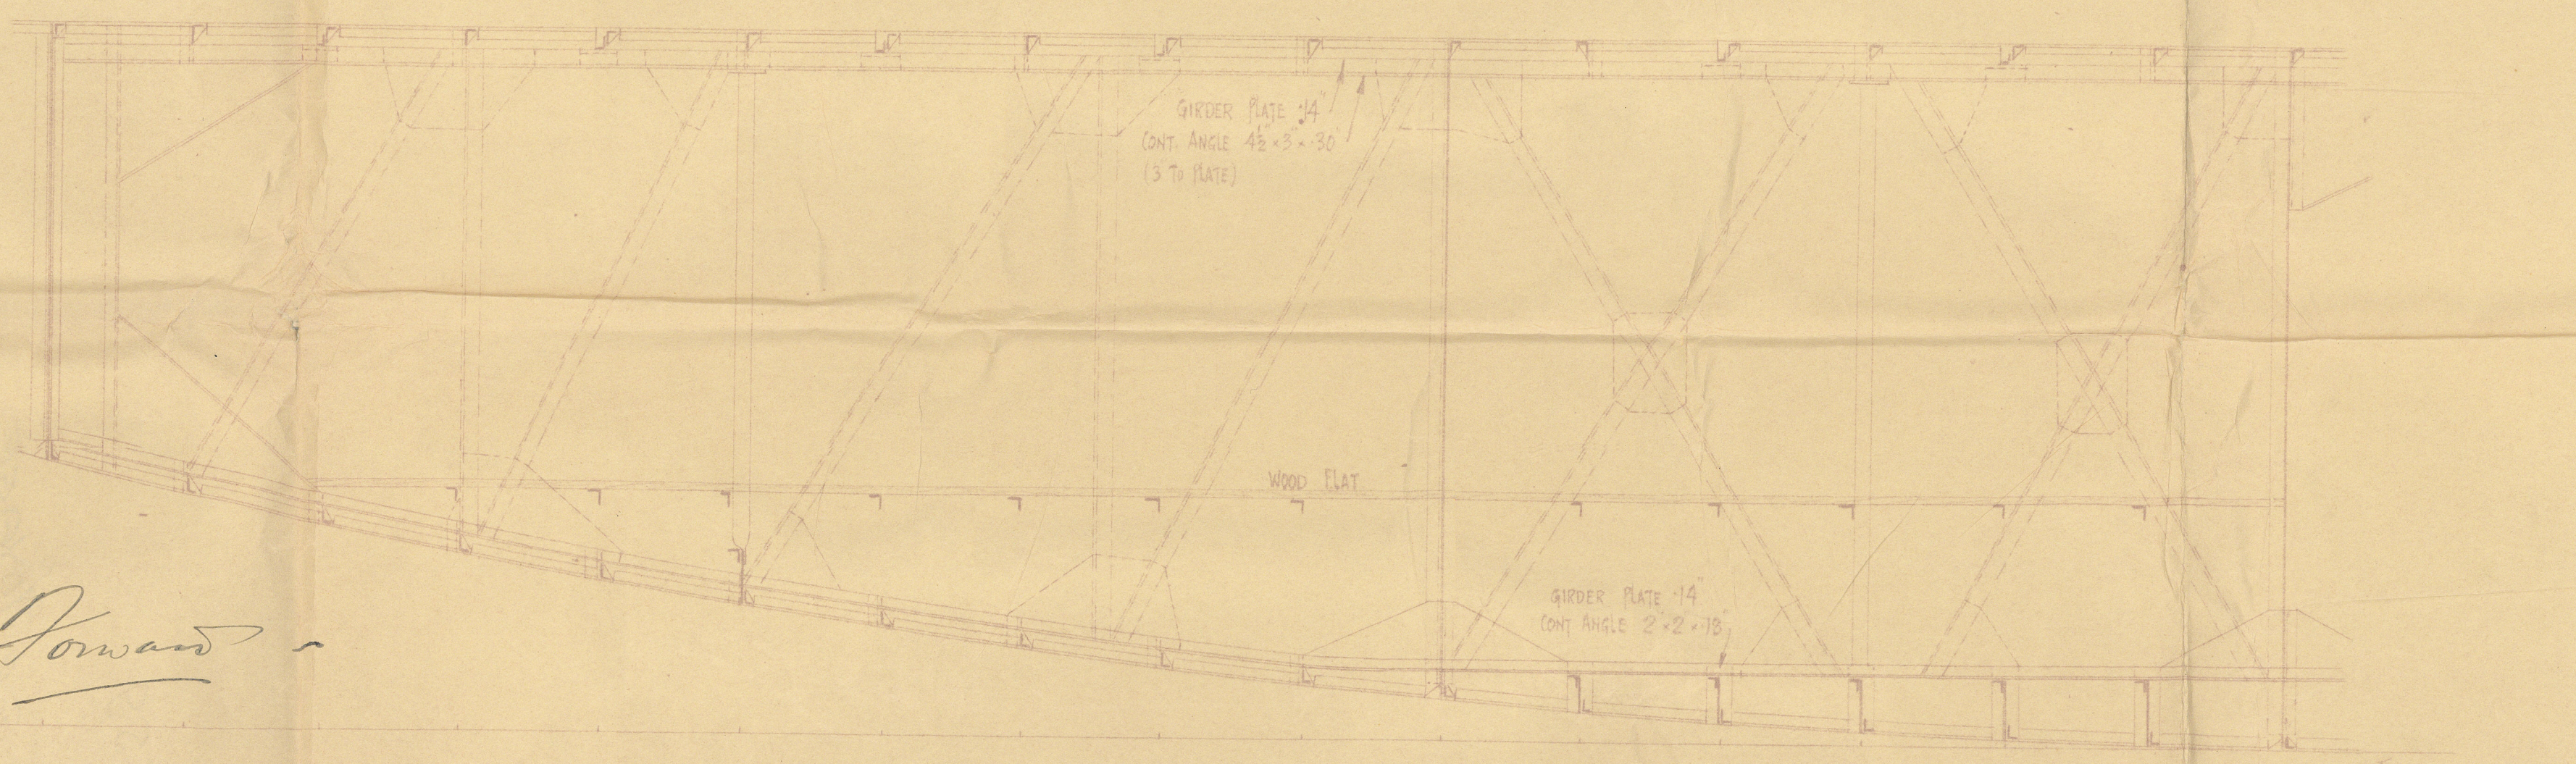


Forward

After End
 (Originally aft end)

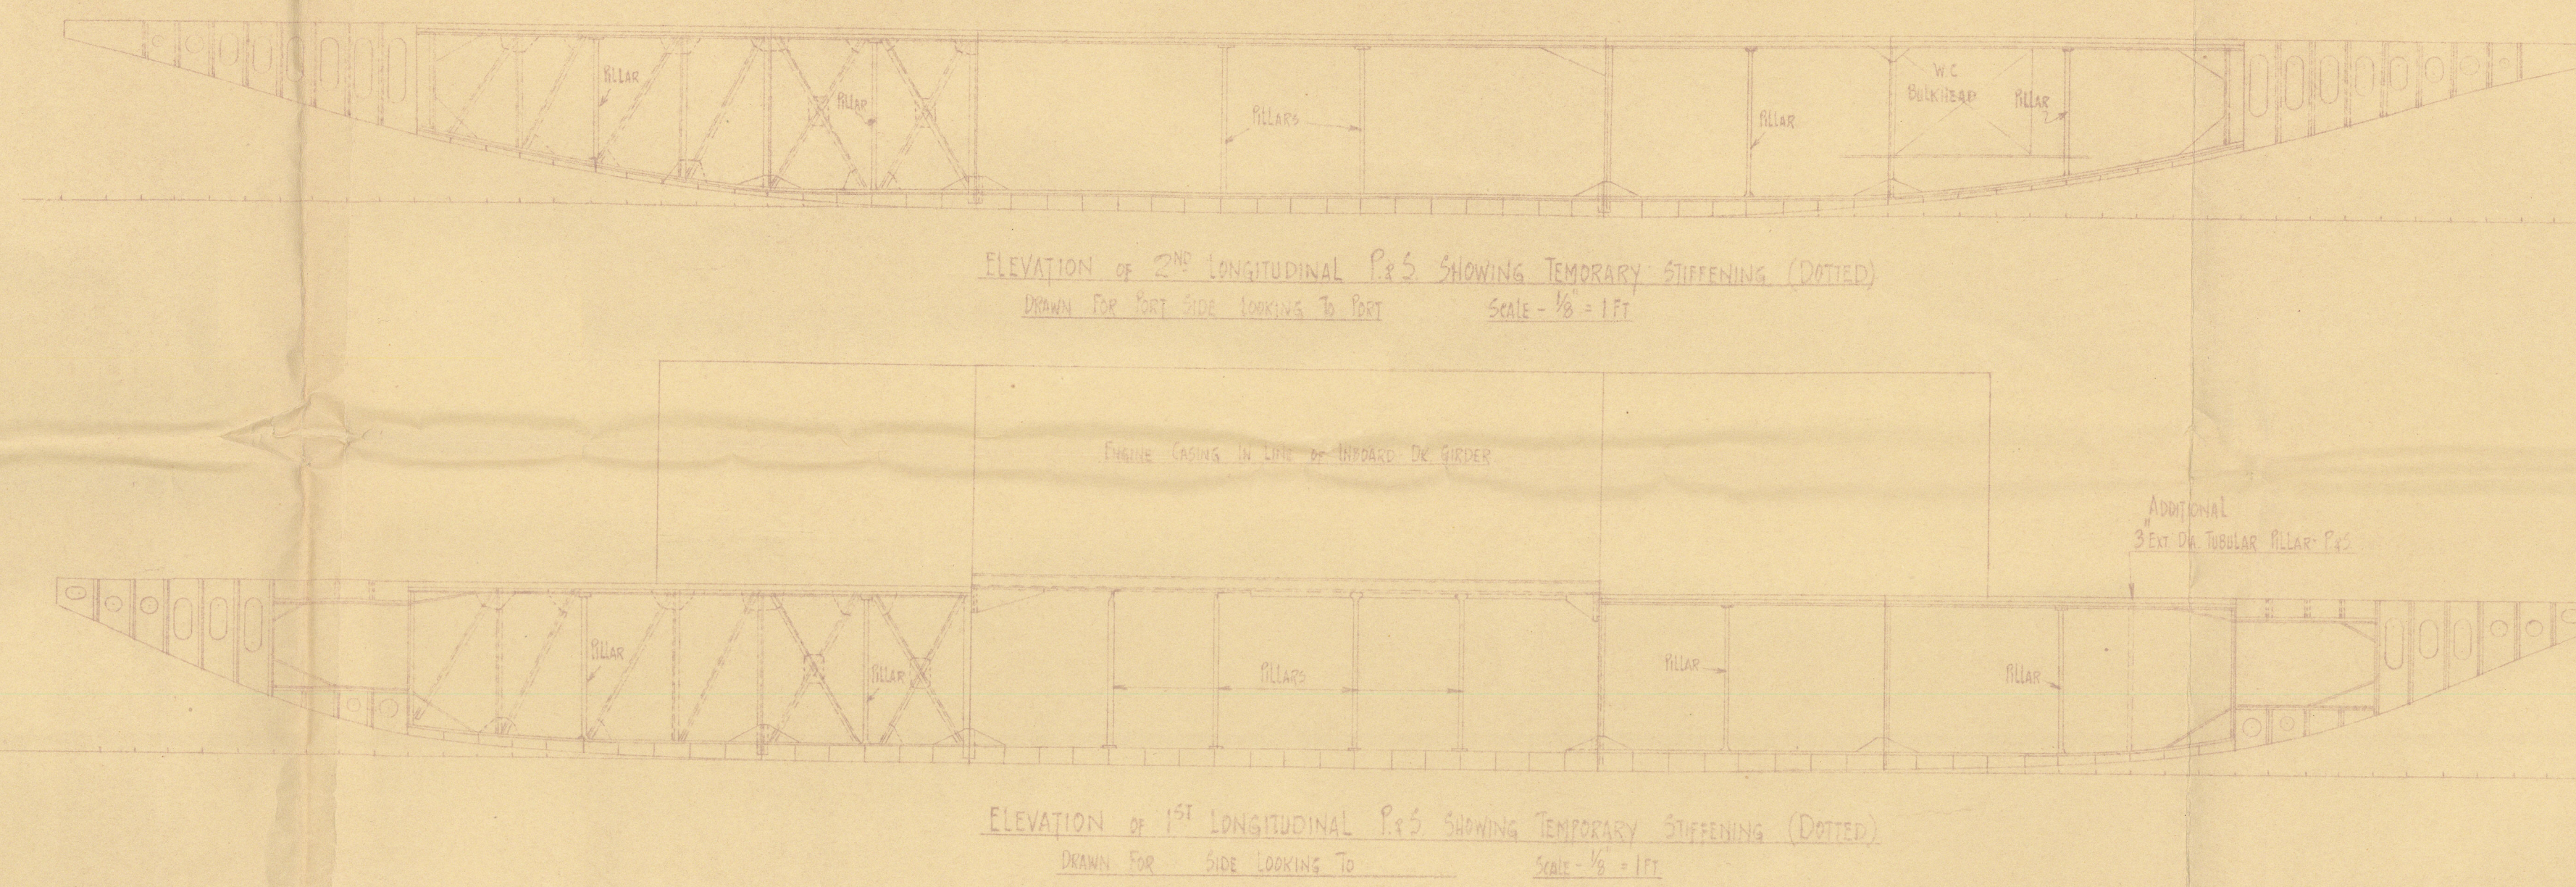

Forward


After end

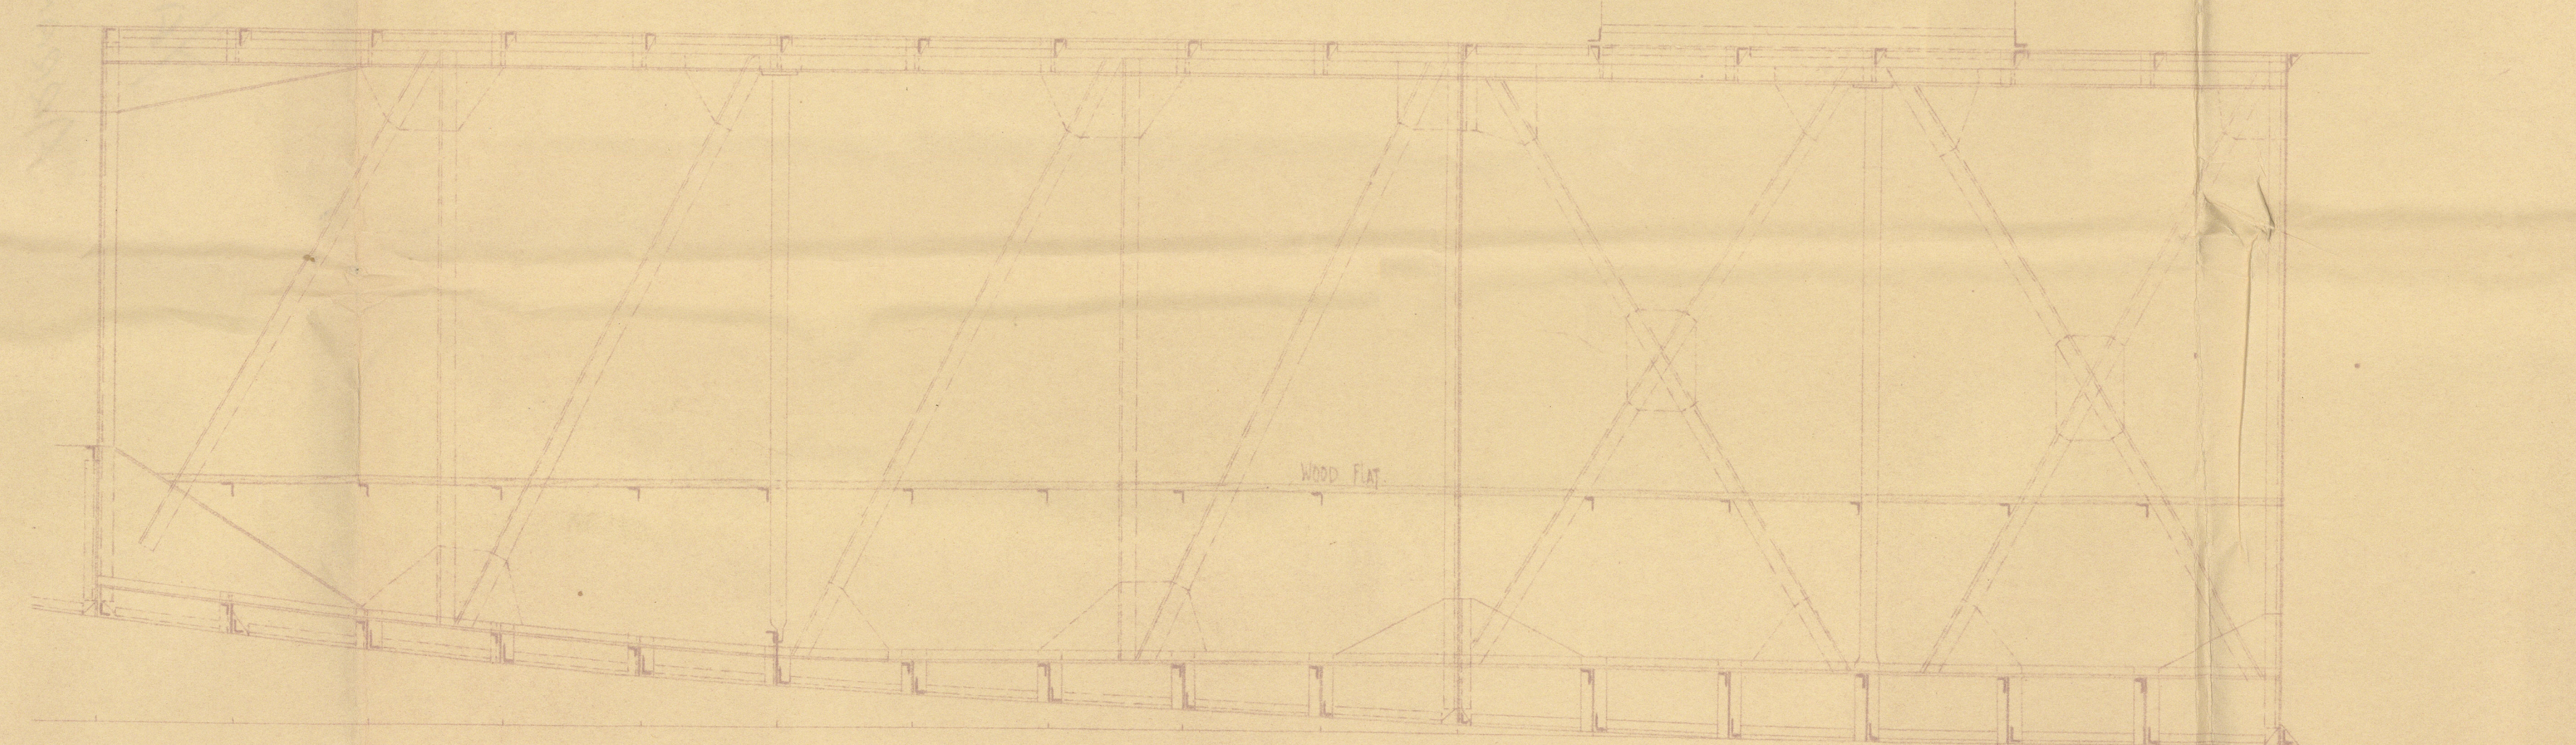

LOAD CARRIED	
Oil Fuel in Boilers (Full)	= 15.0 Tons
Oil Fuel in 20 Tanks	= 40.0
Crew	= 1.0
Provisions	= 1.5
Provisions for Voyage Out	= 7.0
Contingencies	= 5.5
Total	= 80.0 Tons

WEIGHT OF VESSEL LIGHT	= 325 Tons
LAND	= 20
DISPLACEMENT AT COMMENCEMENT OF VOYAGE	= 415
DRAFT IN S.W.	= 4'-6"

NOTE
 A SEA ANCHOR WILL BE PROVIDED
 CANVAS GEAR WILL BE FITTED OVER CABLE VEHES

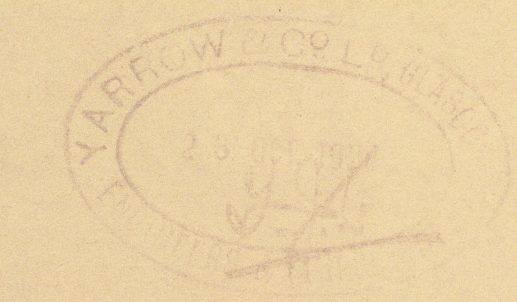

L. W. B.
 Subject to Surveyor's
 Satisfaction
 26-10-28

N^o 666A/28

YARROWS 1559.

ARRANGEMENTS FOR VOYAGE

M.O.P. & B.A.

GLASGOW REPORT No. 48537

RETAILER

© 2020

W1099-0110
Lloyd's Register
Foundation