

N° 1559.

MOTOR FERRY BOAT

M.O.P. 5.B.A.

BY

YARROW & CO GLASGOW.



GENERAL ARRANGEMENT

PROFILE & MAIN DECK.

SCALE 1/48.

LENGTH OVERALL	=	147' 1"	=	44.83 METRES
LENGTH B.P.	=	135' 0"	=	41.14
BREADTH OVERALL	=	41' 7 1/2"	=	12.68
BREADTH OF HULL M.S.P.	=	36' 0"	=	10.97
ON L.W.L. AT 30'				
DEPTH M.S.P. 30'	=	9' 3"	=	2.87

NOTE: THIS DRAWING MAY BE MODIFIED
IN MINOR DETAILS AS THE WORK
PROCEEDS.

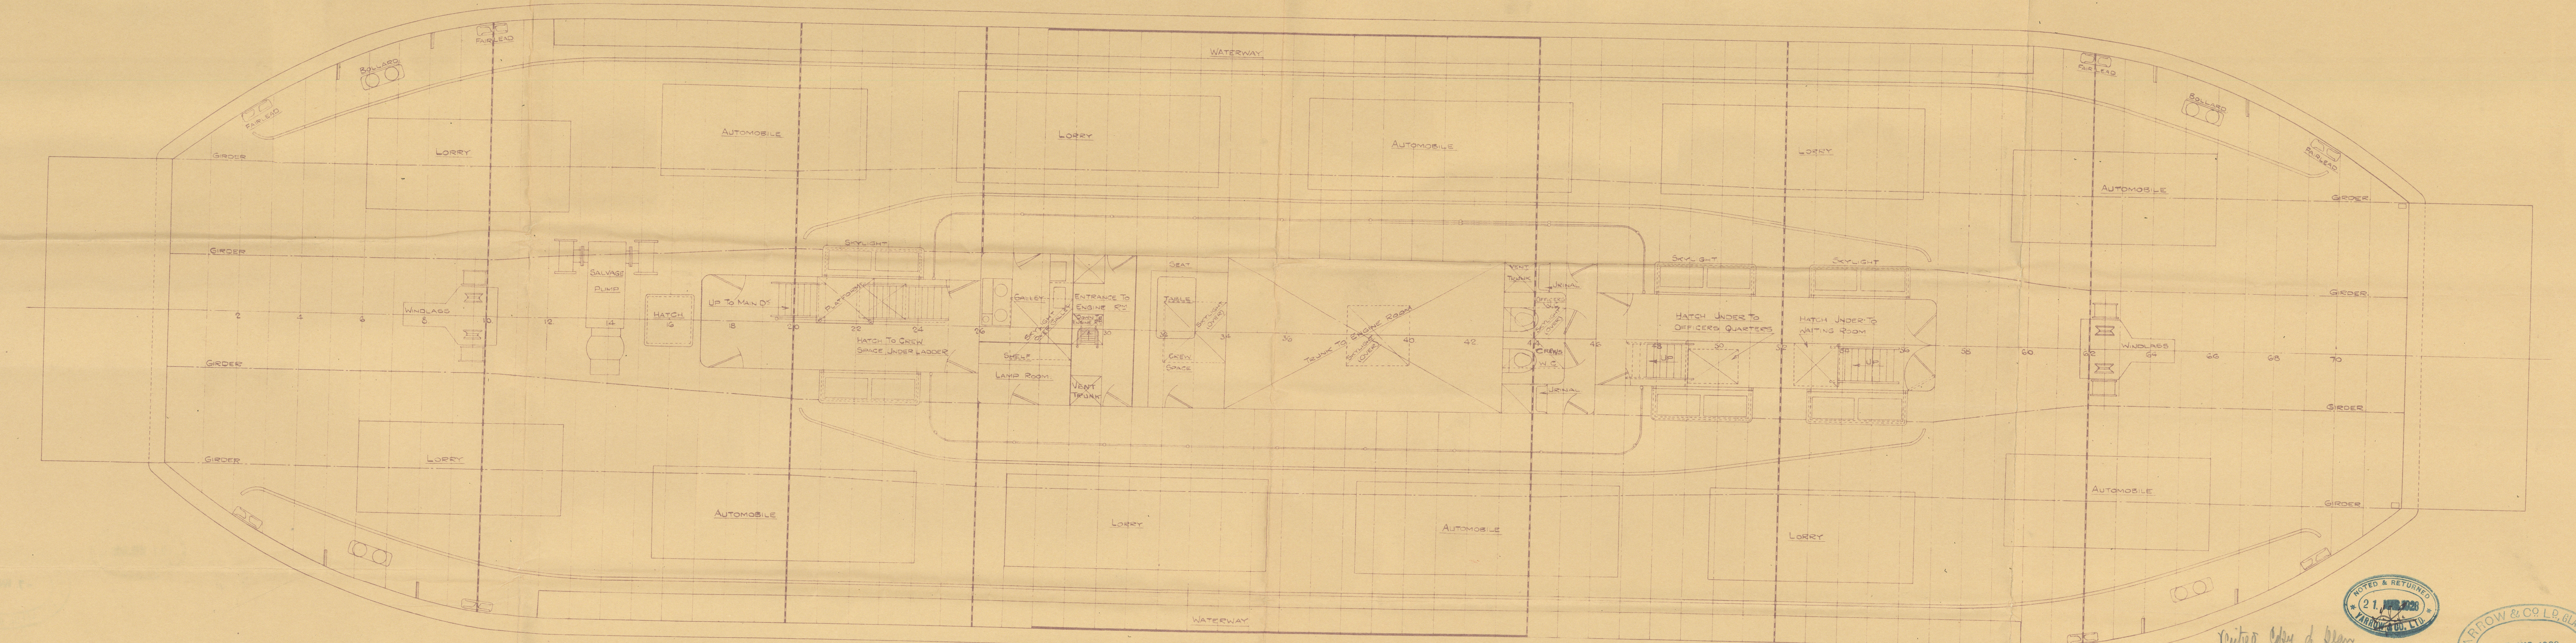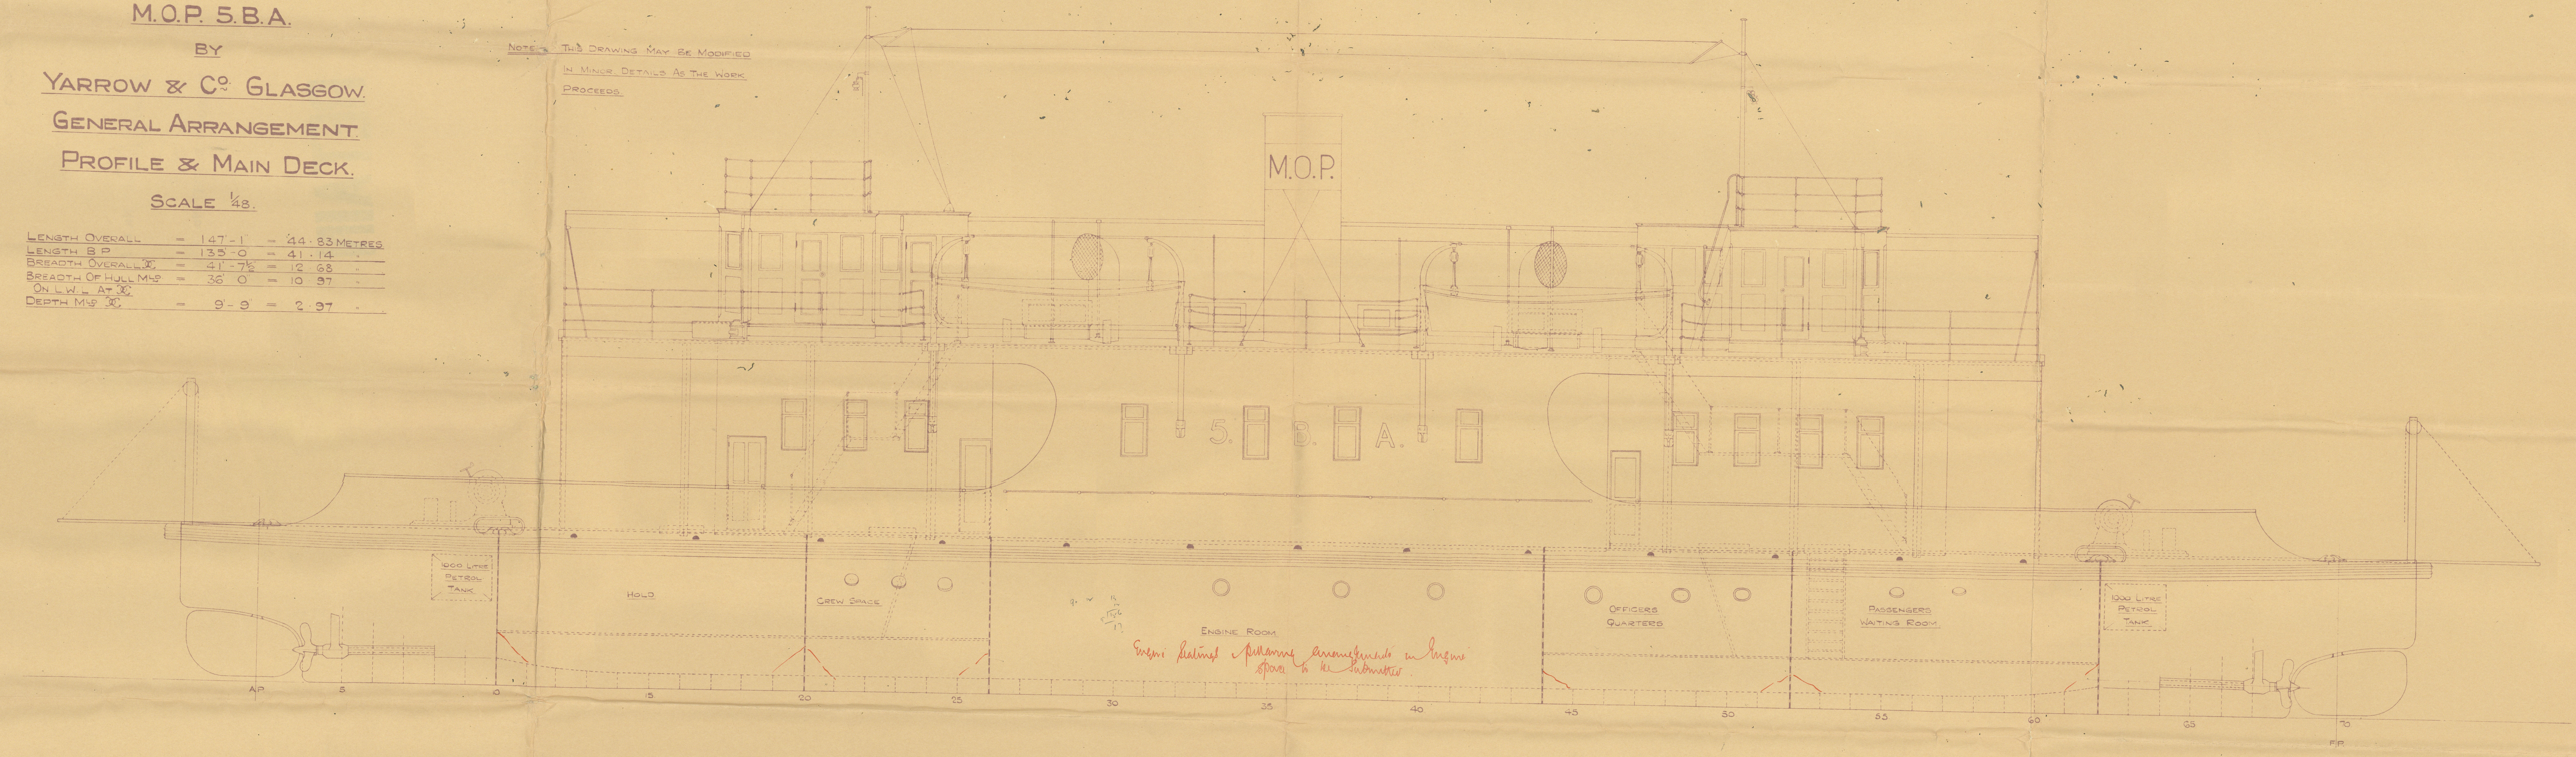

APPROVED
LLOYD'S REGISTER OF SHIPPING
DATE 19.3.28
N° 15208.

- YARROWS 1559 -


GENERAL ARRANGEMENT

(PROFILE)

Fba
GLASGOW REPORT No. 48535

M.O.P. 5 B. A
GLASGOW REPORT No. 48535

RETAIN

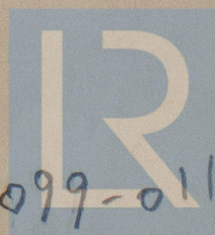

© 2020

W1099-0117

Lloyd's Register
Foundation