

1-8-05



N<sup>o</sup> 516.

# PROFILE & DECK PLAN

DIM 135' x 22'-1" MLD 13'4" MLD.

STEEL CLASS 100A1 FOR FISHING PURPOSES.

1/4" = 1 FOOT

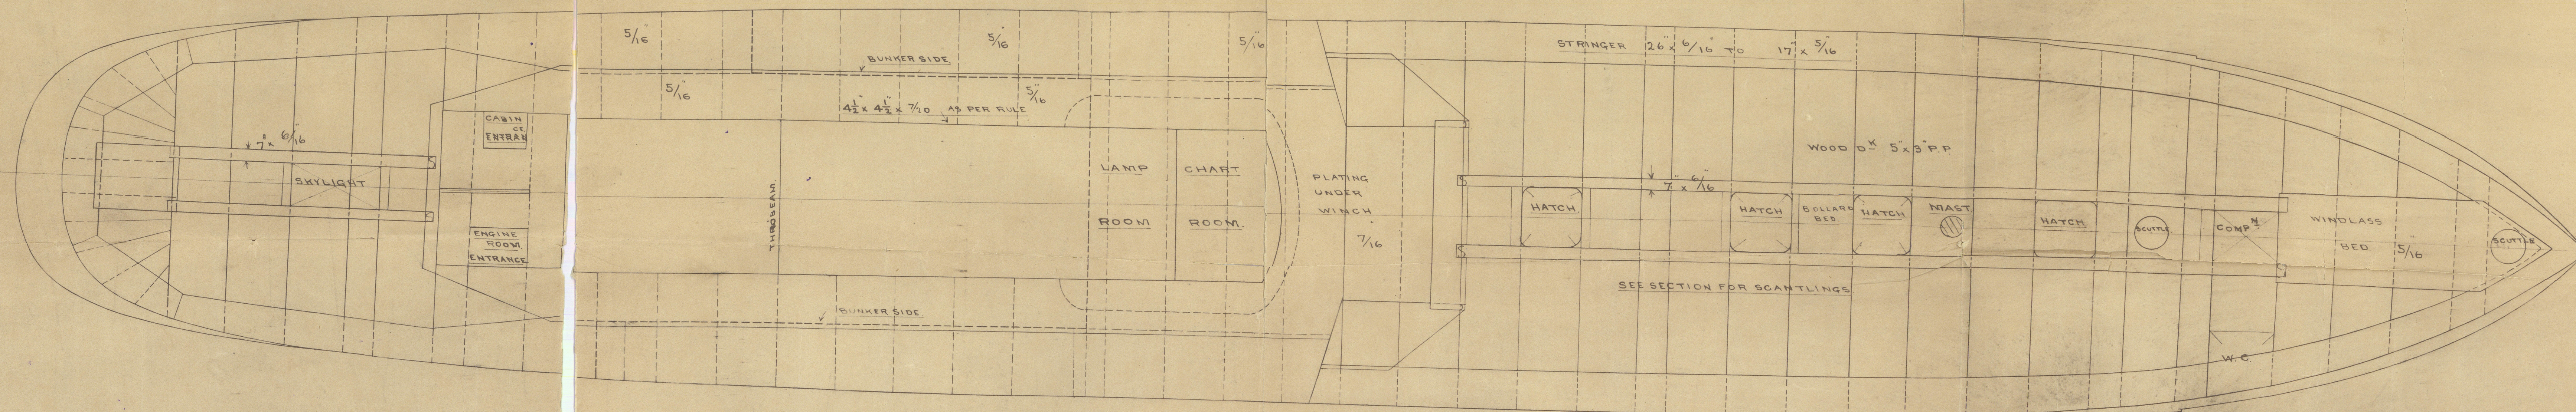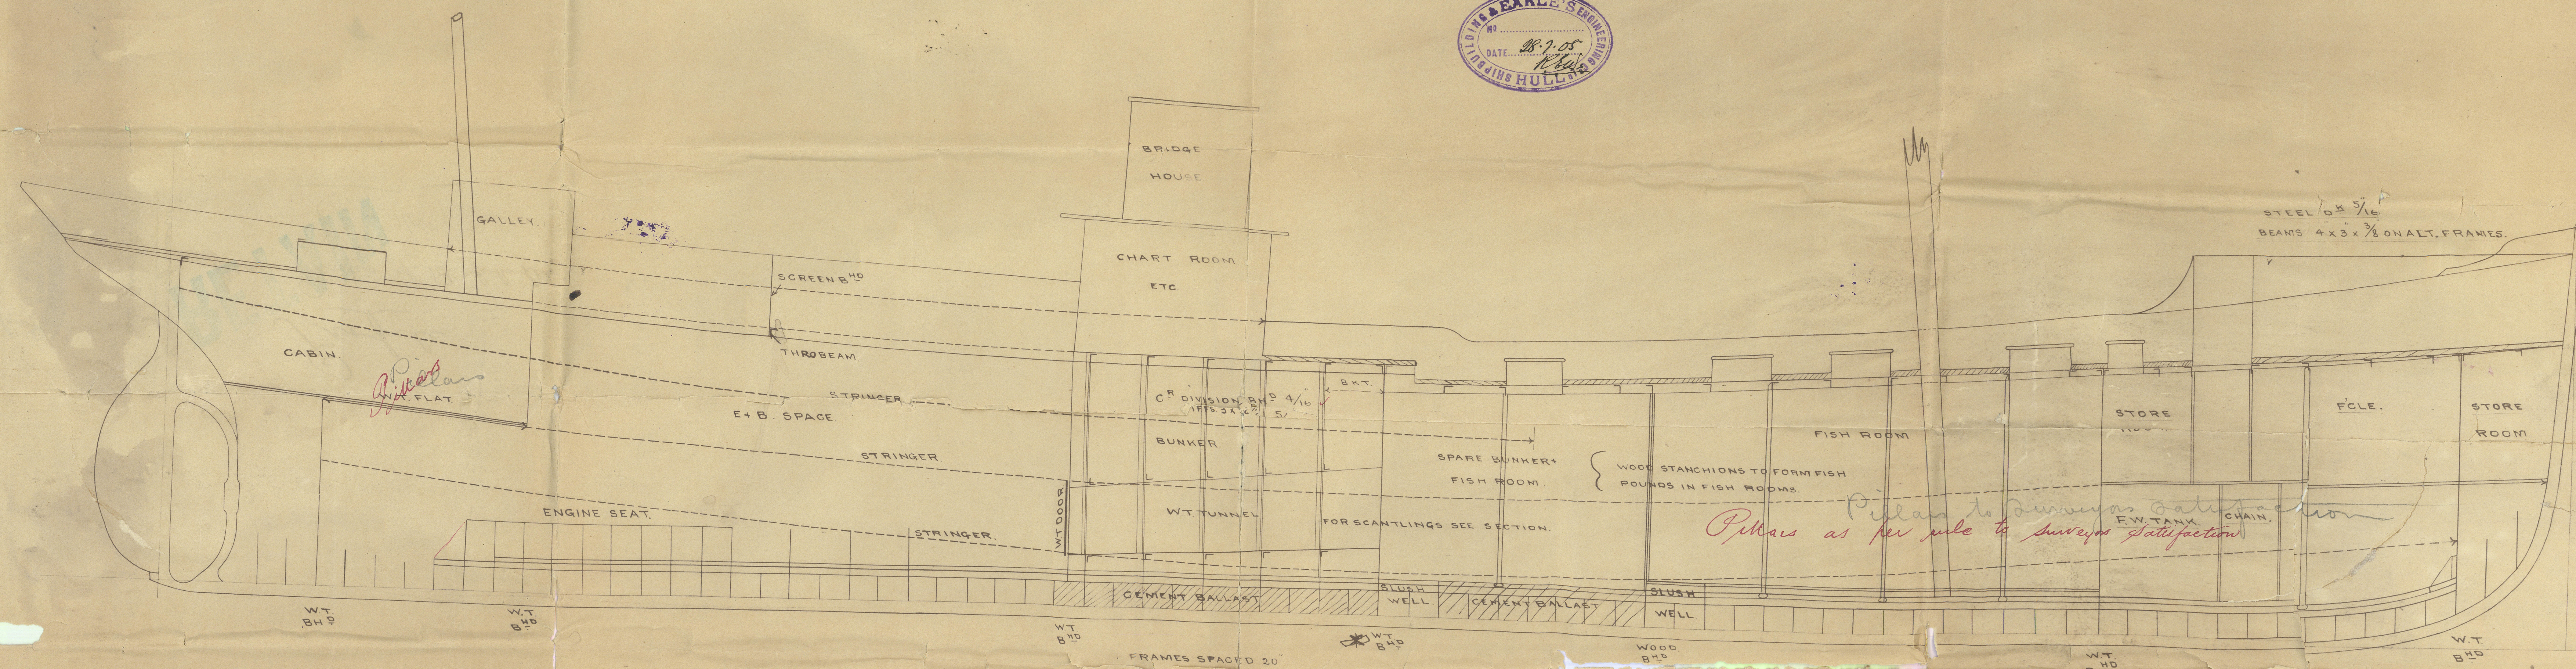

C.B.  
1-8-05.



Profile



Mrs. Barle's S. B. & Co. Ltd

PA 5-16

RETAILED

s/s "Whitefriars"

Hall Report No. 17573.

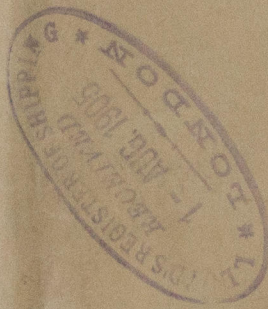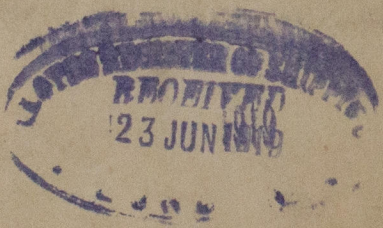

W1109-0130



© 2020

Lloyd's Register  
Foundation