

MIDSHIP SECTION

S.S. N° 165.

also nos. 166 & 167
app. 20.6.01, also 169, app. 17.4.02


LENGTH B.P. 319' 6" BREADTH EX 46' 0" DEPTH MLD 23' 9"

ONE DECK LAID. WEB FRAMES, & DEEP FRAMING.

CLASS 100 A.I.

SCALE: 1/2" TO ONE FOOT.

6.5.01
14.5.01
20.6.01 (nos 166 & 167)
3.10.01
13.11.01
10.12.01
17.4.02 (no. 169)
30.4.02
8.7.02
18.7.02
30.7.02

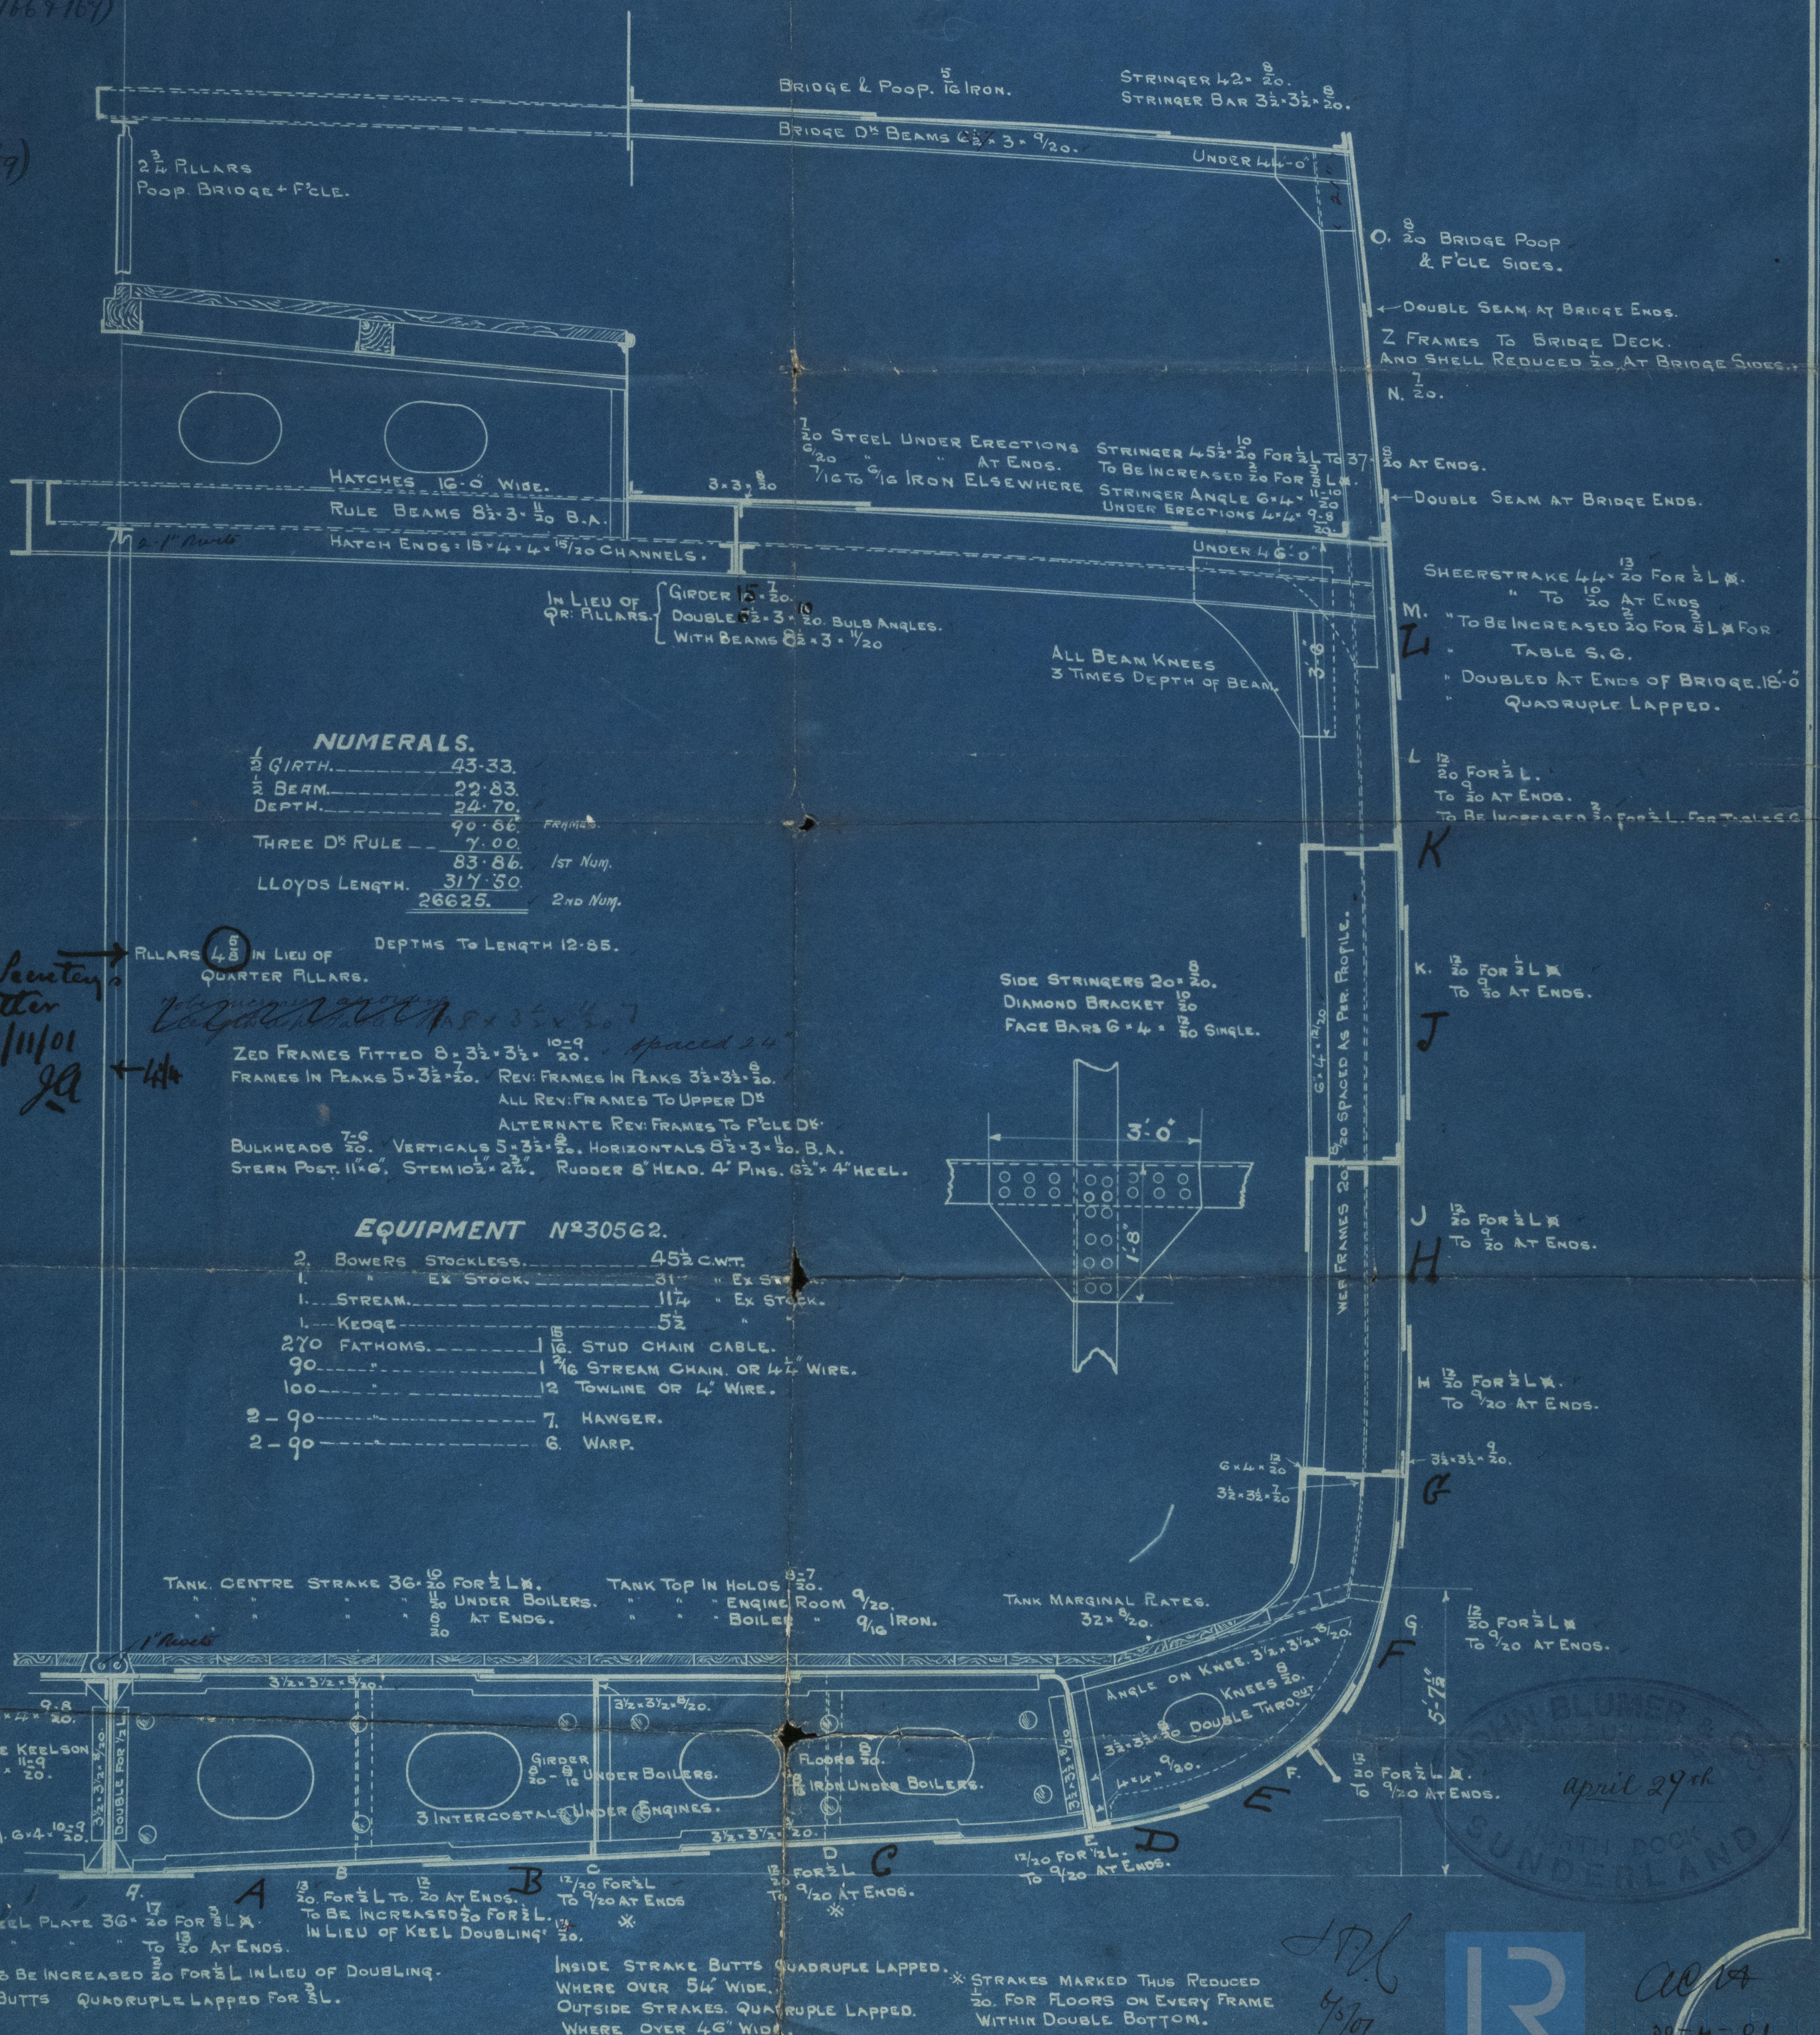

See Secretary's
letter
13/11/01
JL

BLUNTER
april 29th
SUNDERLAND

R

all 14

30-4-01

1000-0007

S.S. "Rose Lea"

John Blumer & Co.

Gundertland. No 21068.

η = 165 - 166 - 167
- 169

S.S. "Caristbrook"

Midship Section












Gundertland. No. 2177.

S.S. "Embricos"

Gundertland. No 20875.

S.S. "Barbo Bank"

Gundertland. No 20966.

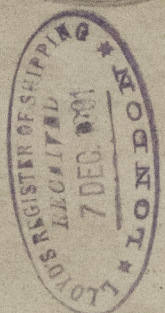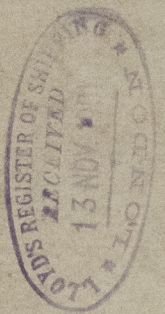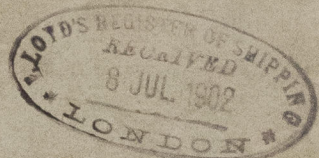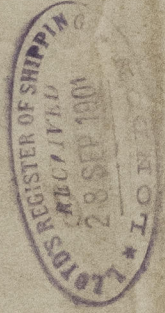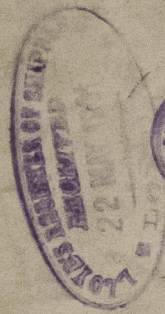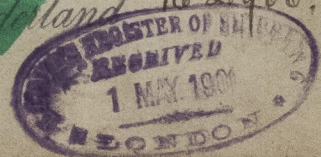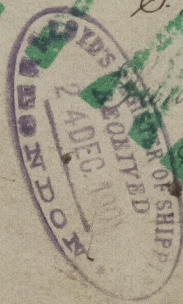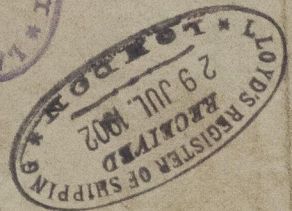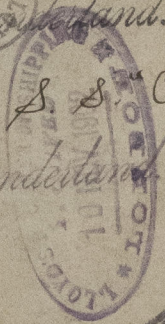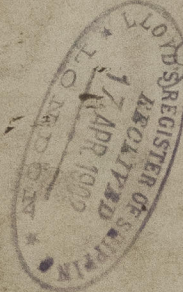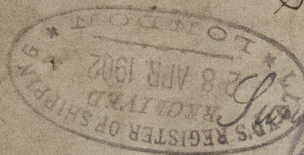

1900 - 0007




© 2021

Lloyd's Register
Foundation

I

III

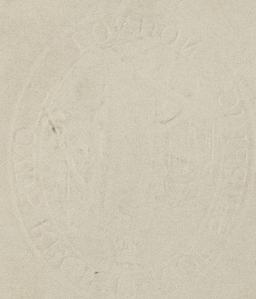

© 2021

Lloyd's Register
Foundation