
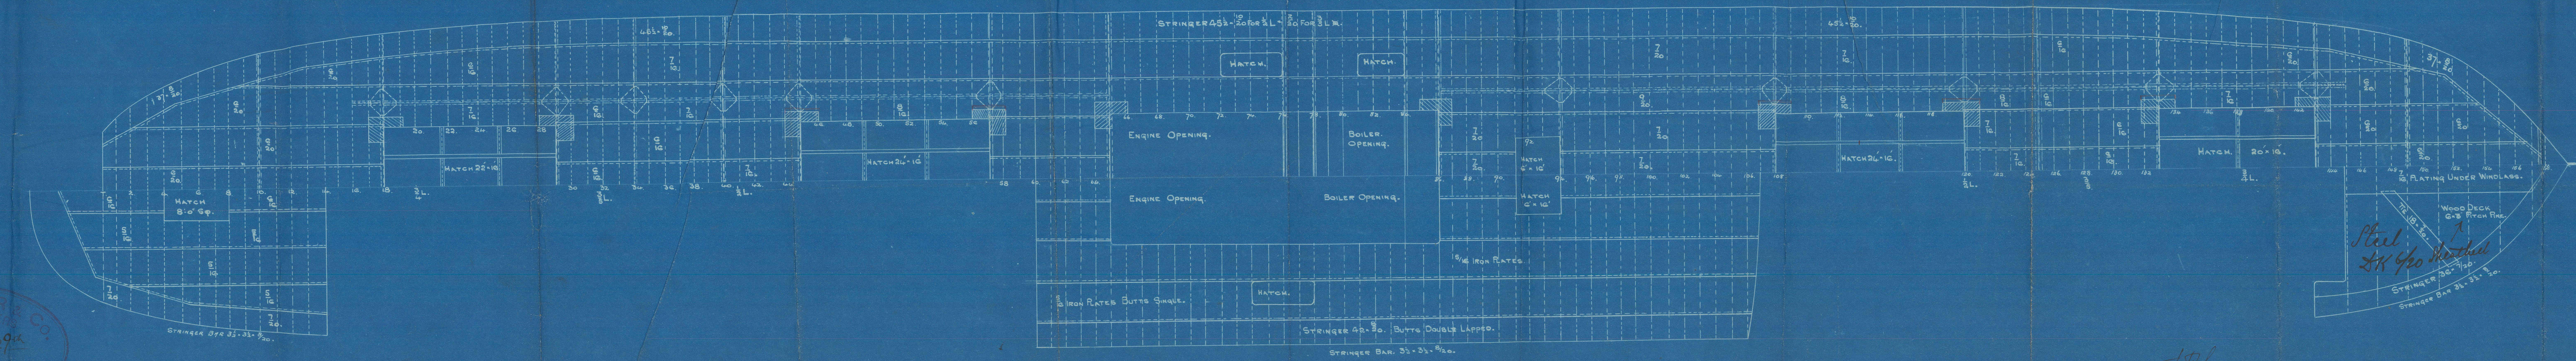


6.5.01
 20.6.01 (Rev. 14.11.01)
 3.10.01
 13.11.01
 10.12.01
 17.4.02 (Rev. 14.11.01)
 30.4.02
 8.7.02
 18.7.02
 30.7.02

PROFILE & DECK PLANS.

No 165. also Nos. 147, 148, 149, 1000.

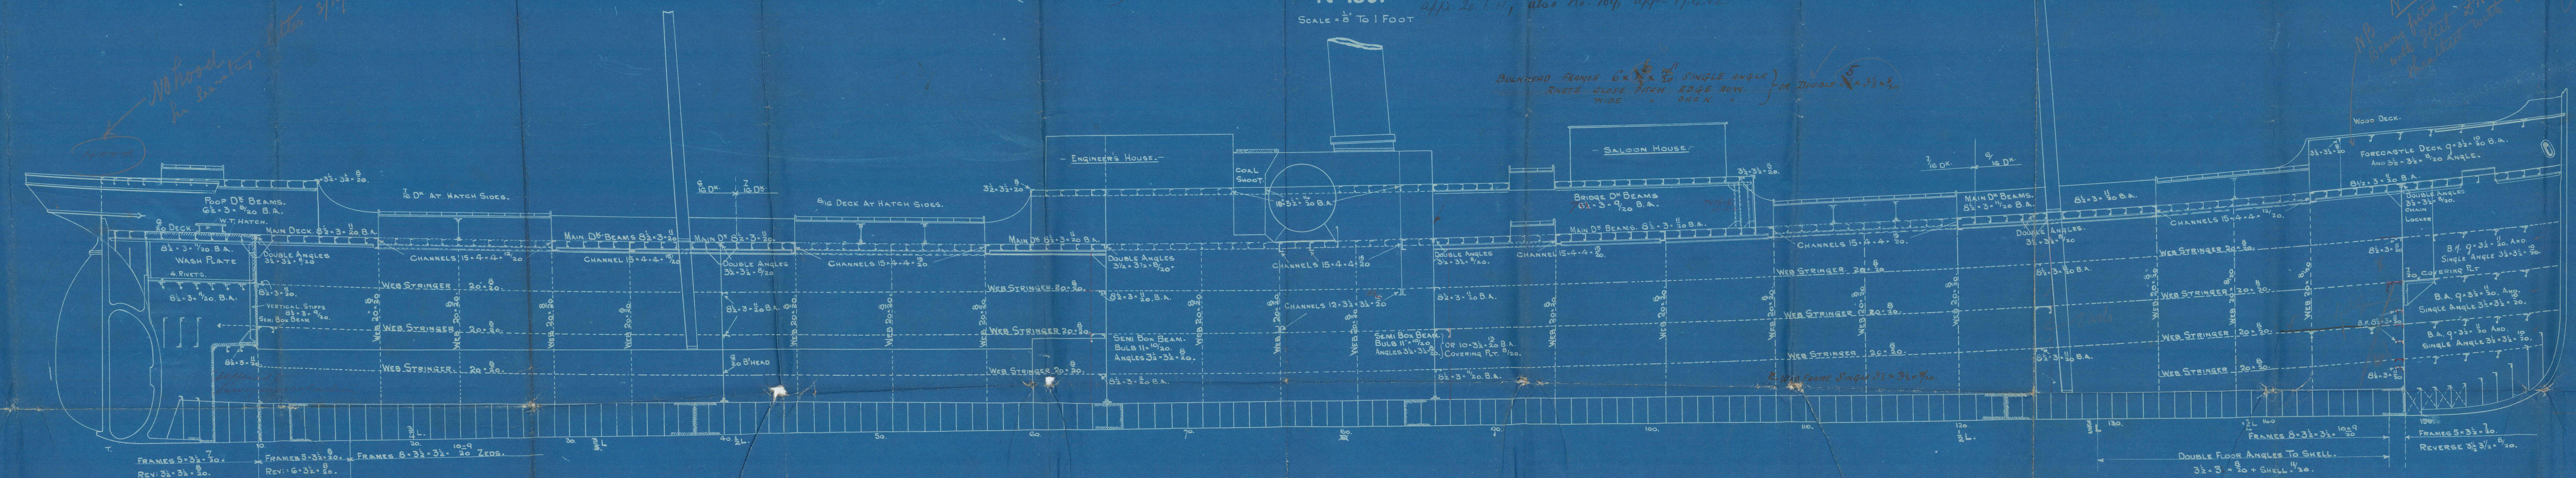

JOHN BLUMER & CO.
 SHIPBUILDERS
 NORTH DOCK
 SUNDERLAND
 April 29th

Steel
 2 1/2" x 1/4" x 10' 0"
 Stringer Bar 2 1/2" x 3/4" x 10' 0"

S. S. "Rose Lea"

Sunderland No 21068.

S. S. "Canalbrook"

Sunderland No 21177

John Blumer & Co

72165-166-167.

-169











Profile

S. S. "Embiricos"

Sunderland No 20876.

S. S. "Barb Bank"

Sunderland No 20966

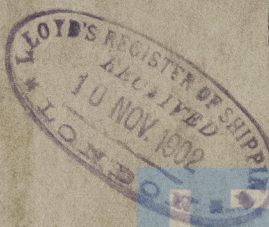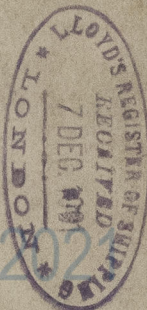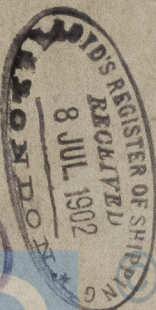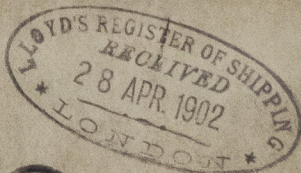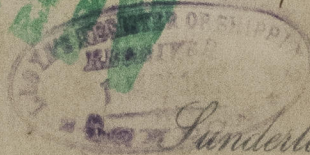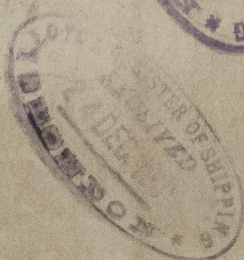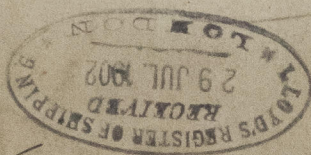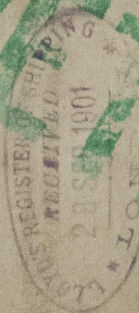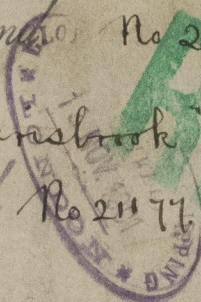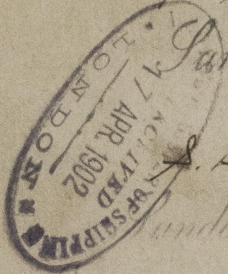

Valera

Lloyd's Register
Foundation

21100-0068