


25 10-09

S.S.N:24.
LONGITUDINAL & DECK PLANS
DIMENSIONS 212'0"X33'0"X15'9"MLD.
TO CLASS 100 A1 AT LLOYDS
SCALE 1/8"=1 FT.




PROFILE

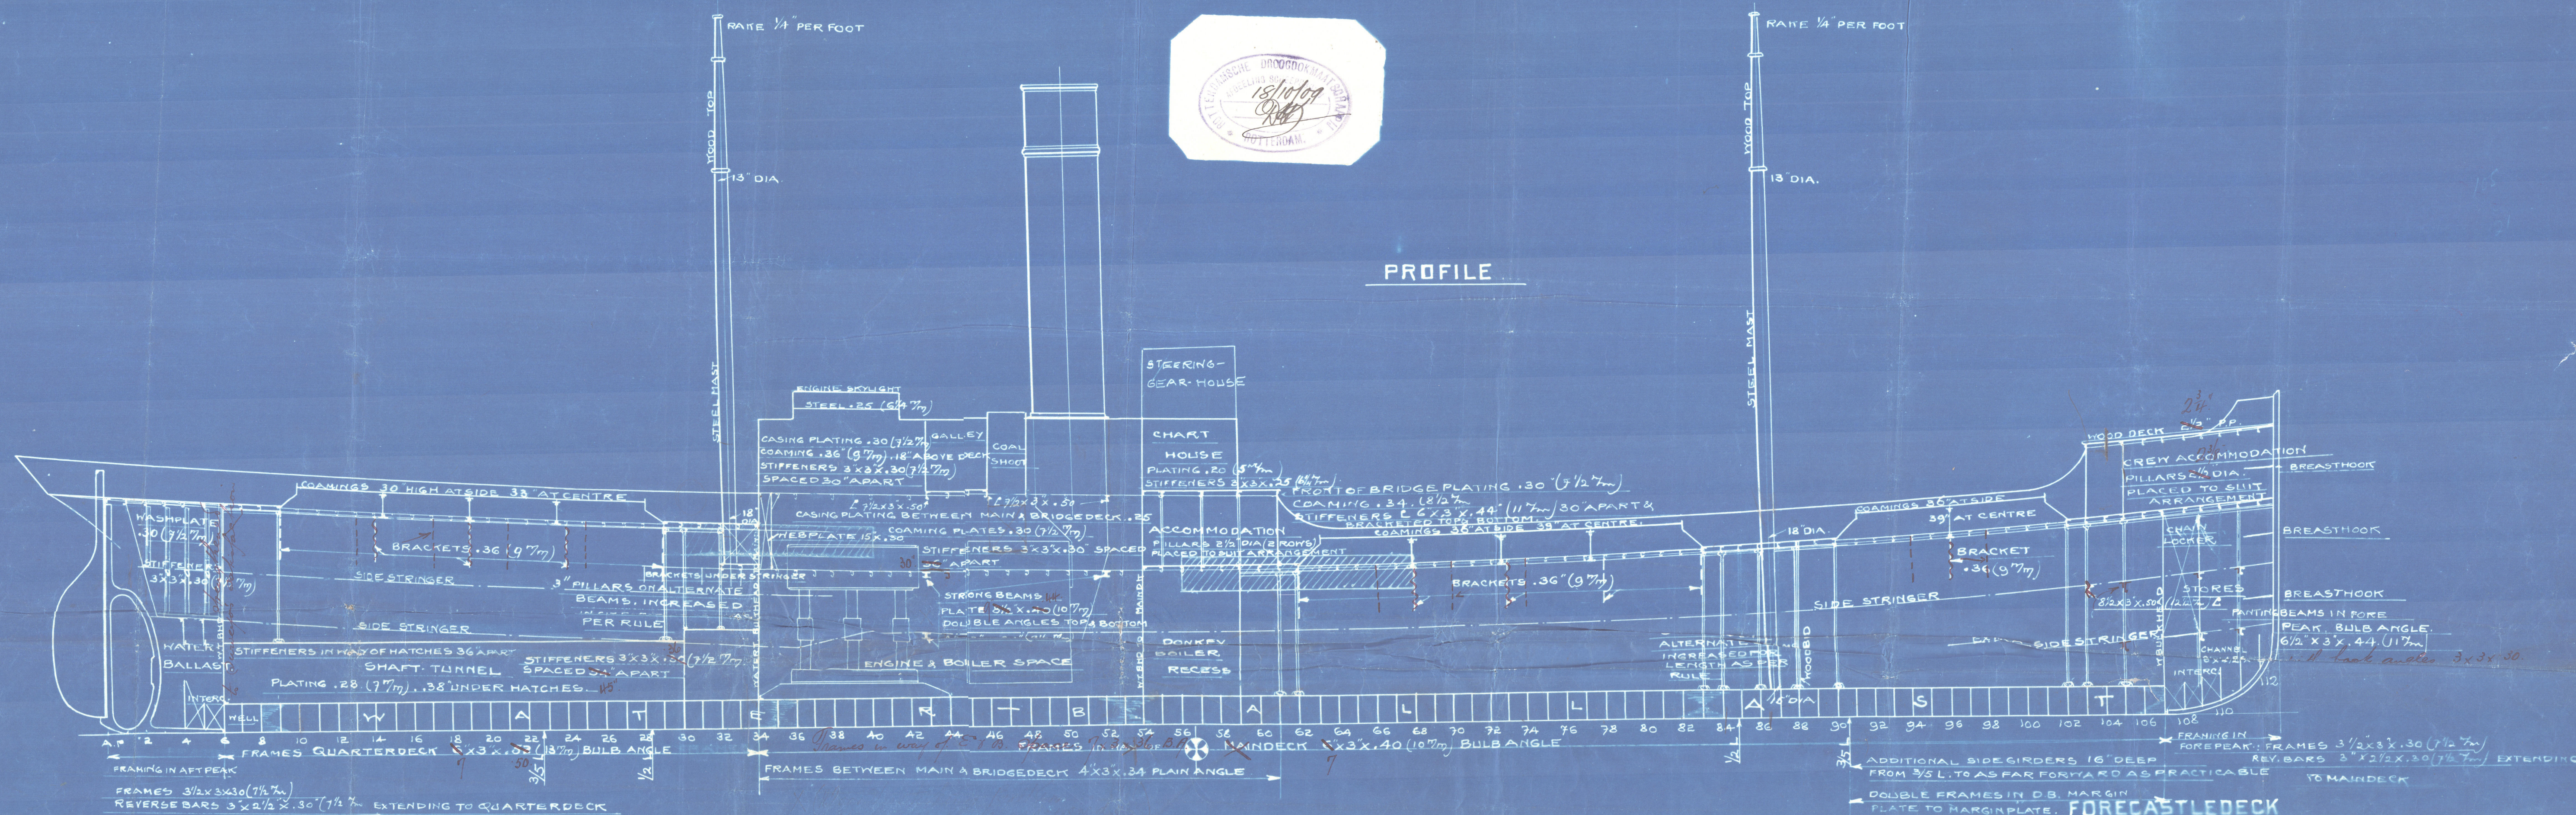


BRIDGEDECK

QUARTERDECK BEAMS $5\frac{1}{2} \times 3 \times .34$ BULB ANGLE $(8\frac{1}{2} \text{ } ^\circ \text{ } ^\circ \text{ } ^\circ)$
WHERE LESS THAN $\frac{2}{3}$ BEAM $5\frac{1}{2} \times 3 \times .34$ ANGLE $(8\frac{1}{2} \text{ } ^\circ \text{ } ^\circ \text{ } ^\circ)$
WHERE LESS THAN $\frac{1}{2}$ BEAM $5 \times 3 \times .34$ ANGLE $(8\frac{1}{2} \text{ } ^\circ \text{ } ^\circ \text{ } ^\circ)$
HALF BEAMS IN WAY OF HATCHES $5\frac{1}{2} \times 3 \times .34$ ANGLE $(8\frac{1}{2} \text{ } ^\circ \text{ } ^\circ \text{ } ^\circ)$

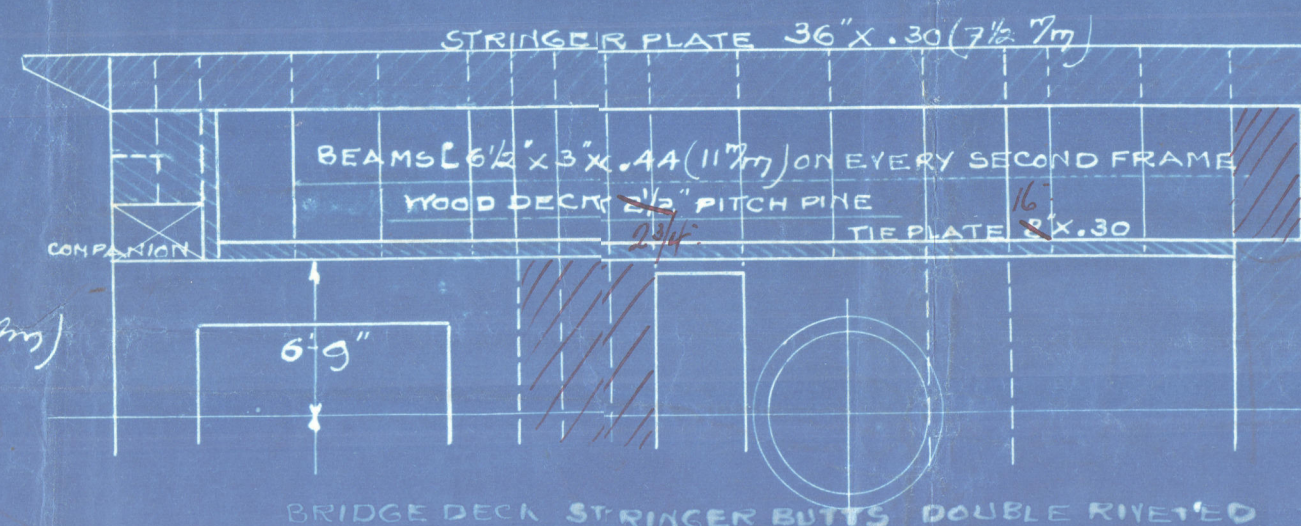


QUARTERDECK

MAIN DECK BEAMS $5\frac{1}{2} \times 3 \times .40$ BULB ANGLE
WHERE LESS THAN $\frac{2}{3}$ BEAM $5\frac{1}{2} \times 3 \times .40$ ANGLE $(10 \text{ } ^\circ \text{ } ^\circ \text{ } ^\circ)$
WHERE LESS THAN $\frac{1}{2}$ BEAM $5\frac{1}{2} \times 3 \times .34$ ANGLE $(8\frac{1}{2} \text{ } ^\circ \text{ } ^\circ \text{ } ^\circ)$
HALF BEAMS IN WAY OF HATCHES $5\frac{1}{2} \times 3 \times .34$ ANGLE $(8\frac{1}{2} \text{ } ^\circ \text{ } ^\circ \text{ } ^\circ)$

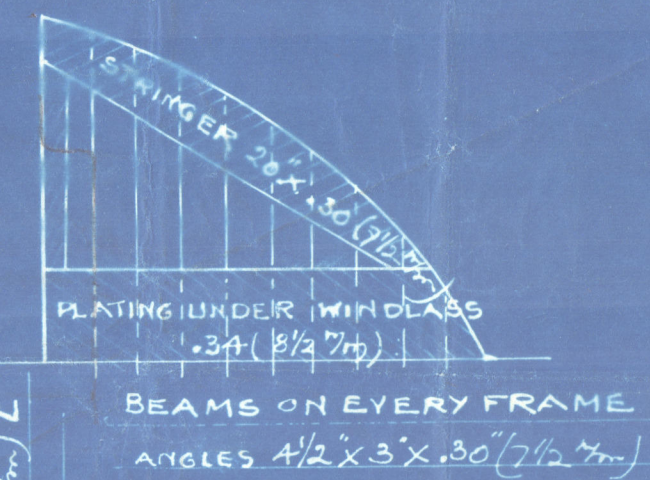

MAINDECK

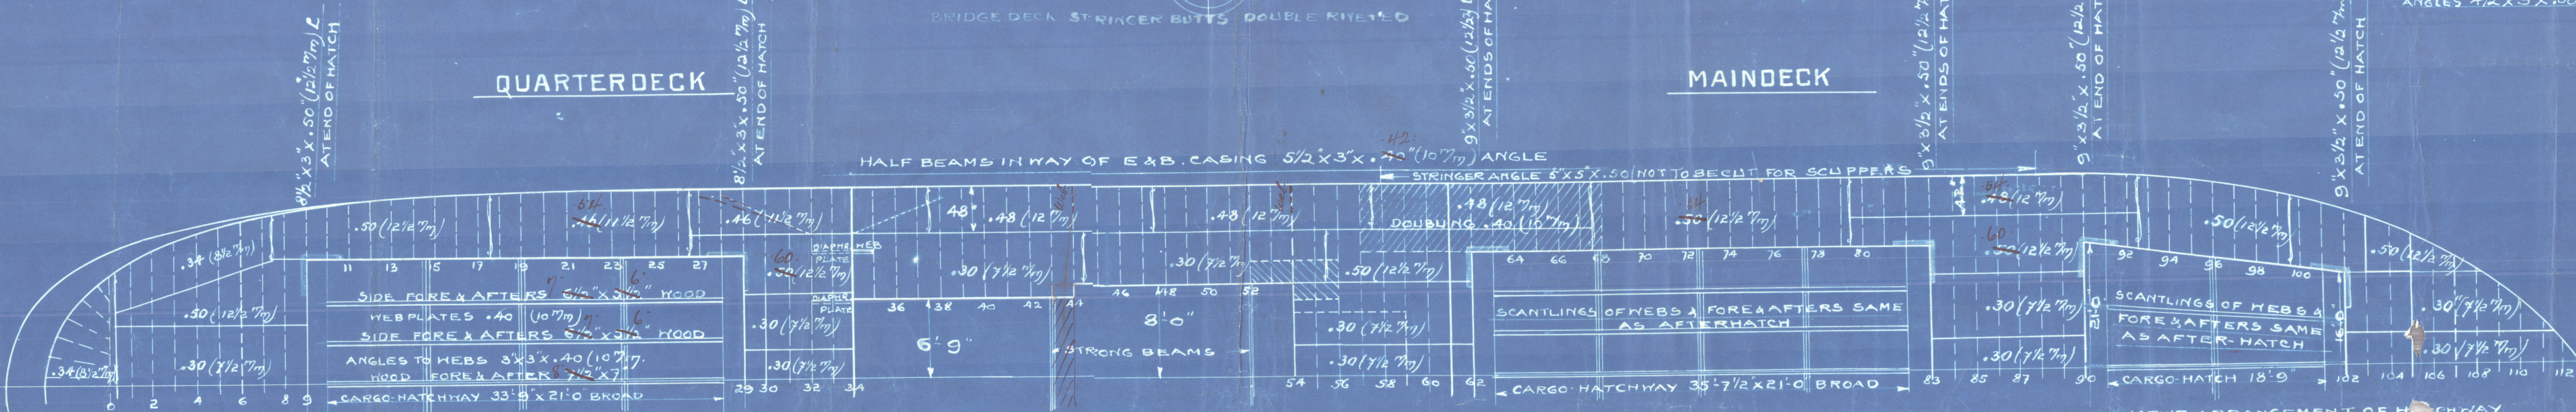

ALTERNATIVE ARRANGEMENT OF HATCHWAY
6 WEBPLATES $23 \times .40$ $(10 \text{ } ^\circ \text{ } ^\circ \text{ } ^\circ)$ AT CENTRE
DOUBLE ANGLES TOP & BOTTOM $4 \times 3 \times .40$ $(10 \text{ } ^\circ \text{ } ^\circ \text{ } ^\circ)$
NO HOOD FORE & AFTERS - HATCHES LAID LONGITUDINALLY.

BUTTS OF MAIN & QUARTERDECK PLATING
LAPPED & DOUBLE RIV. FOR $\frac{1}{2}$ LENGTH
SINGLE AT ENDS.

ALTERNATIVE ARRANGEMENT
OF HATCHWAY SAME AS
AFTER HATCH

ALTERNATIVE ARRANGEMENT OF HATCHWAY
3 WEBPLATES $23 \times .40$ $(10 \text{ } ^\circ \text{ } ^\circ \text{ } ^\circ)$ AT CENTRE
DOUBLE ANGLES TOP & BOTTOM $4 \times 3 \times .40$ $(10 \text{ } ^\circ \text{ } ^\circ \text{ } ^\circ)$
NO HOOD FORE & AFTERS - HATCHES LAID LONGITUDINALLY

27 10/09

Profile -


RETAIN



© 2020

W1101-0108

Lloyd's Register
Foundation

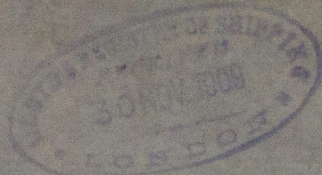

Droogdoh Maels
no 24


profile

S.P. Maardrecht "

Profile Plan.

Part. of. P. Tolam

repert. no. 6655^a

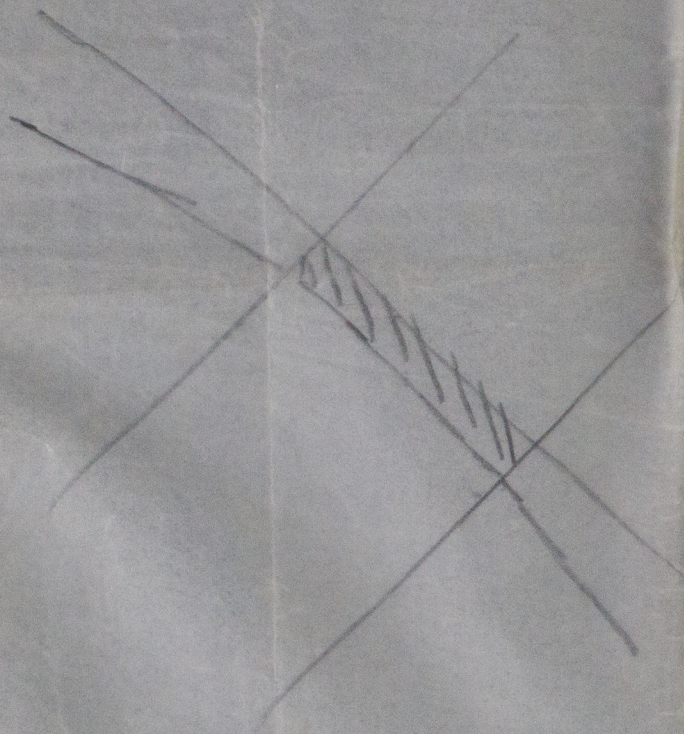

W1101-0108

W1101-0108



© 2020

Lloyd's Register
Foundation