

Midship Section of No 205 T.S.S.

448-0-56-1-33-5 Mm.

To Class 100 A1. Three Deck Rule.

Scale 2 inch = 1 foot.

18.5.03
30.5.03

7.6.03


2.7.03

6.9.03

28.8.03

11.9.03

8.1.04

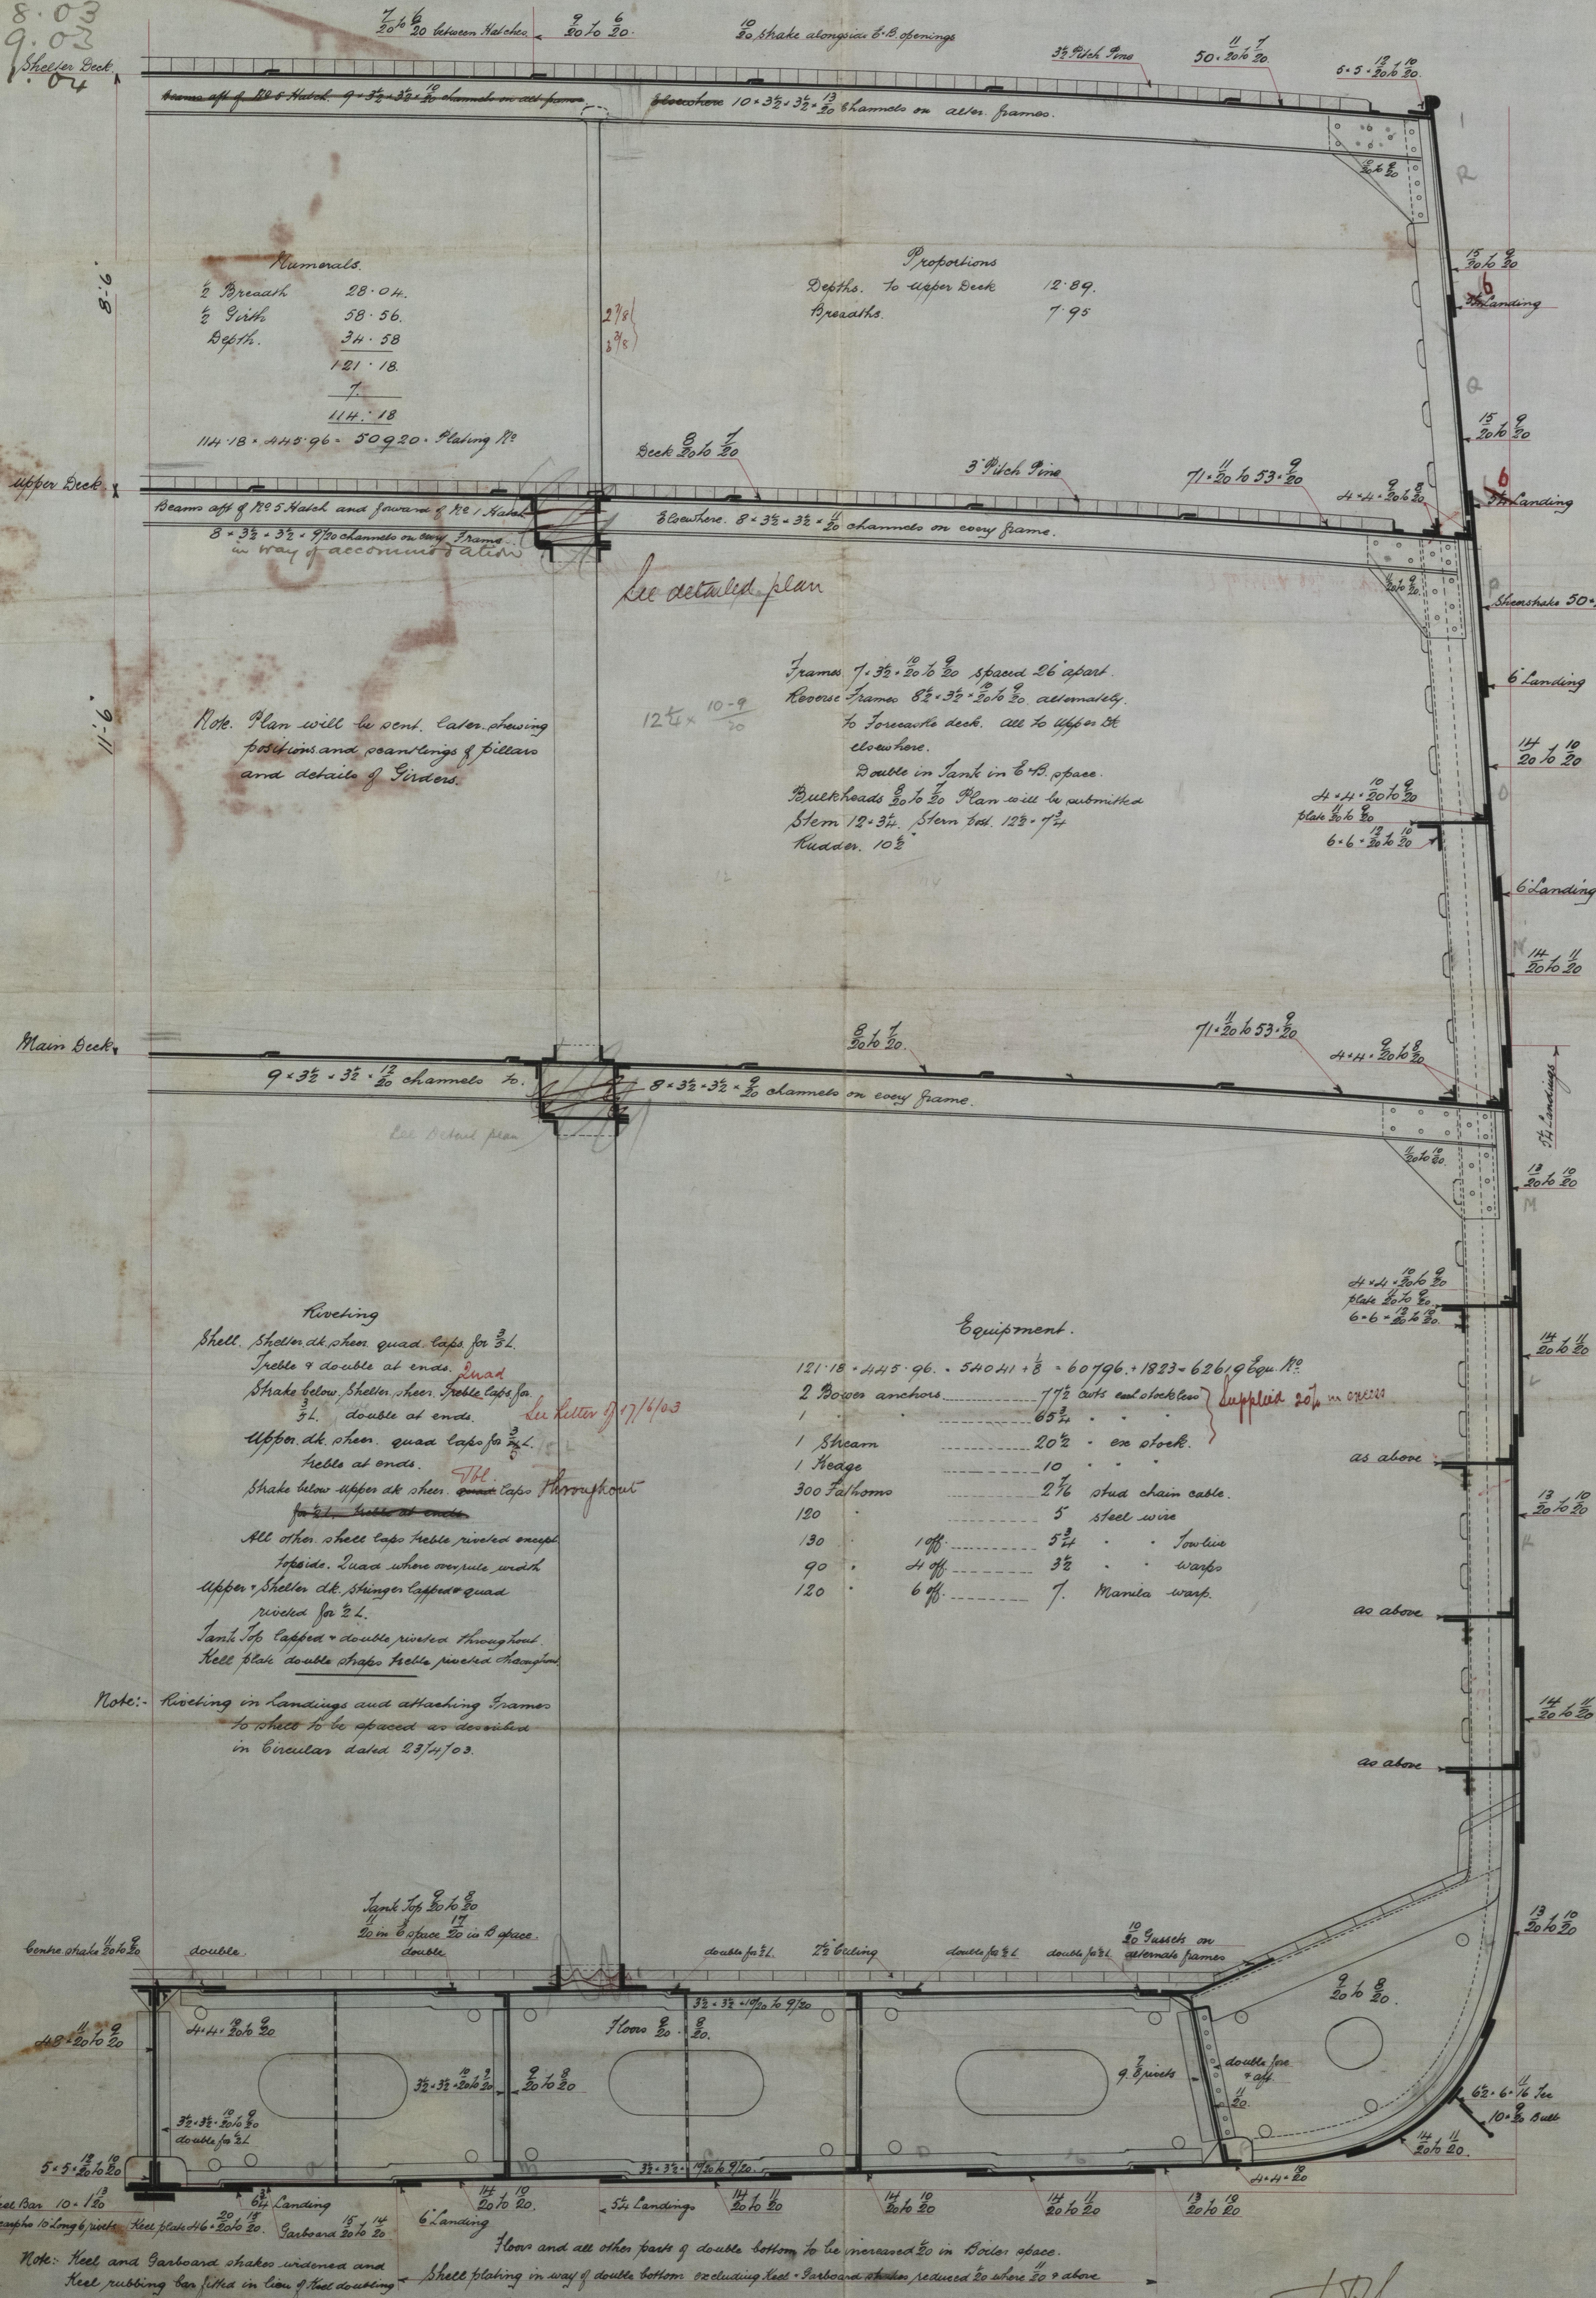

Messrs Workman Clark & Co

T.S.S. No 205

Midship Section

(Amended)

T.S.S. Matilda

Bel 0689



© 2021

Lloyd's Register
Foundation

W1103-0194-1