


18.5.03  
30.5.03  
17.6.03  
2.7.03  
6.7.03  
28.8.03  
14.9.03  
8.1.04

Longitudinal Section N° 205 T.S.S.  
Scale 1/4 Inch = 1 Foot

 

are additional W. Y. Frame is shown in Bulkhead space  
are line of beam across top of Bulkhead at Main Deck

Handwritten signature and date: 31/12/03



Mess<sup>rs</sup> Workman Clark & Co<sup>ys</sup>


T. S. S. No 205

Longitudinal Section

(Amended)

Matatua

Ref 5684

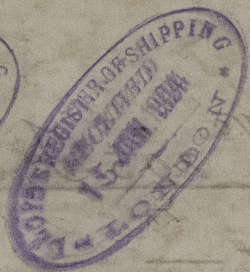

© 2021

Lloyd's Register  
Foundation

W1103-019472