

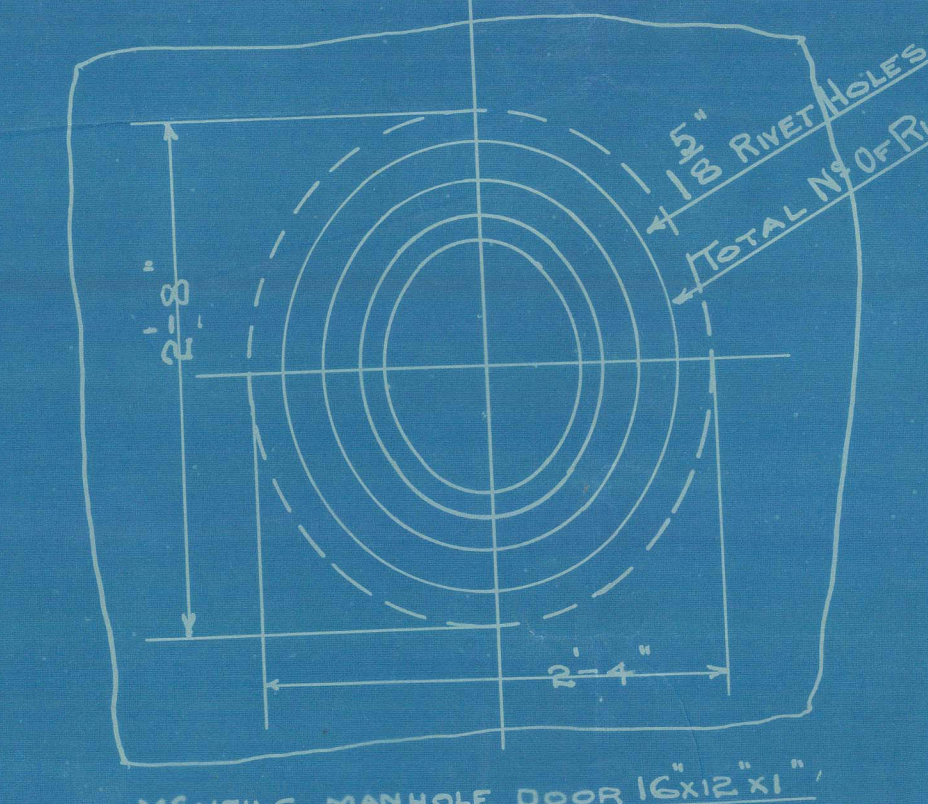
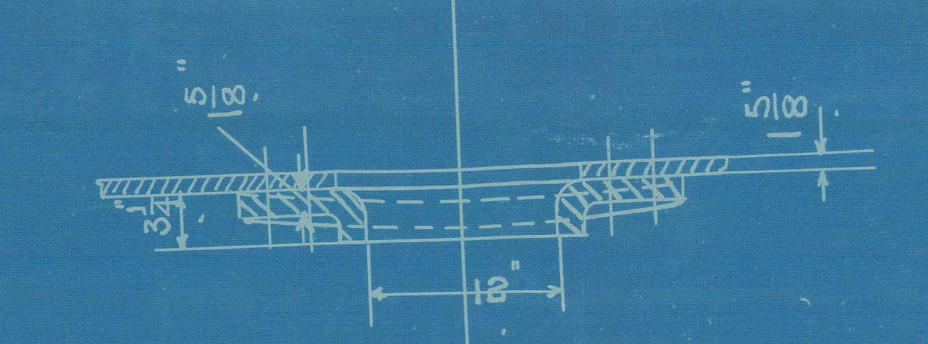
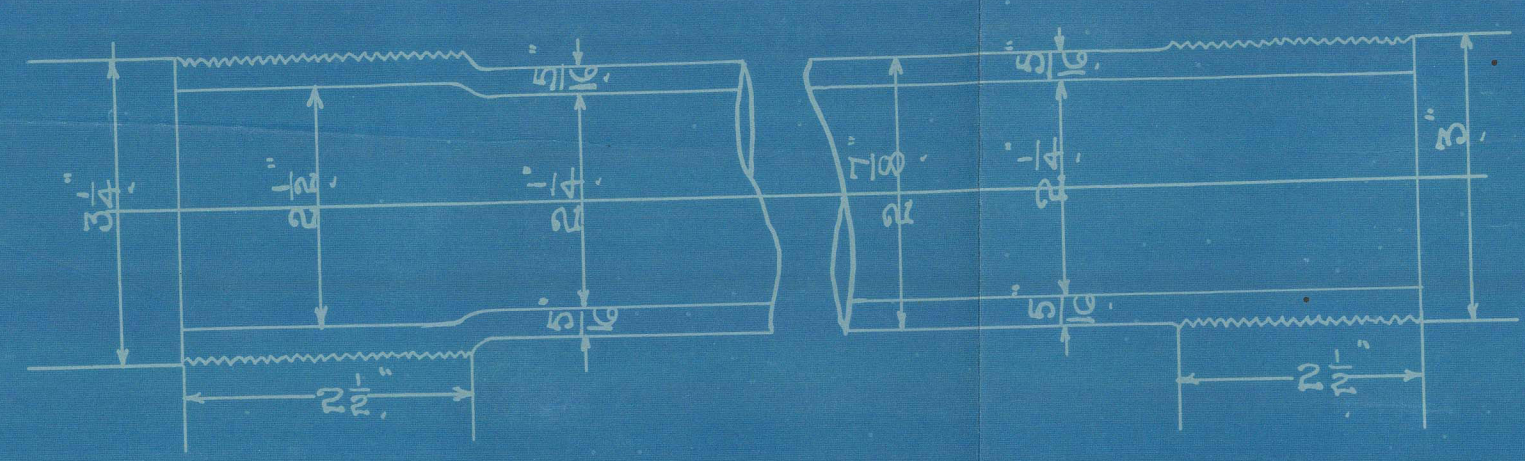
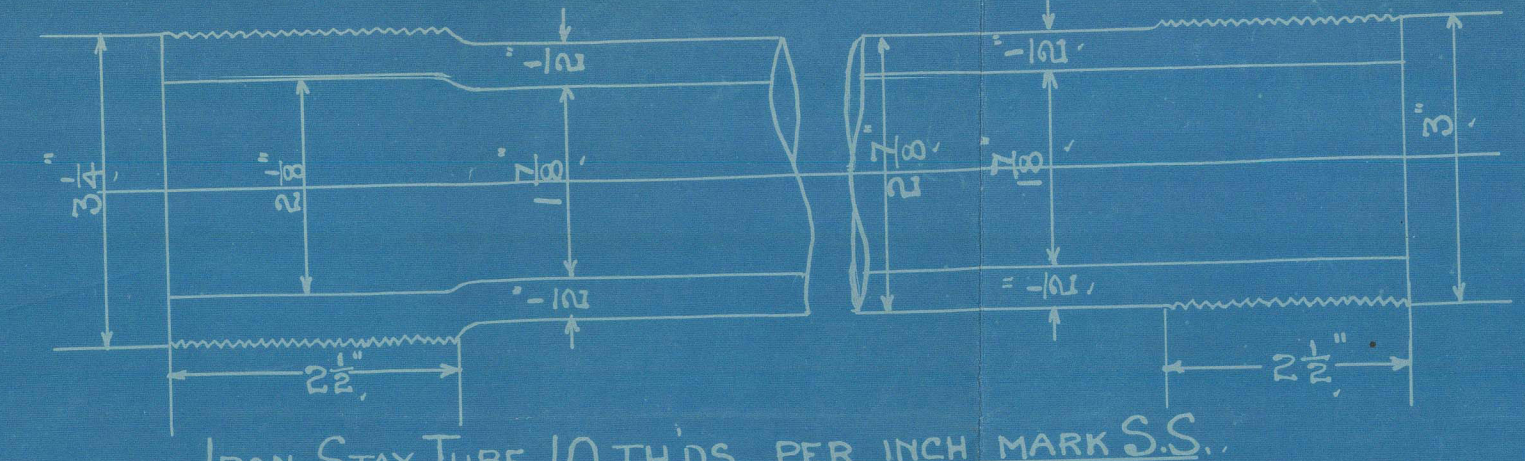
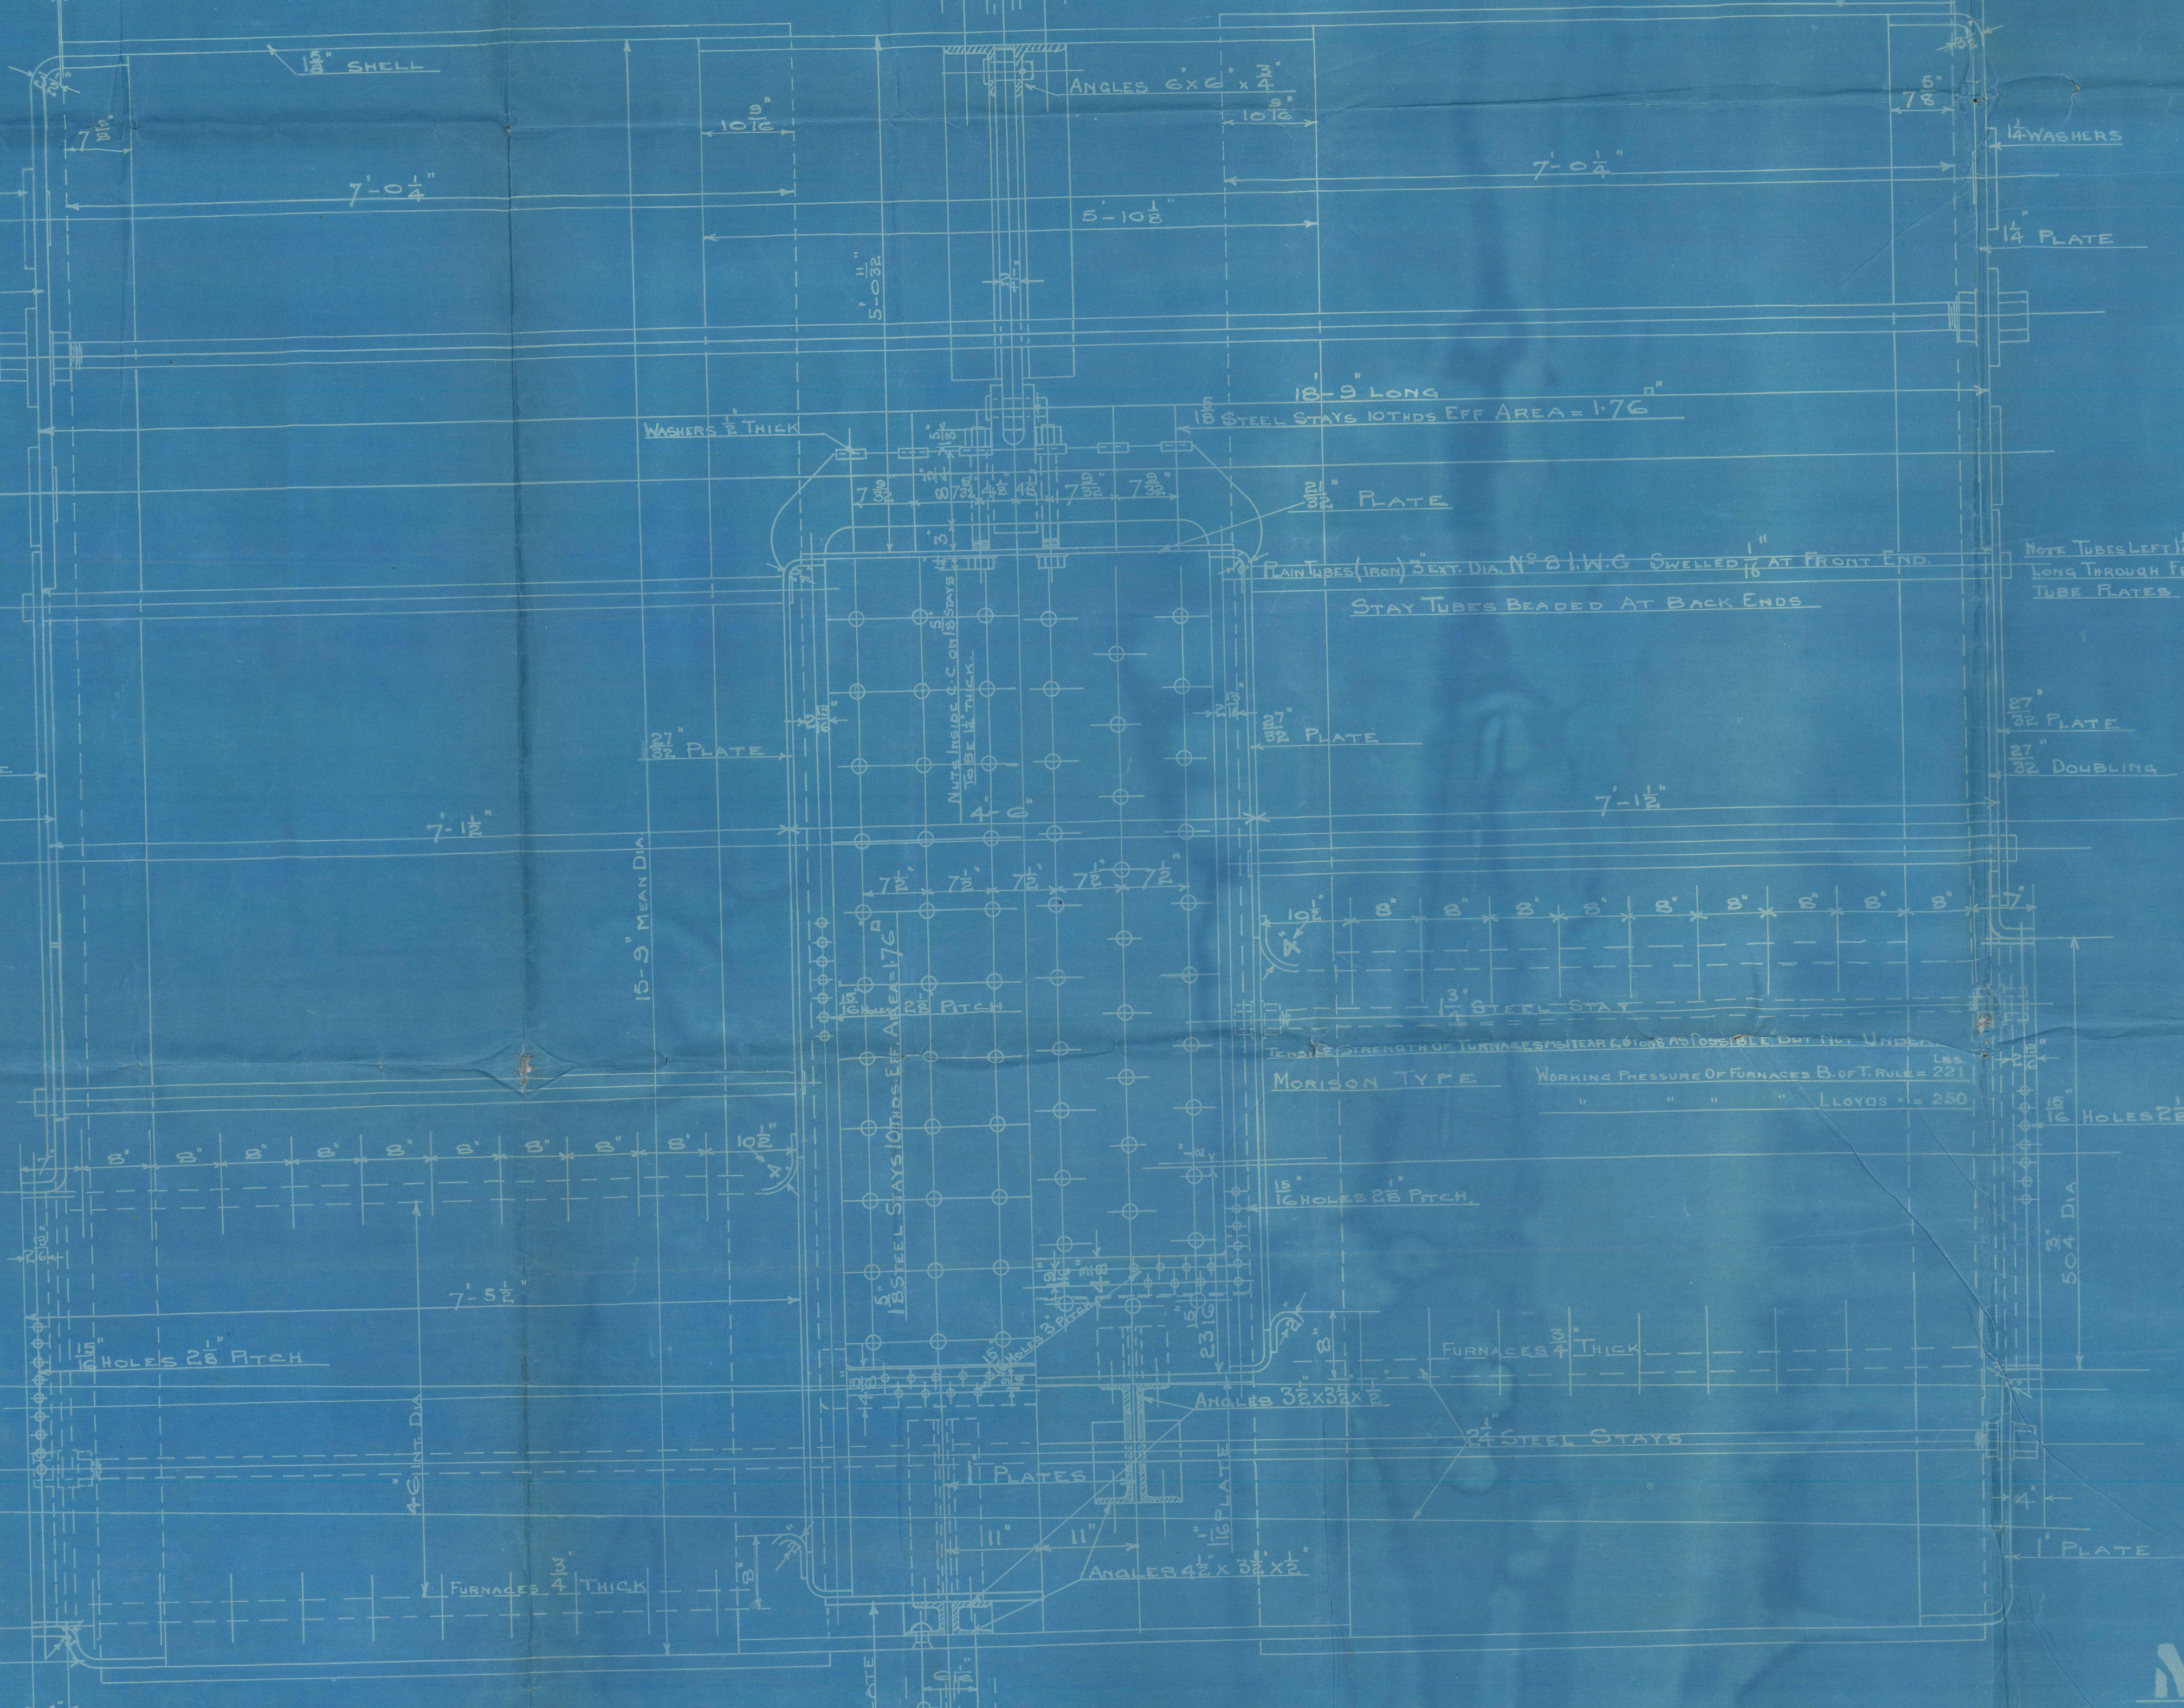
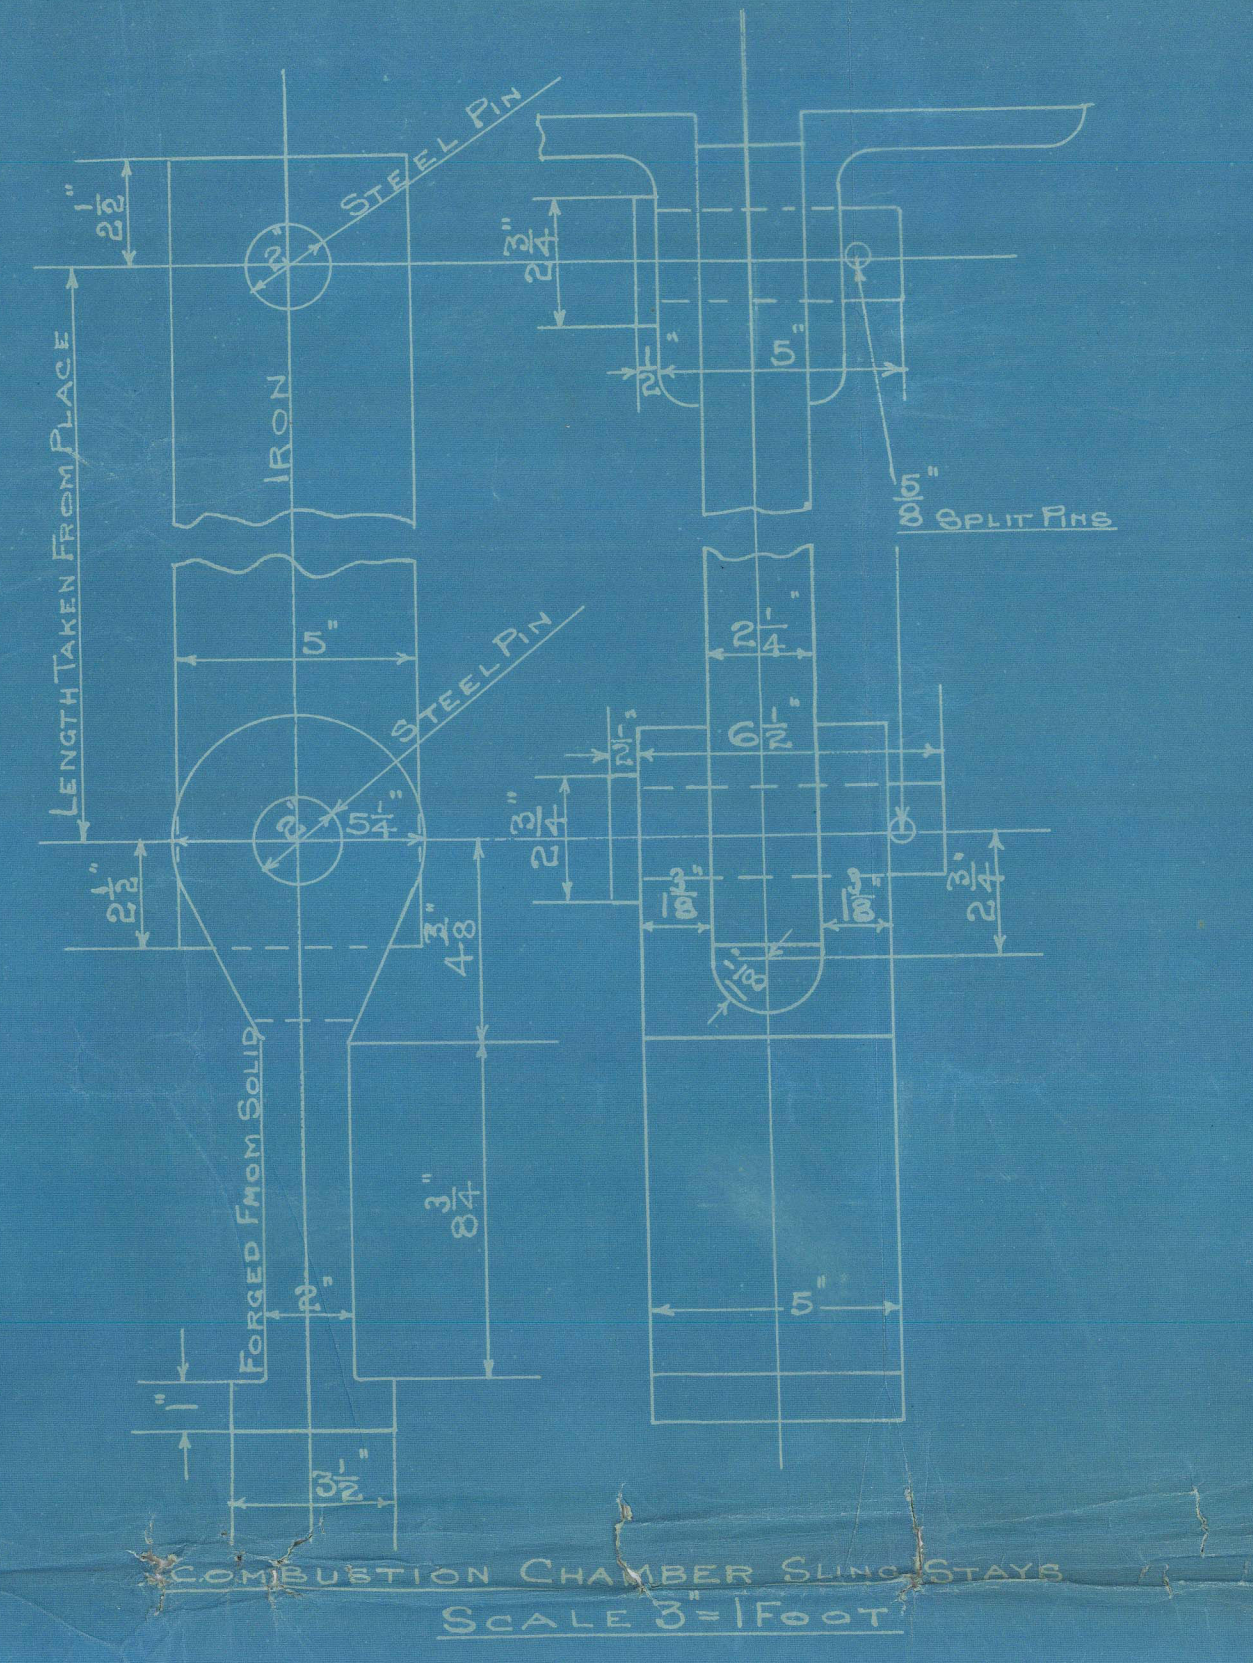


7550
 4/4/03
 13/4/03
 26.6.03

26.6.03

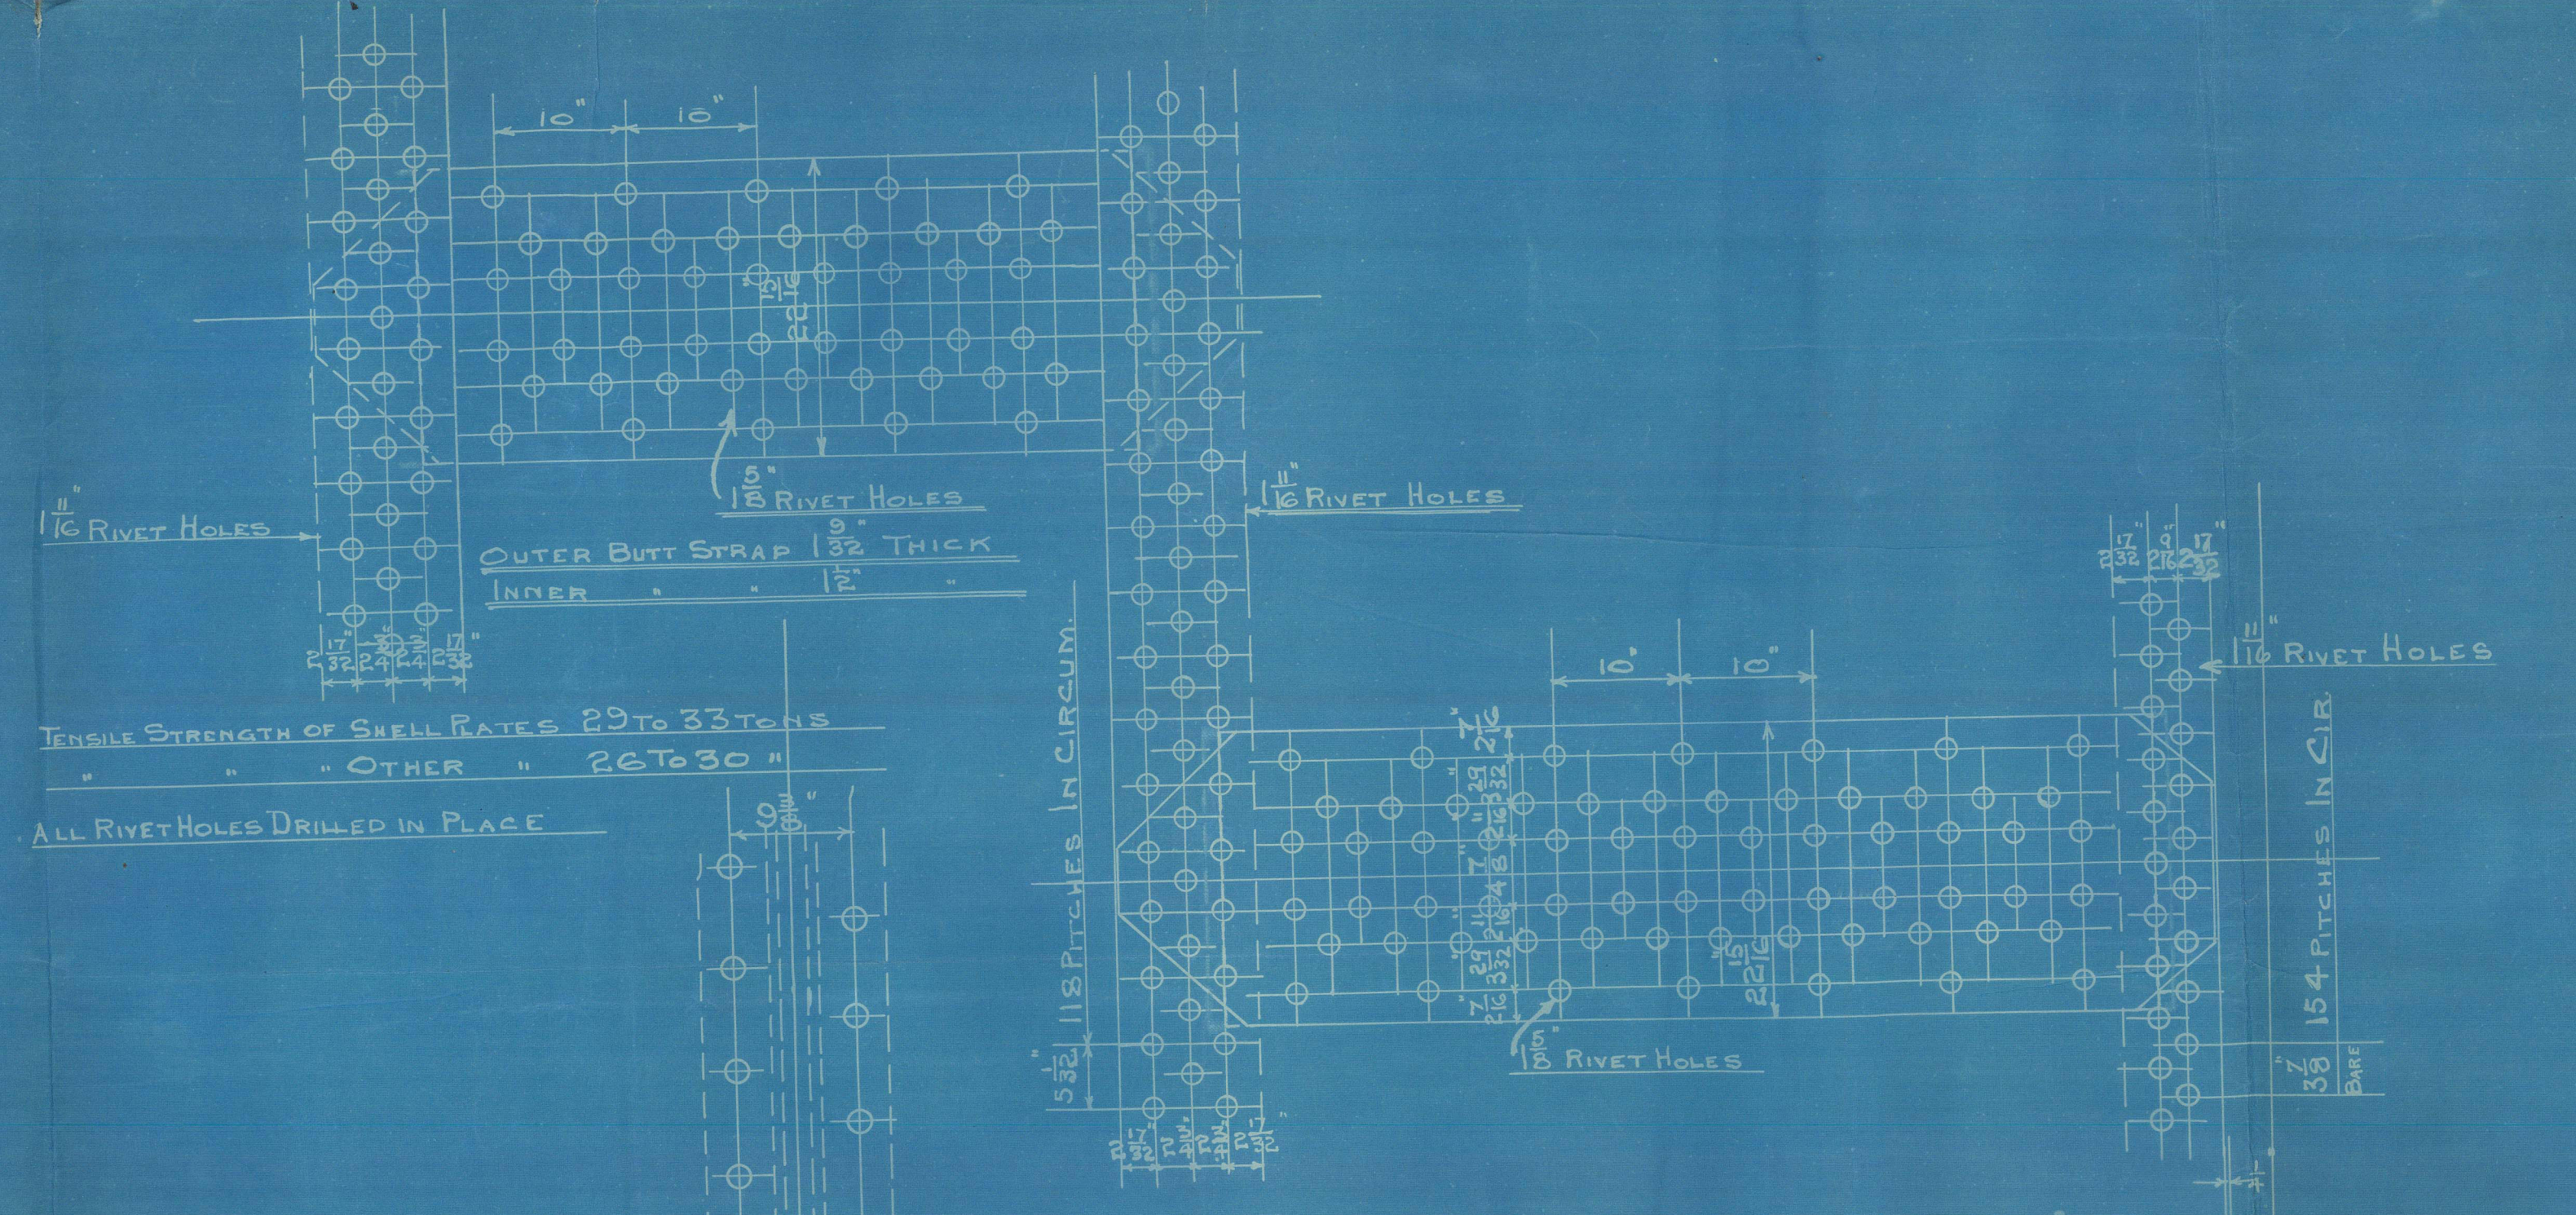

STEAM SPACE STAYS 3/4" DIA 6 THDS EFF AREA = 7.239

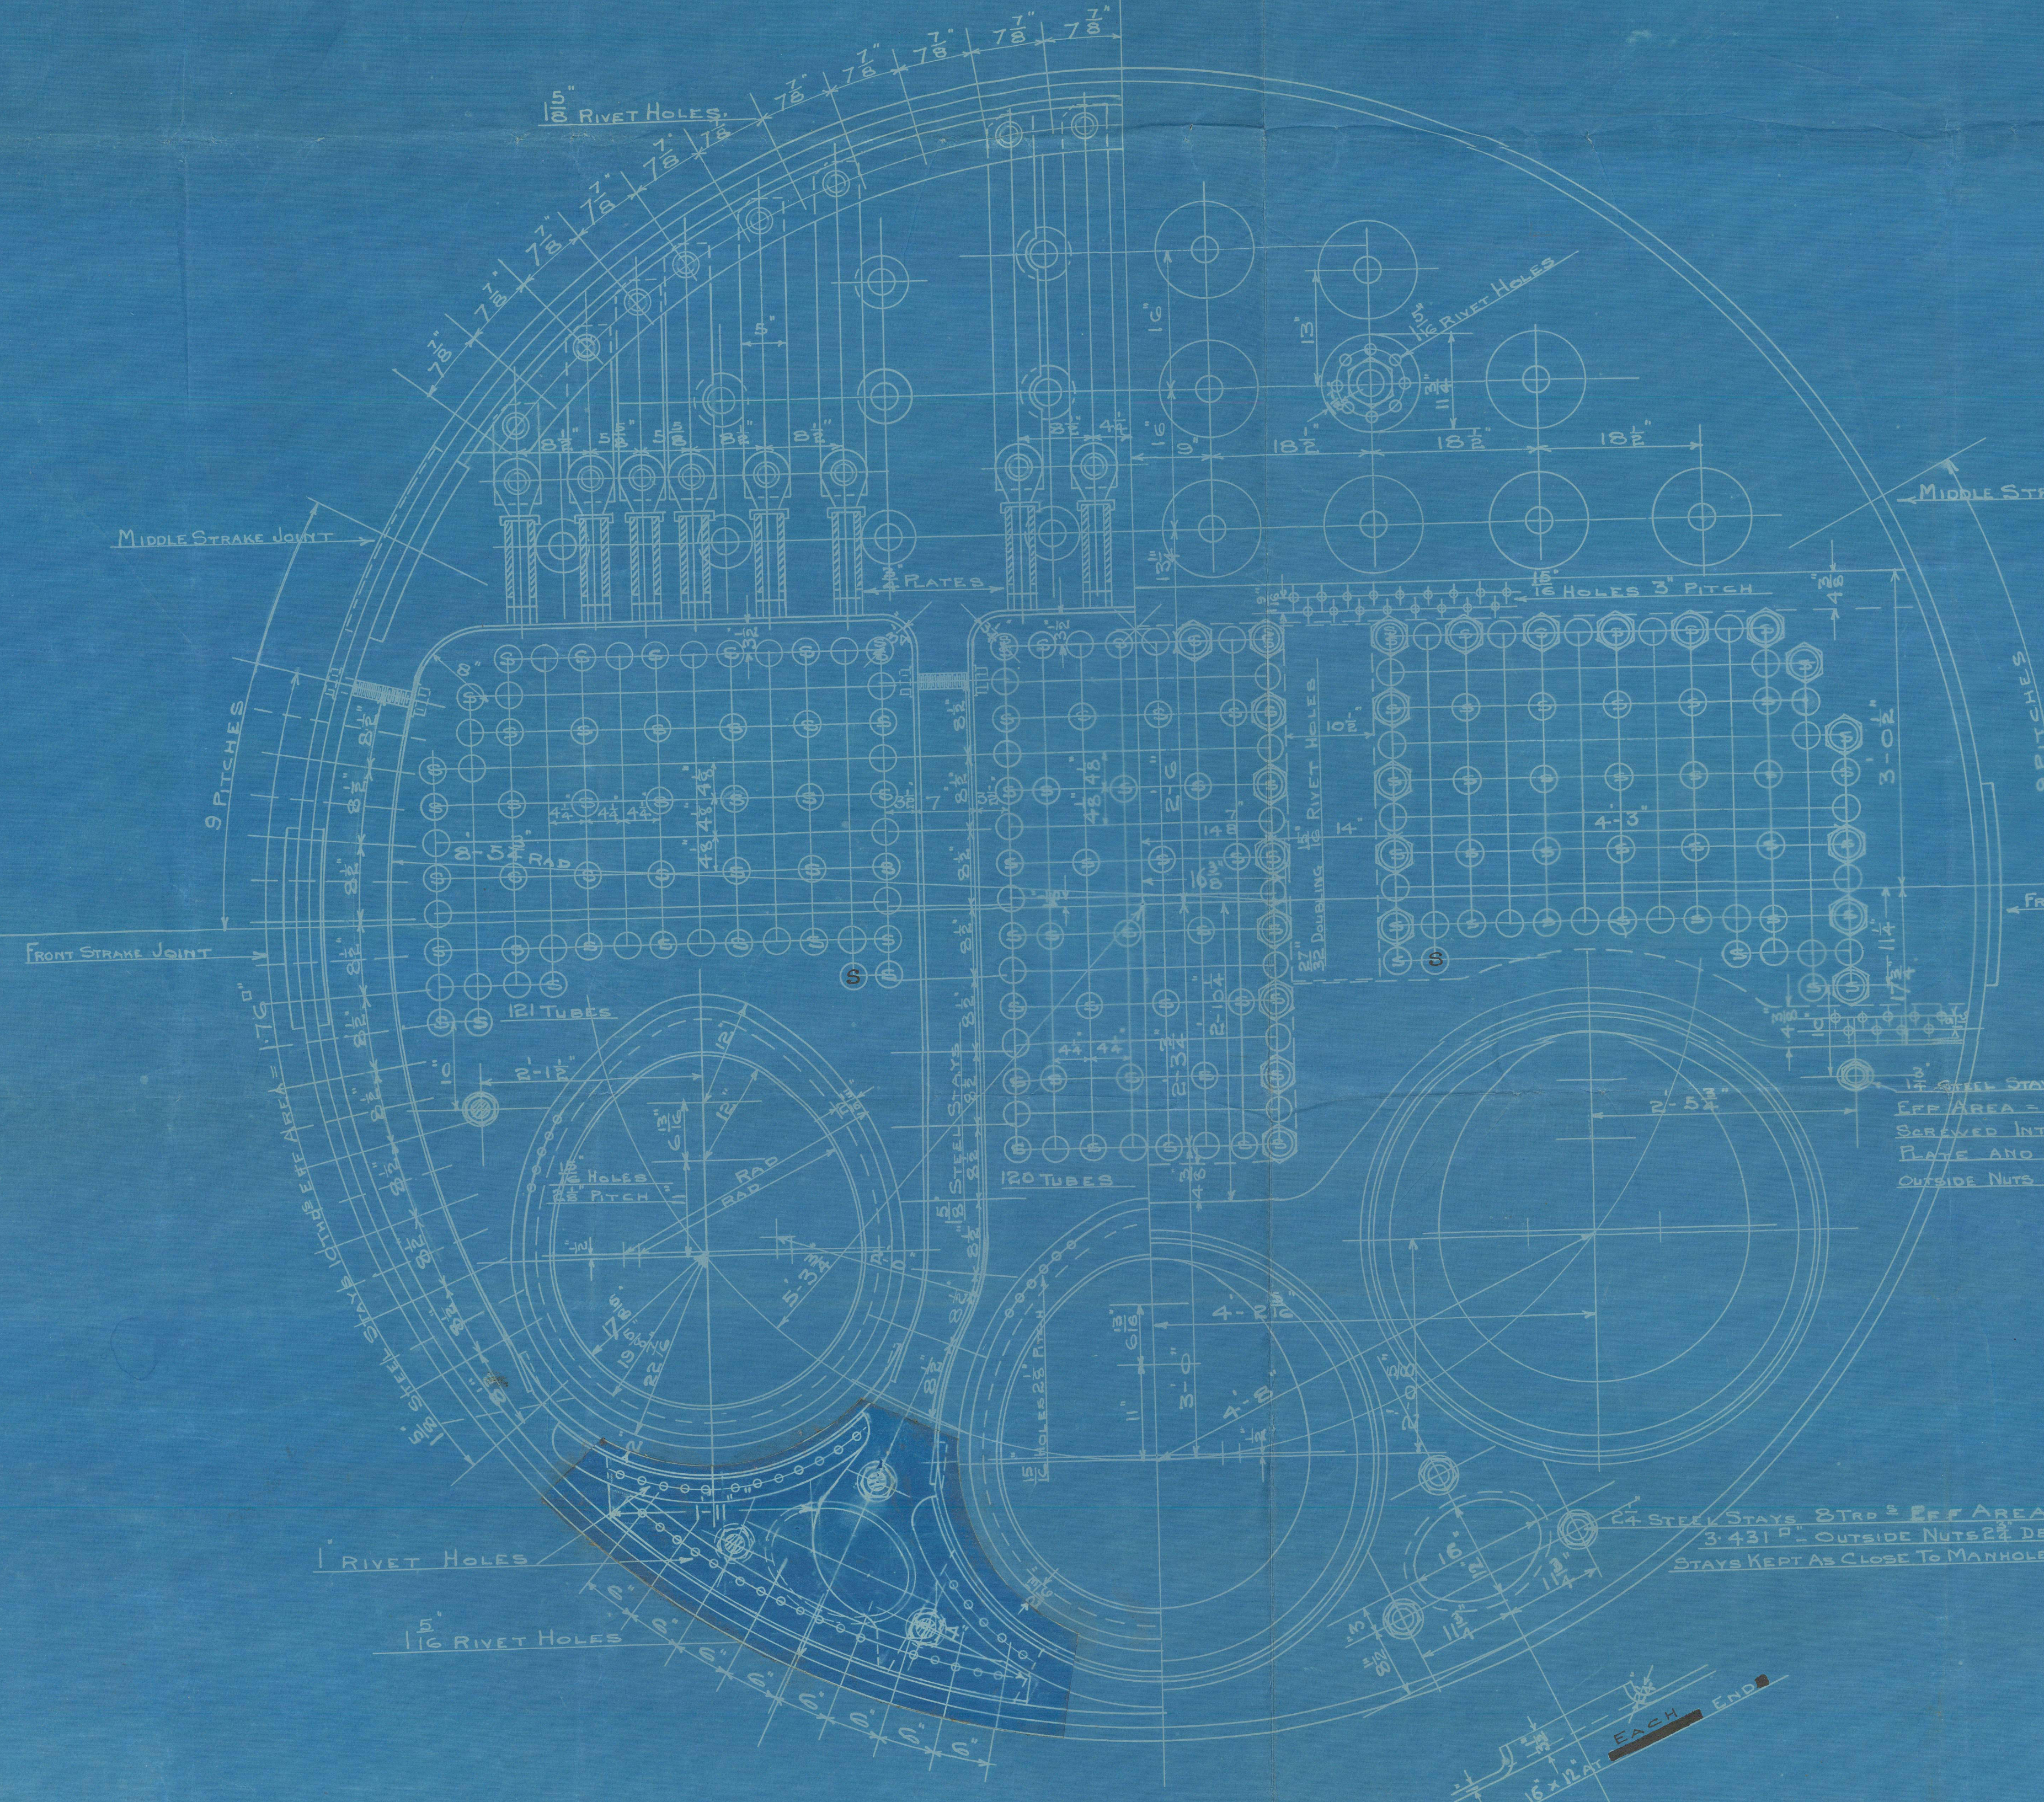

MAIN BOILER 20FF No 205

15'-9" MEAN DIA. x 18'-9" LONG x 205 W. P. PER
 T. P. AND LLOYD'S SURVEYS
 ALL MATERIAL STEEL EXCEPT TUBES AND
 VERTICAL SLING STAYS WHICH ARE IRON.

Passed B.O.T.
 LLOYD'S

SCALE 1" = 1' FOOT

For Enclosure to
 Lloyd's

MAIN BOILER 20FF No. 205.

15" x 9" MAN DIA. x 18" x 25" W. P. PER "A"
IN. P. B. OF T. AND LLOYD'S SURVEYS
ALL MATERIAL STEEL ESKERT TUBES AND
VERTICAL SLING STAYS WHICH ARE IRON.



25 JUN. 05

For Enclosure to

Lloyd's

W1103-0194 1/2

Ref ast N^o 5689
Wokman Clark & Co
L.S.S. 205
Main Boiled
L.S.S. "Matatua"

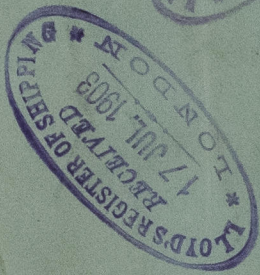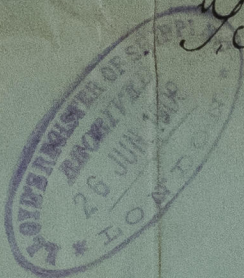

RETAIN



© 2021

Lloyd's Register
Foundation
W1103-0194 1/2