


PROFILE AND DECK PLAN.

Nº 219.

Scale 1/8" = 1 foot.

198-01
18-10-01

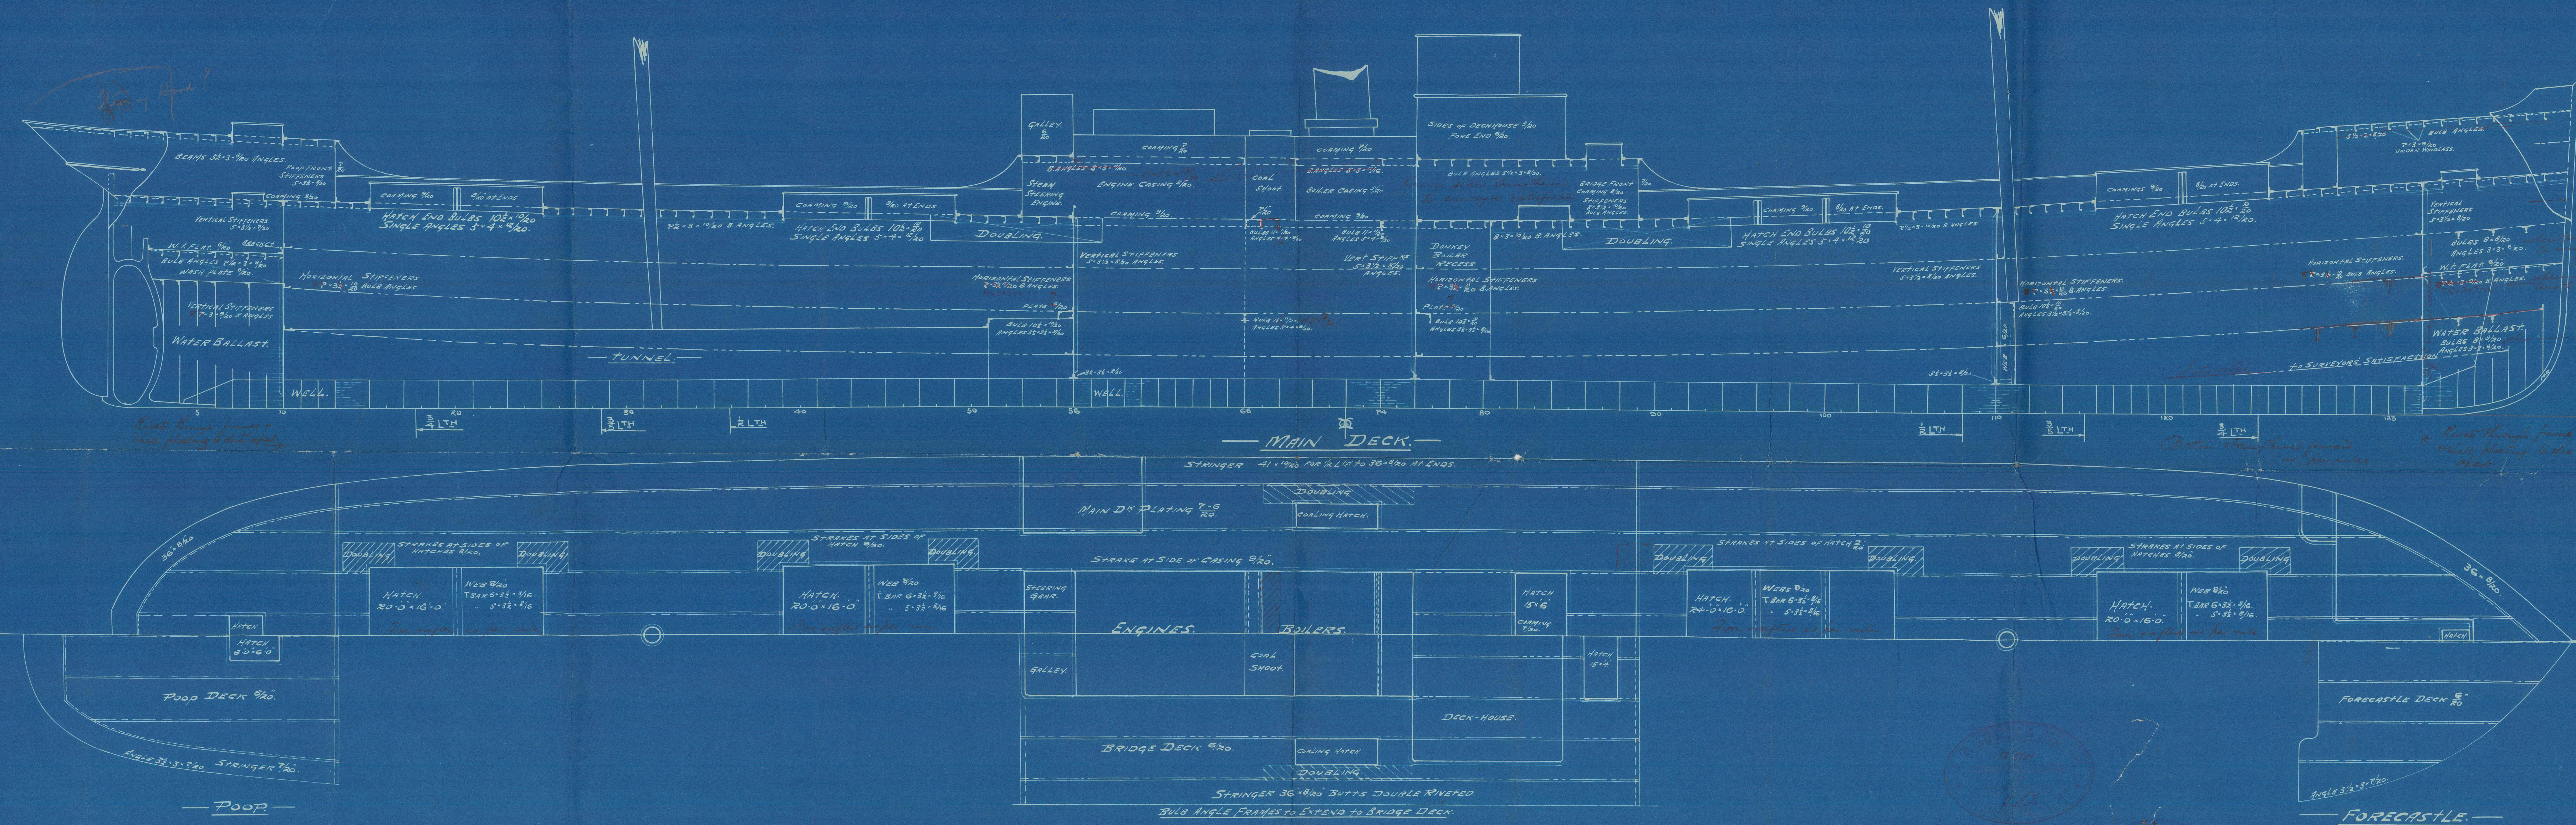


Messrs P. P. Austin & Co


Profile

S.S. "No 219"

SS "also"

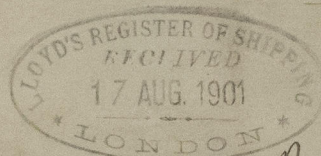

Sunderland. No 20985.

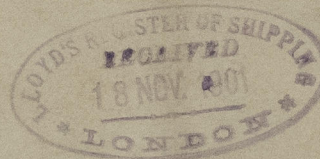

RETAIN

See Letter.

= 19-8-01



© 2021

Lloyd's Register
Foundation

W1103-0204