

Hatchway Coamings to be
24" above wood deck.

Continuous Stringers
13' x 6'

No deck laid

$$744 \times 14$$

BREADTH MOULDED 37'-5"

Mid. section.
Mississippi. P.B.
Cooper
Bolton, Miss.

no 1.


Flying Cloud

RECEIVED



© 2020

Lloyd's Register
W104 0073
Foundation

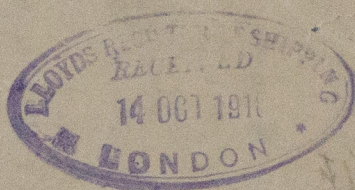

© 2020

W1104-50073
Lloyd's Register
Foundation