

Lloyd's Register of Shipping.

(Report on Vessel No. _____ Port _____)

No. 2869

SHIP FORGINGS OR CASTINGS.

I have to report that the undermentioned Iron ~~or Steel~~ Forgings ~~or Castings~~, manufactured by J. Carmichael & Co. Ltd. of Dundee for the Vessel No. 592, being built by A. Hall & Co. Ltd. of Aberdeen have been inspected by me as set forth below and found to be, so far as can be seen, sound.

Mark on Forgings or Castings.


Lloyd's
No. 650
J.E.S.

J. Seller.

Dundee

	STERN FRAME.	RUDDER FRAME.	STEM.
Material	Scrap Iron		
How made	Forged		
Dimensions	5 1/2 x 2 1/2 + 5 1/2 x 2 1/2		
Progress on Inspection	Start to finish		
Date when Inspected	9-5-24 / 26-5-24		
CASTINGS.			
Tests on Standard Test Pieces.			
Tensile Test—			
Tons per square inch			
Extension per cent.			
Cold Bending Test—			
Angle before fracture			
Drop Test—			
Height from ground			
Hammering Test—			
If made according to Rules and found satisfactory ...			

SKETCHES OF FRAMES SHOWING POSITION AND DESCRIPTION OF WELDS OF FORGINGS.

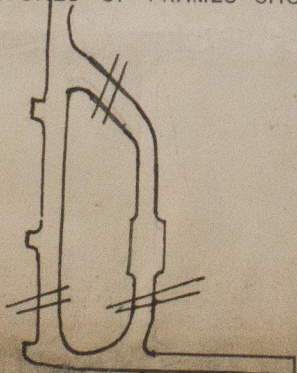

> welds

W1104-0313

Fee (if any chargeable) £

To be paid at

* If of Iron, state whether scrap or puddled Iron. If of Steel, state whether made on the Open Hearth process.



© 2020

Lloyd's Register
Foundation