


Yard Nos 430-439  
Scale 1" = One Foot



## SECTION AT FRAME 12

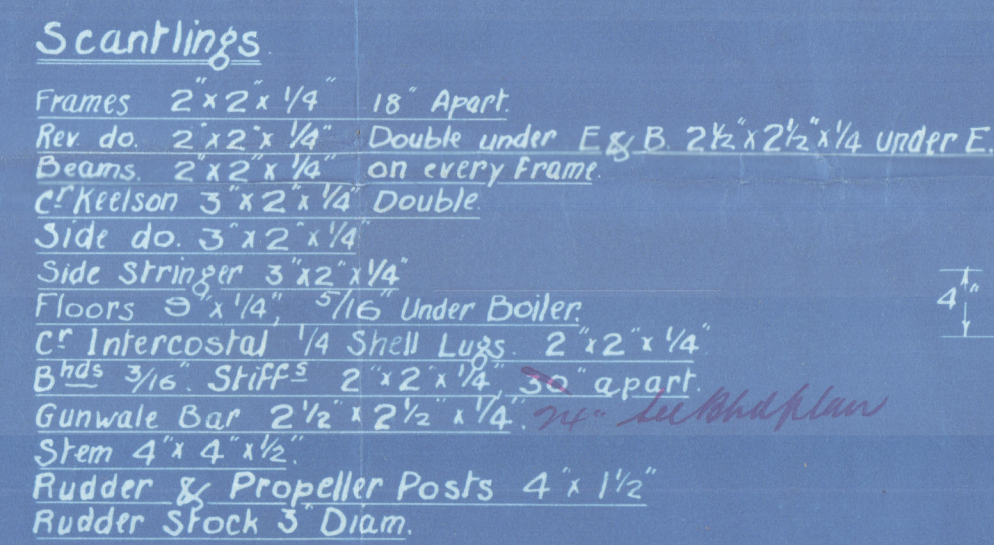

Hull Section  
of Cradock L

N<sup>o</sup> 430

S. S. "C. C. Mengel Jr."

LIVERPOOL:

Report No. 90507.



© 2020

Lloyd's Register  
Foundation 4-04/6