

S.S. 'PROMONTORE' ex (VILLE DE BELFORT)

SCANTLING NUMBER

Depth	17' 50
Breadth	31' 00
1st Number	48' 50
Length	215' 00
2nd Number	10427' 50
Length to depth	12' 20
Depth of hold	15' 40
Stem	6 1/2 x 2
Rudder post	5 3/4 x 4 3/4
Stern post	6 1/2 x 4 3/4
Rudder stock	6
Dia of pintle	3
Single plate rudder	62

Loadings 36" above deck x 50 sides loads.
 Webs. No. 1. 16' 10" x 14" 1 web. 8' 8"
 2 26' 0" x 14" 2 8' 8"
 3 24' 2" x 14" 2 8' 8"
 I 10 x 6 x 6 x .44 .68"
 3 F x 41 on each side
 Centre 8 x 7 Cross 2 1/2
 sides 7 x 6


N° 38

MIDSHIP - SECTION

SCALE 1/2 IN TO 1 FT

PRINCIPAL DIMENSIONS

Length B.P.	215' 0"
Breadth moulded	31' 0"
Depth moulded	17' 6"
Bridge deck	48' 0"
Forecastle deck	28' 0"

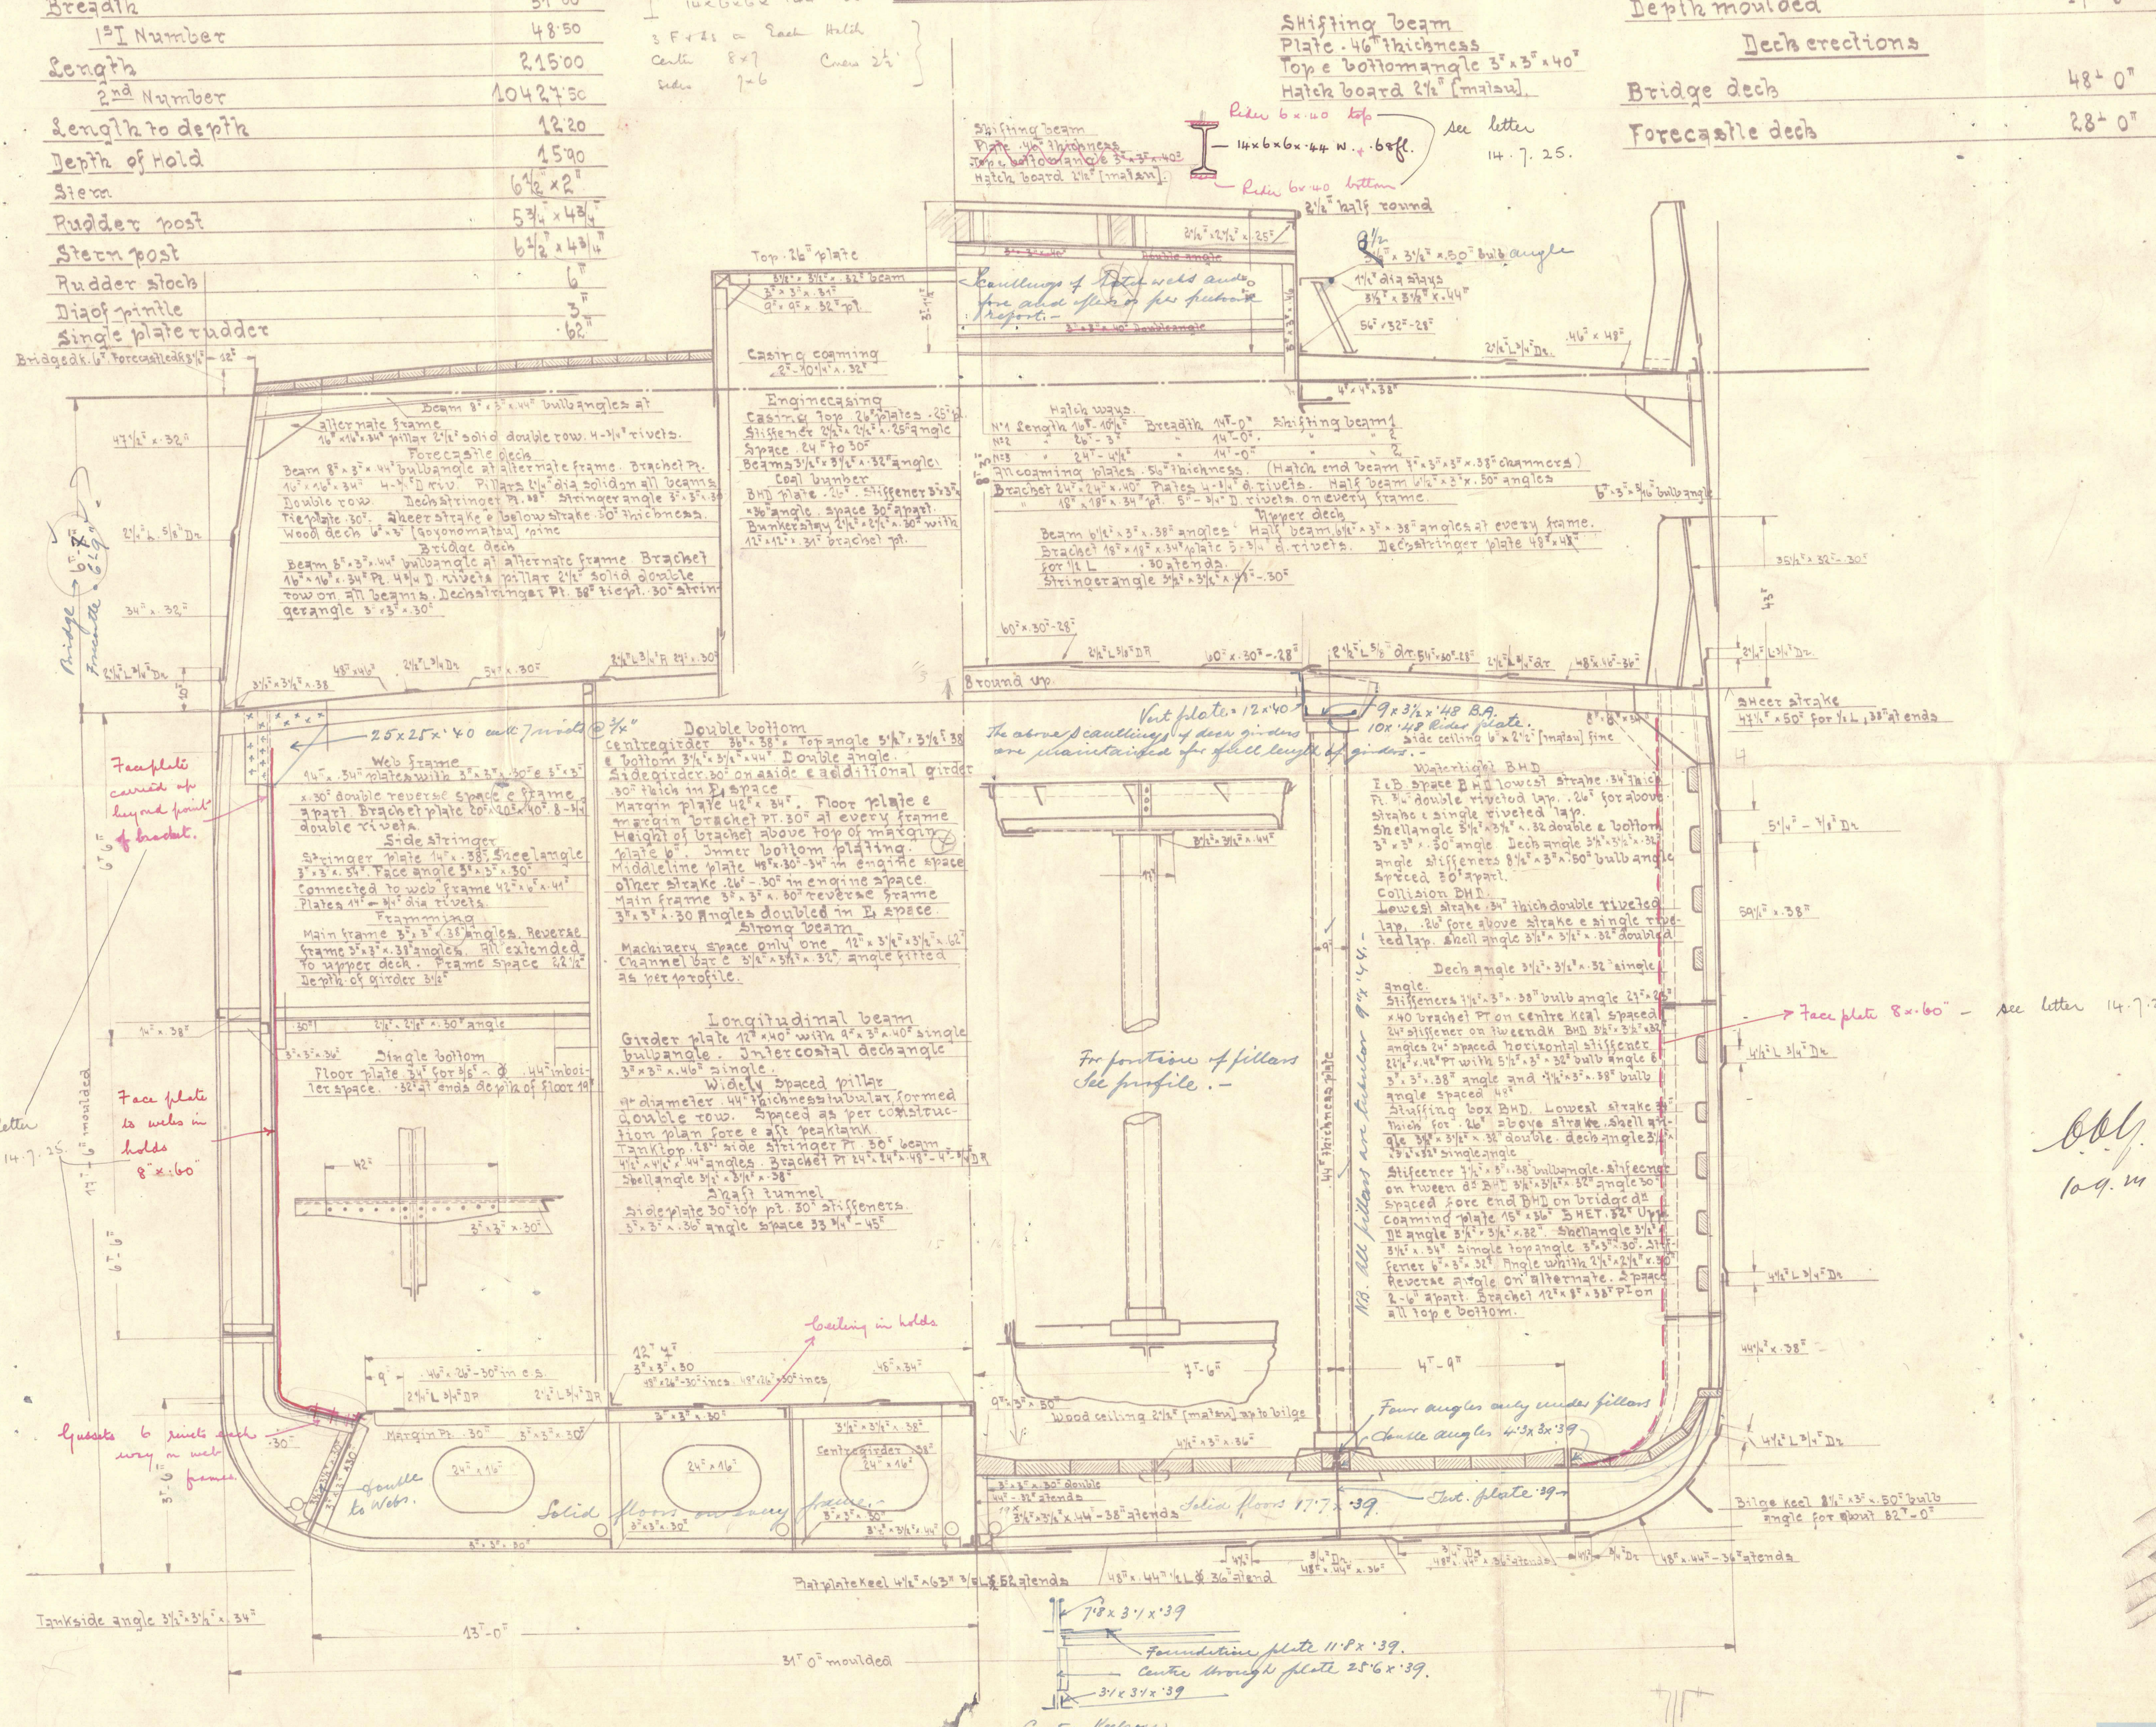

109.11

Promontory

Midship Section





© 2020

Lloyd's Register
Foundation

W1105-0127