


not to be used  
without  
- 01-1-07  
of 201 at 11:00


— PROFILE AND DECK PLAN —  
— STEEL SCREW TRAWLER N° 416. —

DIMENSIONS. 115'0" x 21'6" x 12'3" ML.  
SCALE 1/4" = 1 FOOT.


1.5.07.

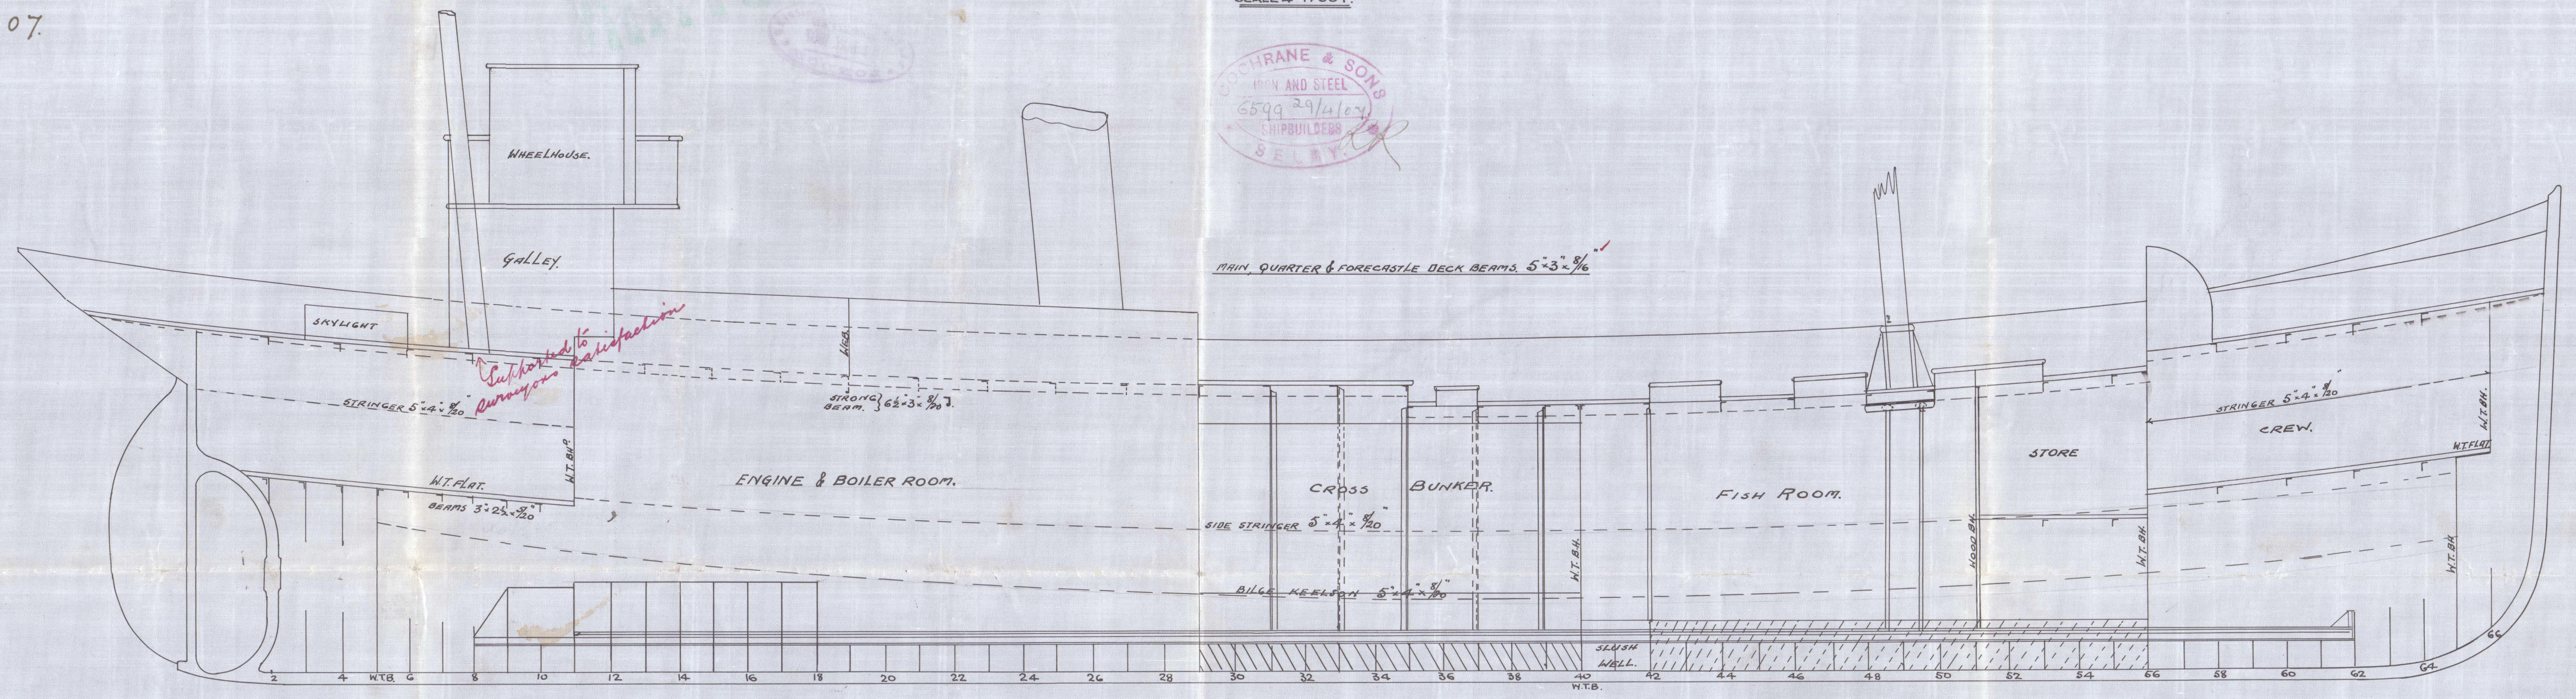

PILLARING THROUGHOUT TO SURVEYORS SATISFACTION.

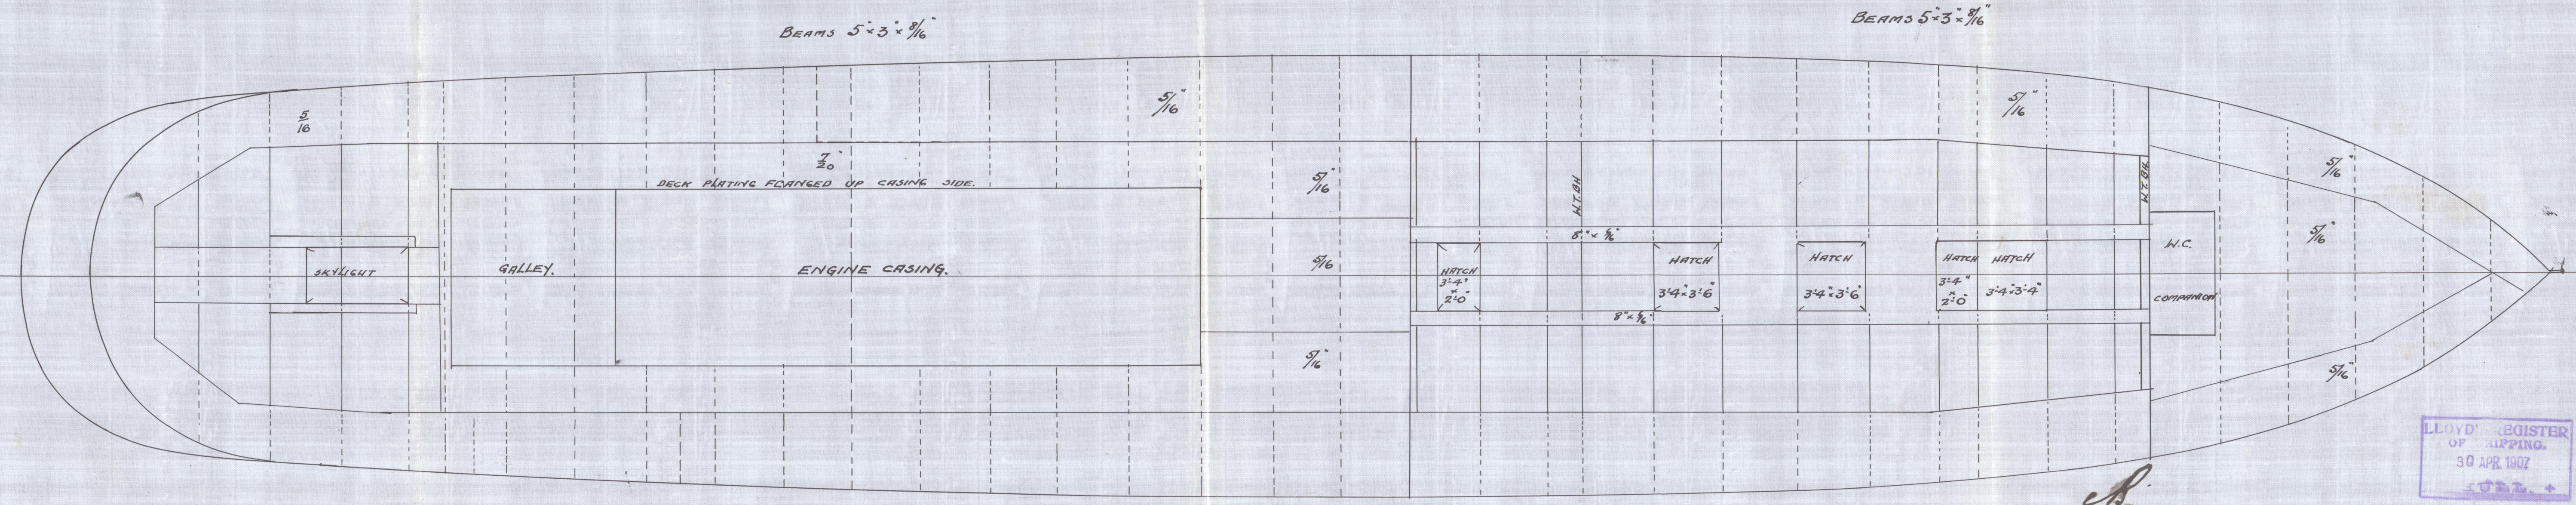

C.B.  
1.5.07.

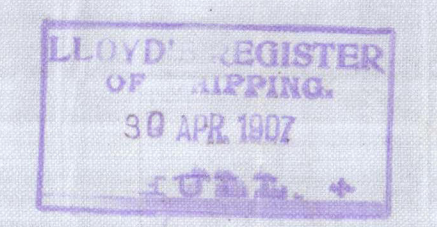



W1105-0155

Profile & Deck Plan

Lochrane & Sons

No. 416 -

of O'hells


Shall No. 19570

DECK PLAN



STEEL PLATE NO. 416

DIMENSIONS 115'0" x 21'6" x 12'3"


SCALE 1/4" = 1'0"

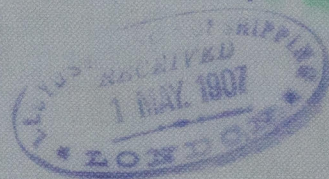

RETAIN

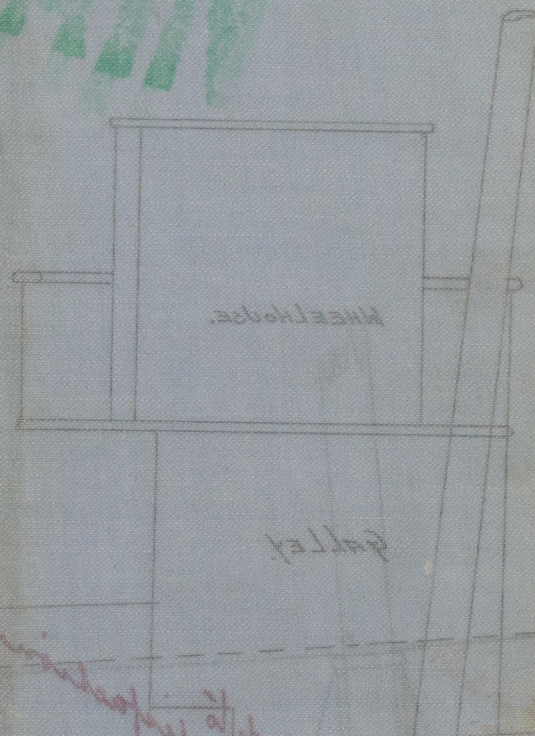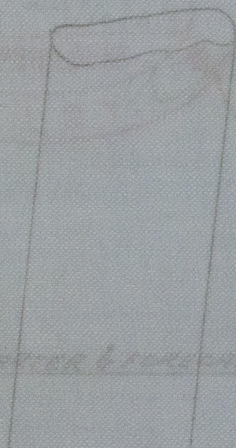

QUARTER & FORWARD DECK BEAMS 6'3" x 8"

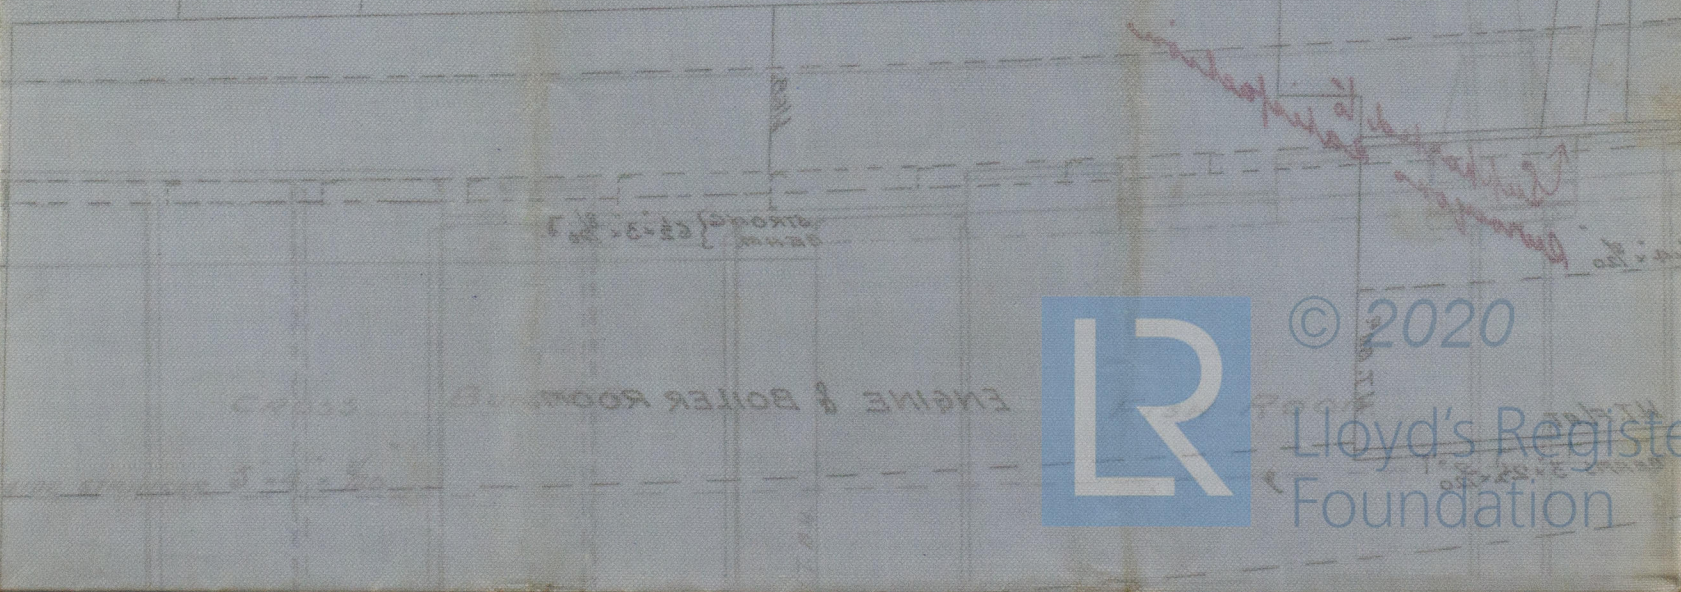

© 2020

Lloyd's Register  
Foundation