


No 112. "Irene" —
 " 113. "Virginia" —

B.A. FRAMES ON WEBS EX ENGINE ROOM.

& Fruit Ports

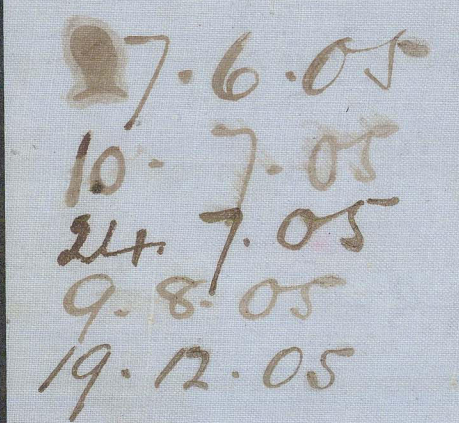

W1106-0034

Amended
Profile & deck plans

Indb report W. 43/3

Indb report no. 4425