


SS N° 282

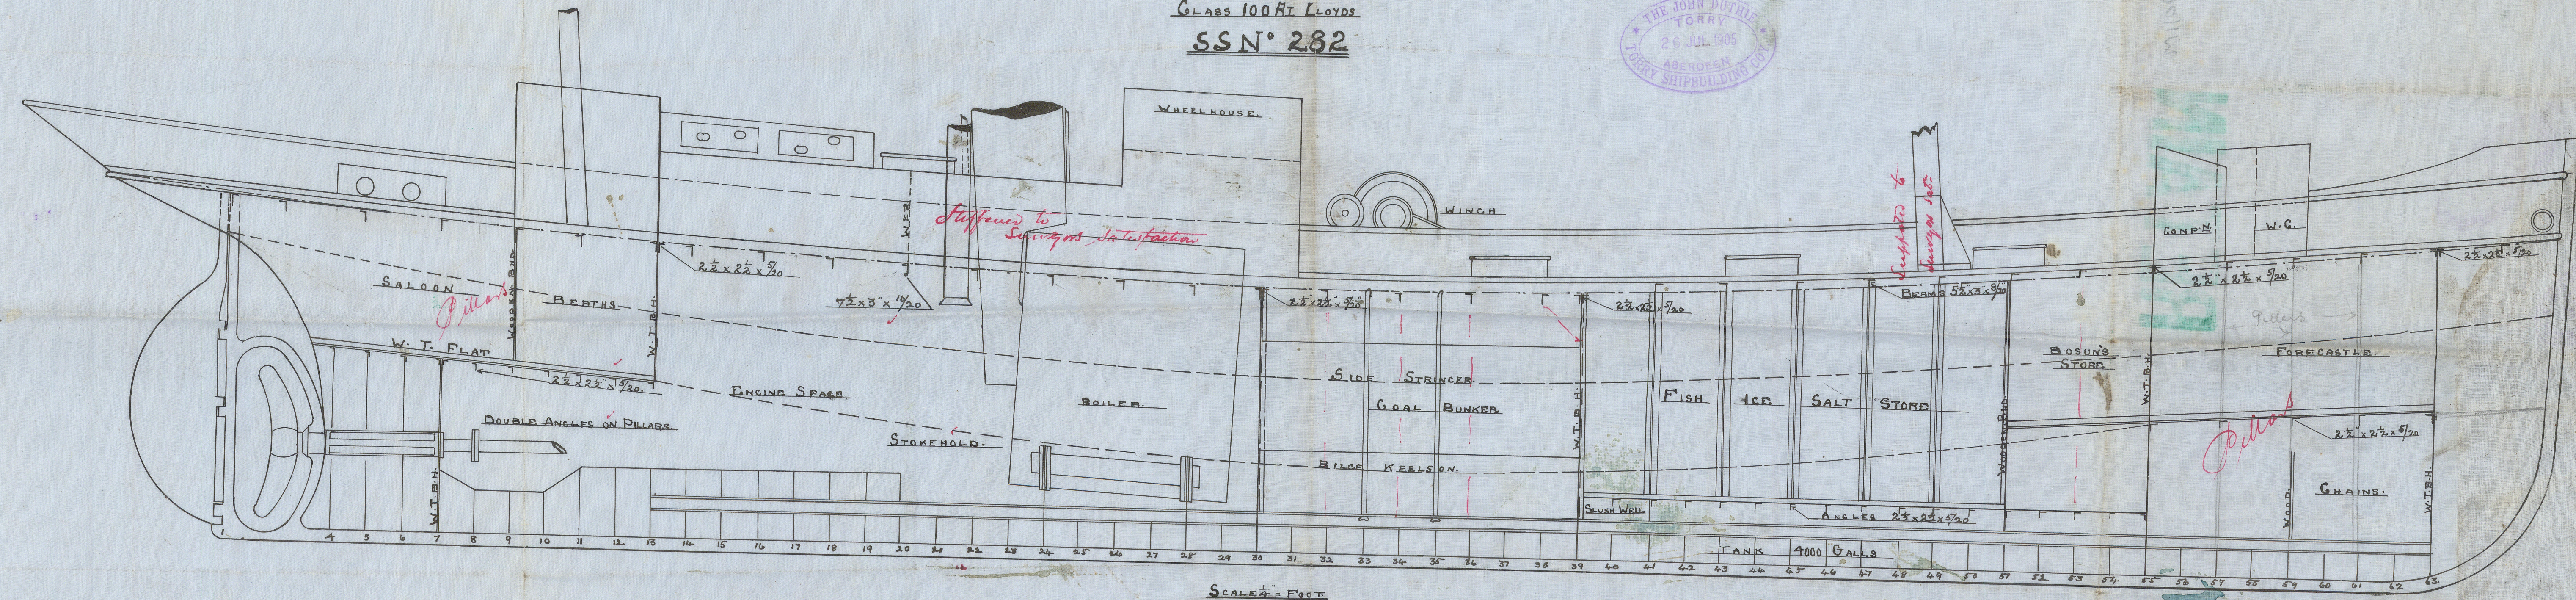

SCALE $\frac{1}{4}$ " = FOOT

CB.
29.7.05.

W1106 - 2063



M: John Bathie

L.S. R-282

~~Profile~~ Profile

L.S. "Victor"

Alt Rpt 8b31



© 2021

Lloyd's Register
Foundation

W1106-0263