


7-24-15	BAR FOR TEXAS ON BRIDGE DECK LOCATED.
7-24-15	SIDE HOUSE BARS ON MAIN DECK LOCATED.
7-24-15	STAIR OPENING #60-63 IN BRIDGE DECK ADDED.

DATE	ITEM
7-1-15	LOCATION OF BRIDGE END BULKHEADS.
" "	PLATES NO M-D-B 3-4-5 CHANGED TO INSIDE PLATES.
7-1-15	BRIDGE DECK
" "	PLATE NO M-D-S-16 CHANGED TO INSIDE PLATE.
" "	LOCATION OF MASTS.
" "	MAST DOUBLINGS.
7-7-15	BULWARK BRACES.
" "	BULWARK SHUTTERS.
" "	DECK SCUPPERS.
" "	FINISH AT ENDS OF BRIDGE DECK.
" "	WASH ROOM SKYLIGHT RUNS FULL WIDTH OF CASING.
" "	BEAM #59 TURNED TO HEEL AFT.
7-21-15	COAL HATCHES.
" "	CASING ANGLES.
" "	BEAM #69 TURNED TO HEEL AFT.
7-22-15	SCUPPERS ON BRIDGE DECK.

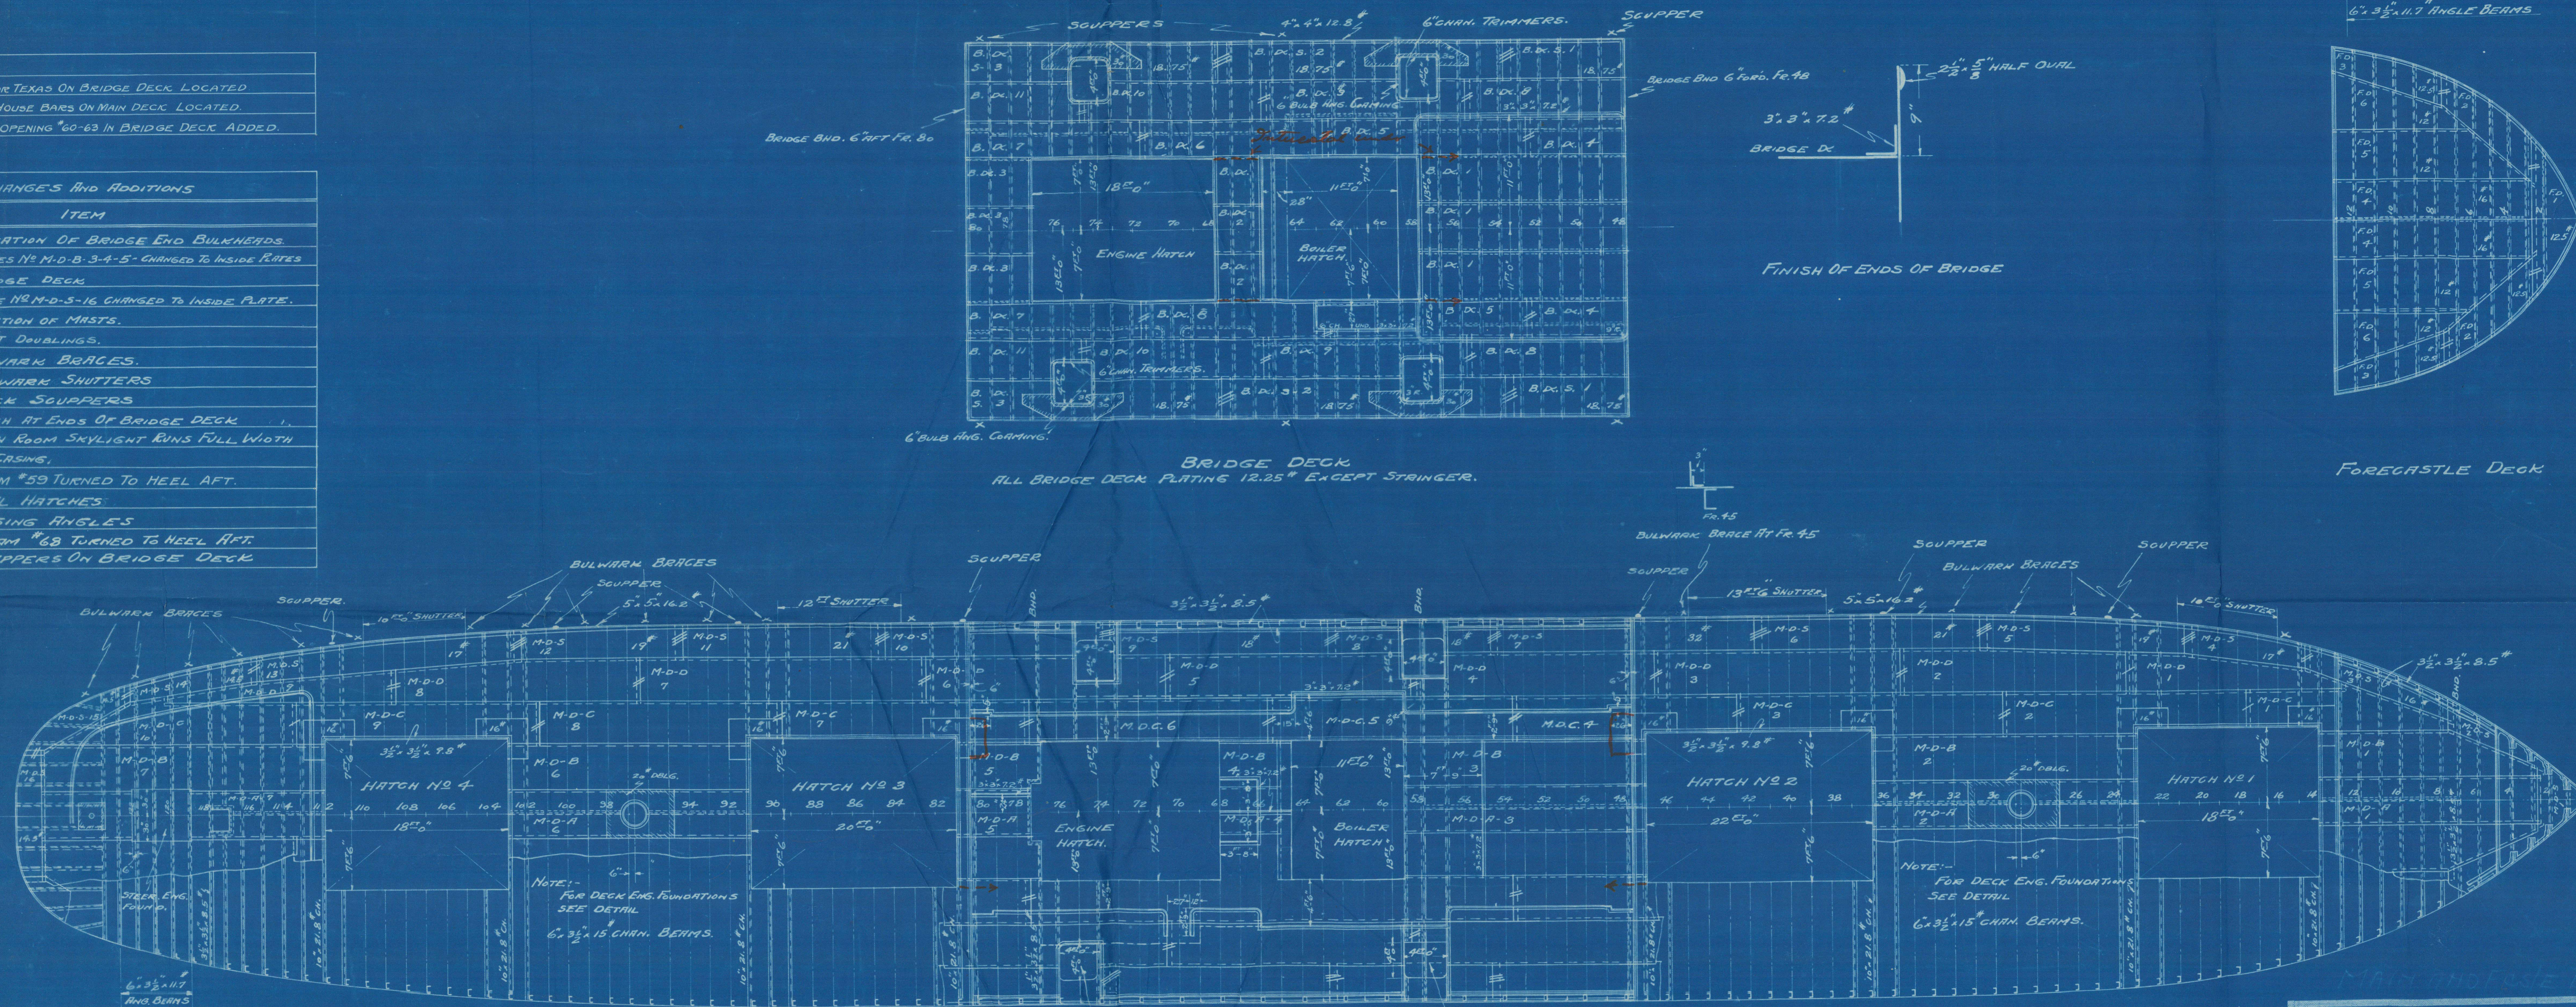

Copy Approved
Alfred C. Hall
Rep. J. J. J.

HULLS NO 147-8-9
 MAIN, BRIDGE AND FORECASTLE DECKS

Grant Lakes Engineering Works.


DETROIT, MICH.
 HULL DEPT.

Drawn by A.P.
 Checked by A.P.
 Traced by A.P.

Scale 1" = 8'
 Date JUNE 22 1915

Main Bridge + Force
Dicks

147-8-9

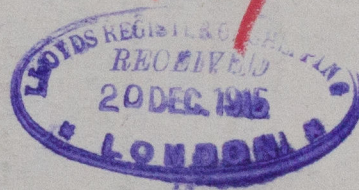

St. Yague. bls. 147.
" Yuna. " 148
" Inca. " 149.

RECEIVED



© 2021

Lloyd's Register
Foundation

W1106-0100

Decks 147-8-9.

W1106 -0100



© 2021


Lloyd's Register
Foundation

Main. Bridge + Forecastle
Decks 147-8-9.

W1106-0100

0010-9011M

Main. Bridge + Forecastle Decks 147-8-9

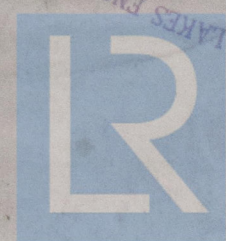

© 2021

Lloyd's Register
Foundation

WORKS
JUL 24 1015
HULL DEPARTMENT
GREAT LAKES ENGINEERING