

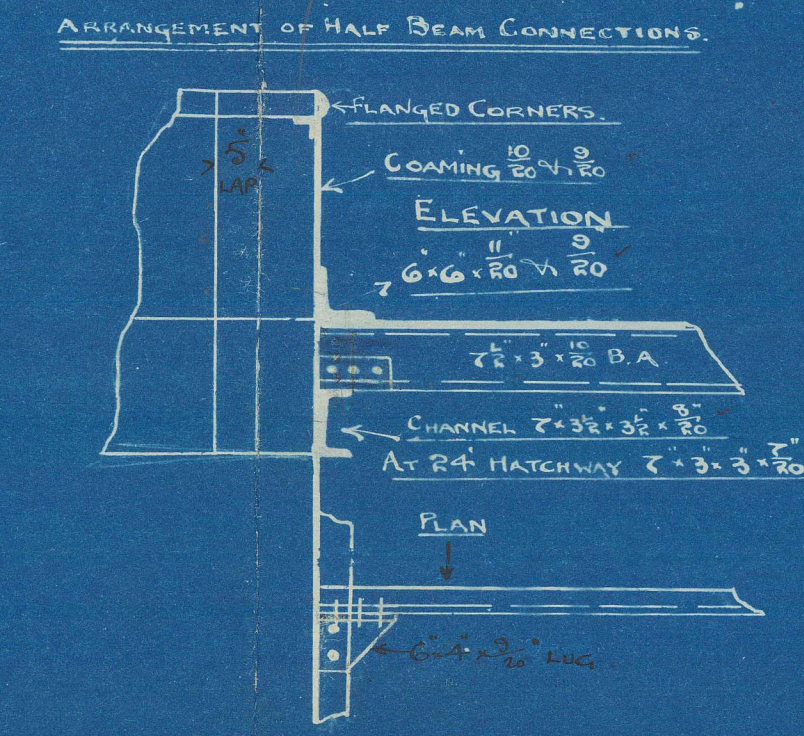
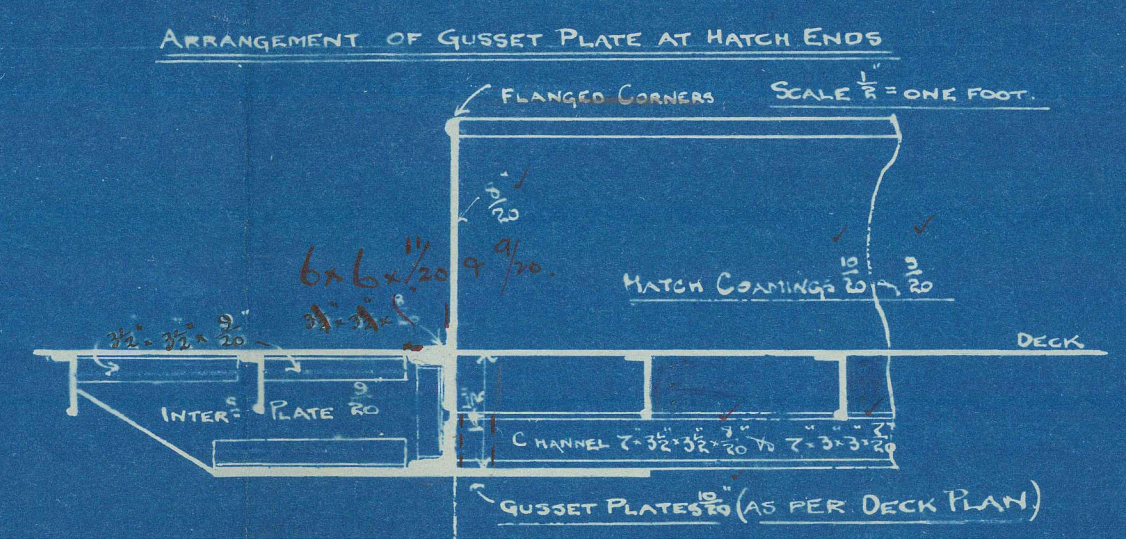


24.11.05  
15.12.05

# — DECK PLAN N°116 <sup>5</sup>/<sub>8</sub> — SCALE <sup>1</sup>/<sub>8</sub> = 1 FOOT — BRIDGE DECK. —

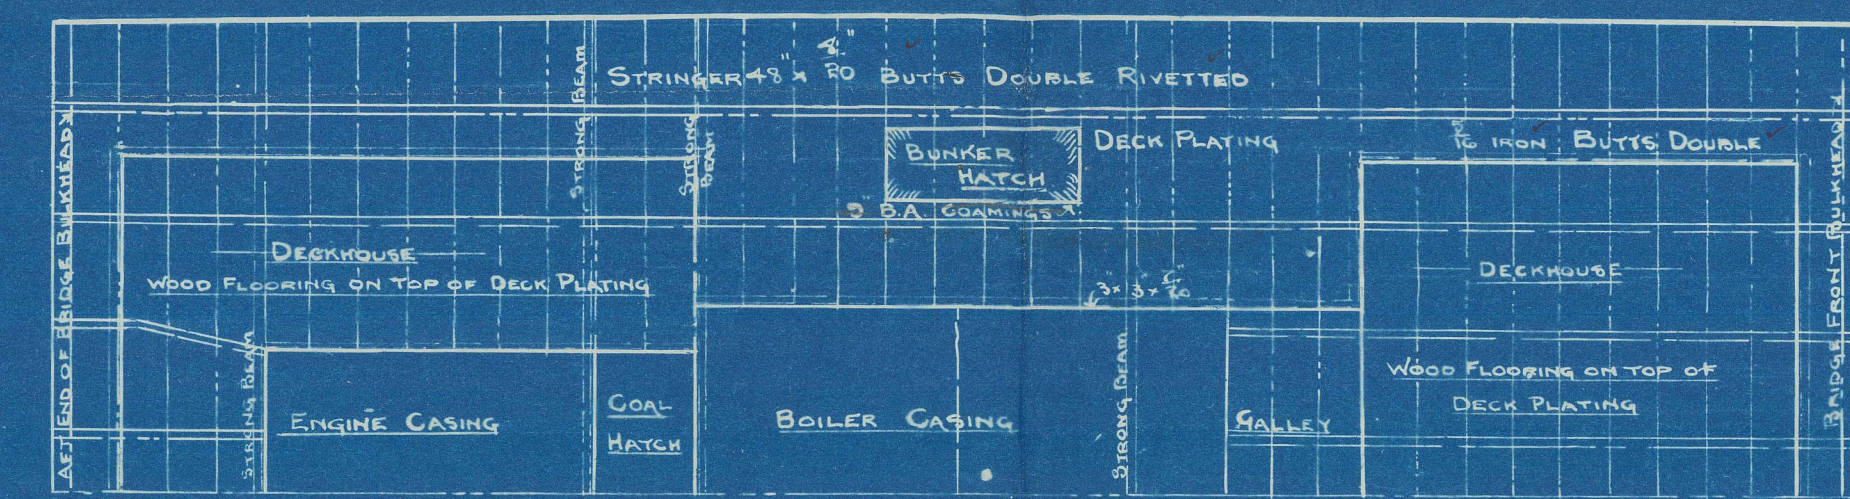

## — MAIN DECK. —

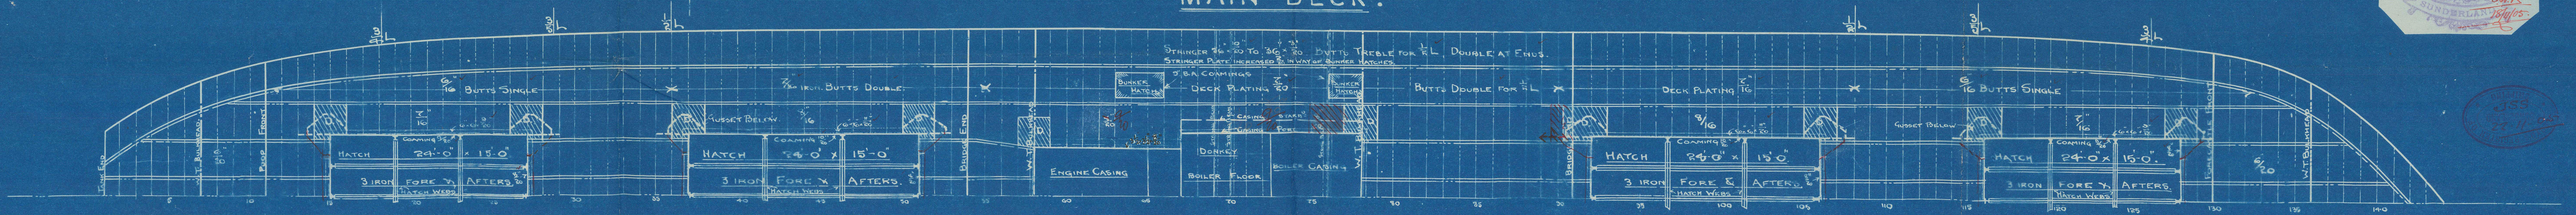

24/11/05







*J Priestman  
& Co*

*No 116*

*Deck*

*Plans*

*S.S. Times  
Hd J.C. No 22809*

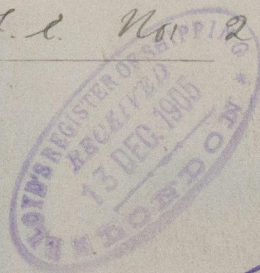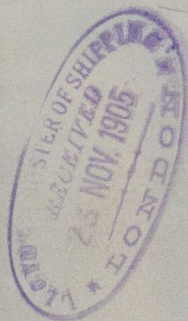

RETAIN



© 2021

Lloyd's Register  
Foundation