

MIDSHIP SECTION.

LLOYDS NOS

$$\underline{B + D} = 35.41$$
$$L \times (B + D) = 4426.25$$
$$\underline{d} = 12.25$$
$$\frac{L}{\sigma} = 9.2$$

NUMERAL FOR RUDDER = 46.31

N^{OS} 340J

DIMENSIONS:- 125.0 B.P. x 22.0" x 13.7" MLD

SCALE $\frac{1}{2}$ " = 1 FOOT

CLASSED 100A.1. STEAM TRAWLER.

STEEL.

ENGINEER BOILER
CASING AS PREVIOUSLY
APPROVED

EQUIPMENT

1. ANCHOR 5 1/2 CWT EX STOCK


1 20 5 17 24 25

1 90 2 3/4 11 79 90

105 FATHOMS 1 1/16 STUD LINK CABLE

60 6" HAWSER

60 4 1/2" WARP

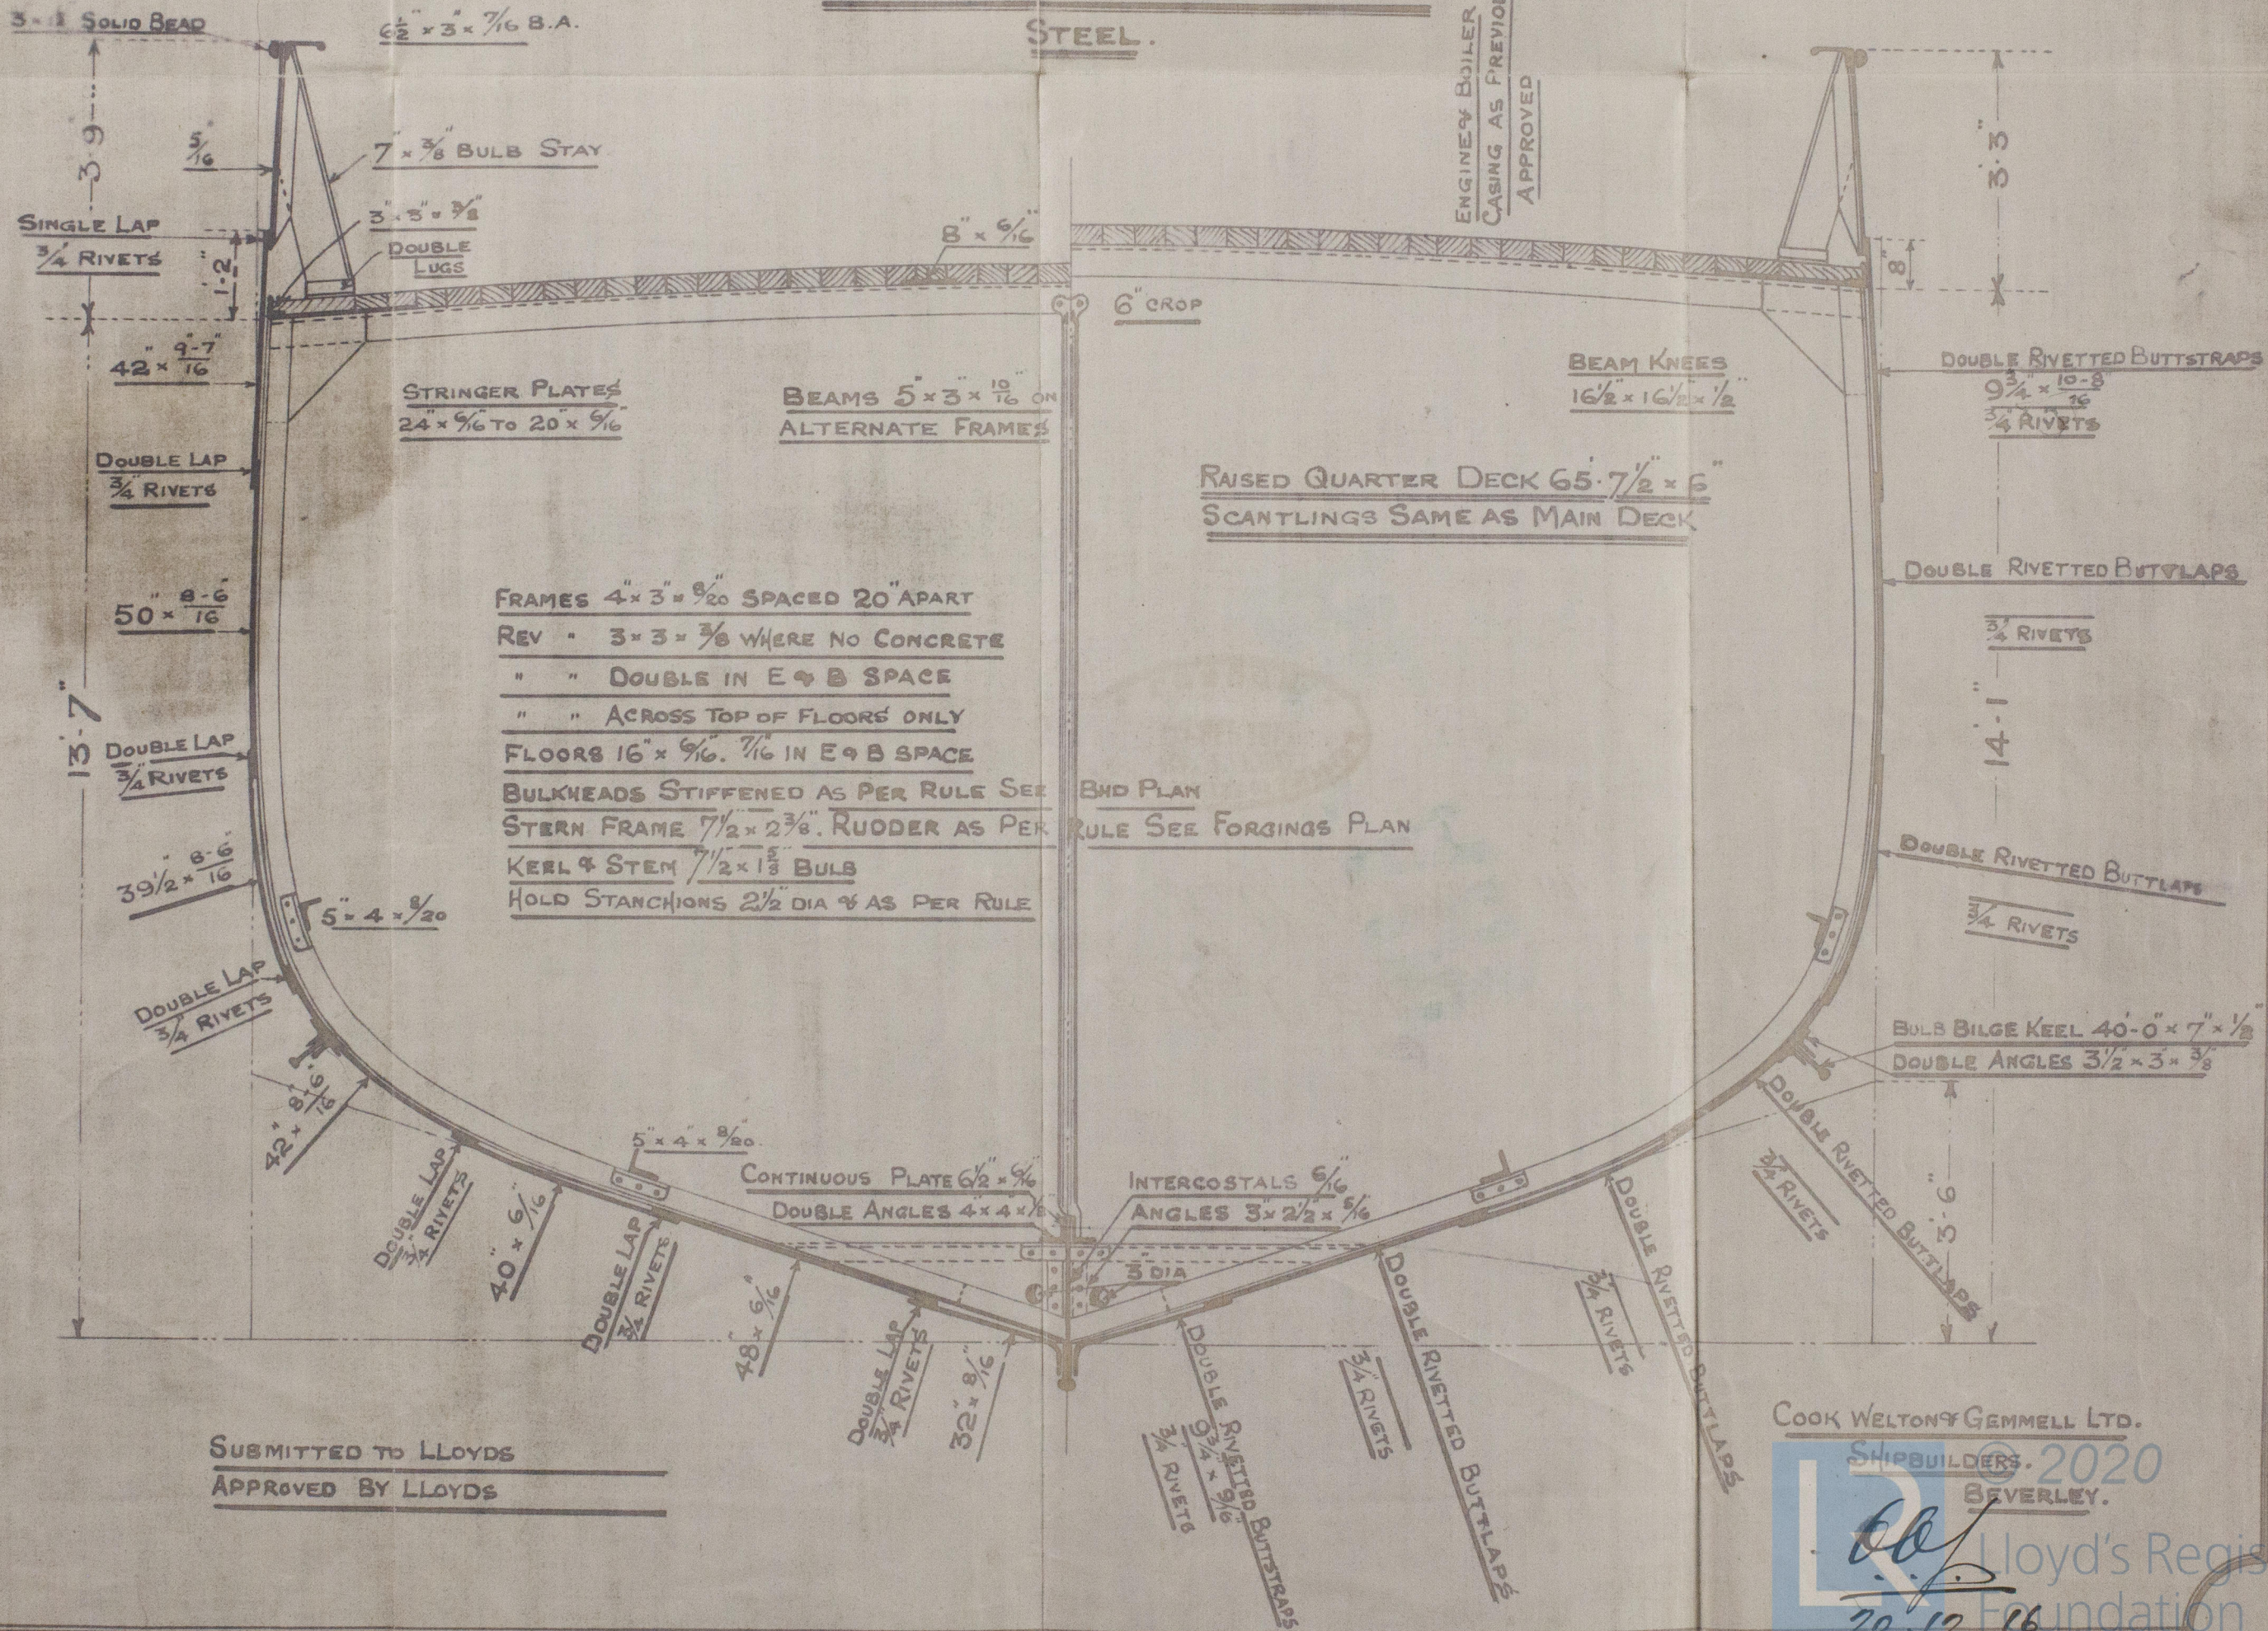

SUBMITTED TO LLOYDS
APPROVED BY LLOYDS

COOK WELTON & GEMMELL LTD.

SHIPBUILDERS. 2020
BEVERLEY.


20.12.16


W1108 - 0047

N^o 340 J.

MIDSHIP SECTION

COOK WELTON & GEMMELL

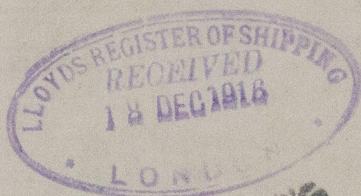

Ogano  1 ex.
 $\frac{5}{8}$ Hugh Black,
Hull Rpt No 30, 119.



D. 82 J.



© 2020

Lloyd's Register
Foundation

W1108-0047