


M^{Sires}aken in millimeters (netko)

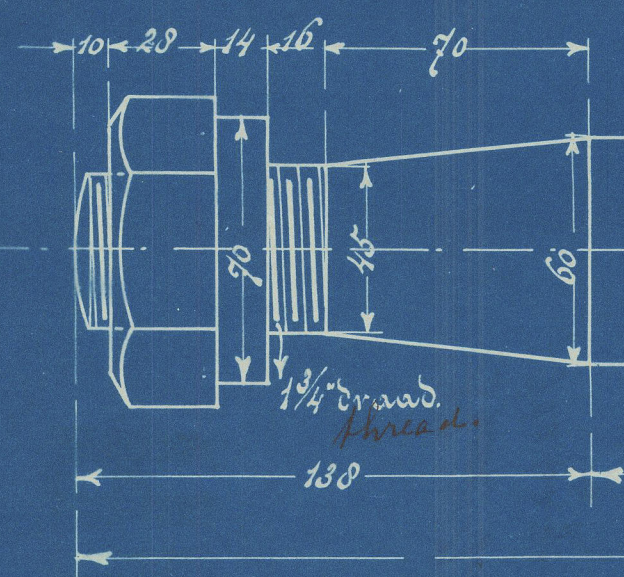

Scale
Lchral s in 2.

4 Sticks ^{off} ^{Pistons rods.} zylinderkanten

rough turned thick
Lagerungen 5 $\frac{m}{m}$ dicker

Mackinabrick Zelfskoven

Dir. H. de Ridder

Roxford

Go Lloyd's test.
Op Lloydskeur.

805 later of inside length
to be afterwards turned to exact length.

alleen afnemen

3 1/2" sheets.

2 Skuks ^{off} ^{klein} ^{hefte} schröckchen

Schul 45

206

± 2460 laker sp juvile lenger
to be afterwards turned to exact length.

2 ^{off} Stuks kruisbeenen


School 5

2100

School 12.


2 ^{off} Thrushes ^{collar} assen

Regen de kruka

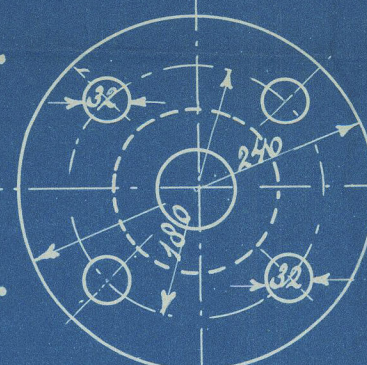

Lloyd's Register
Foundation

RETAI

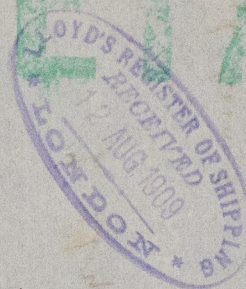

Steel Tugs
"Itapagire"

Straight shafts
Port of Rotterdam
Regt No 65346

REI

W1108-0173



© 2020

Lloyd's Register
Foundation