

TUG.

SCALE 1" = 20'

Glass Lloyd 100 A.1.

Dimensions:

Length 60' - 8"

Breath 14' - 5"


Depth 4' - 8 1/2"

HALF PLAN OF DECK PLATING.

104⁹⁵-

Prof. Sean
Steel. Fug. "Hapagite"
Rtadam report no-6534

RETAIN

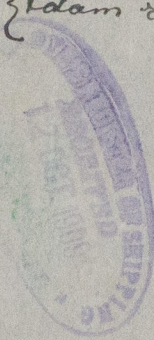

RETAIN

W1108-0177



© 2020

Lloyd's Register
Foundation