


AMENDED PUMPING PLAN

NO 260 SHIP

SCALE $\frac{1}{8}'' = 1 \text{ FOOT}$





1/7/14

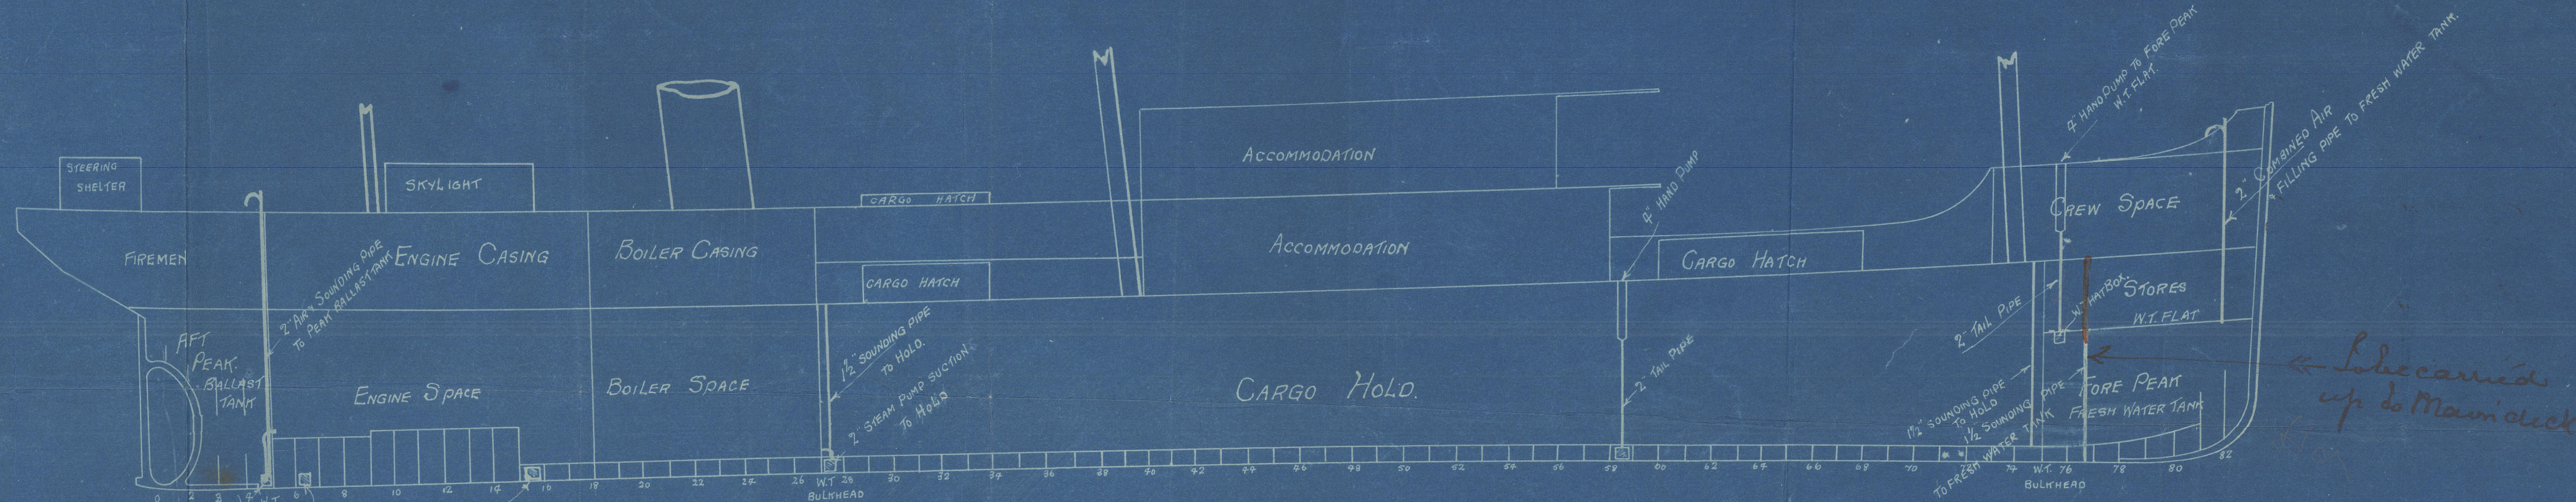

Hand pump suction to fore peak fresh water tank.

*APP
30-6-14*

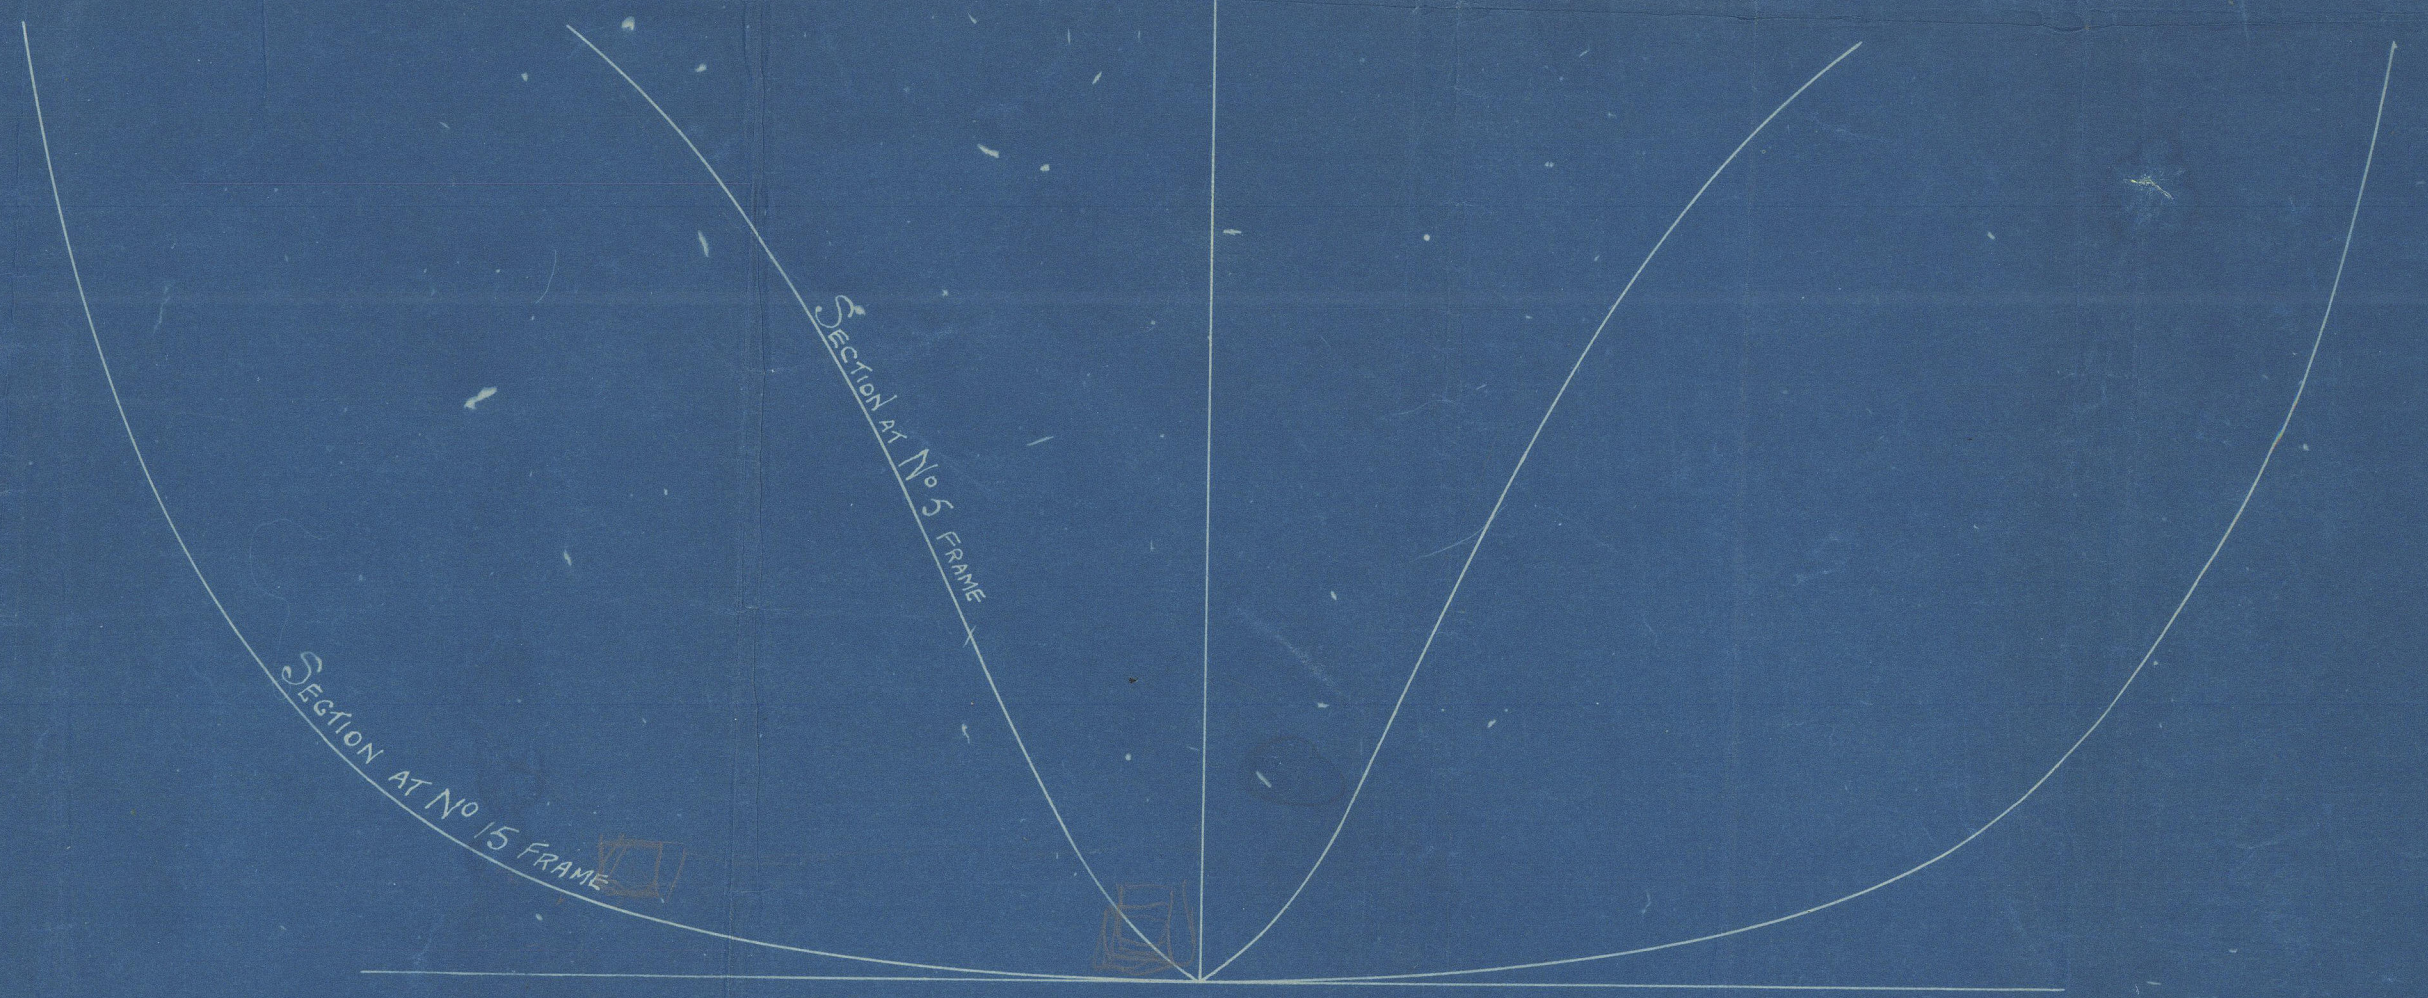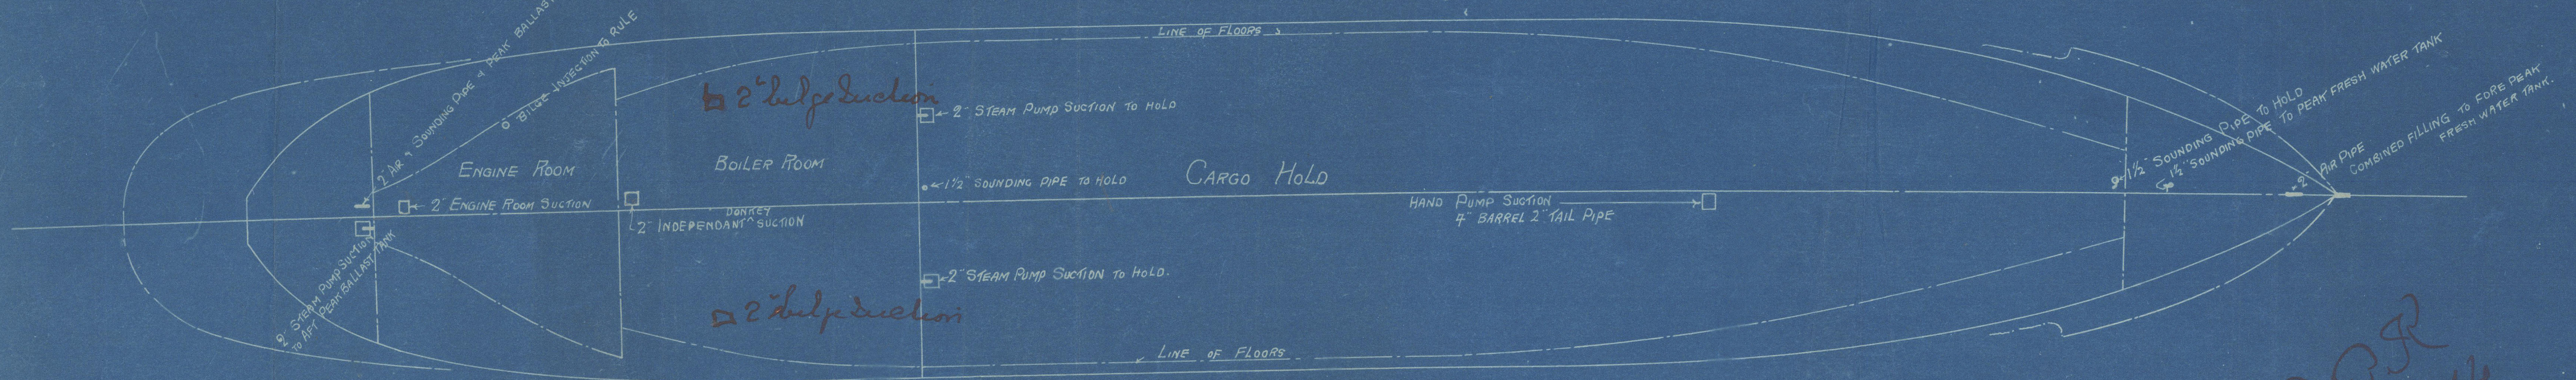

SECTIONS SHEWING LINE OF SHIPS BOTTOM AFT

SCALE $\frac{1}{2}'' = 1 \text{ FOOT}$

Aldroean Stb.

N^o 260

Is Kirabalu

GLASGOW REPORT No. 54689



11/4/17

W1108-0198



© 2020

Lloyd's Register
Foundation