




27/10/17

S.S. No 116

New midship section. (more tumble home)

Scale 1:25.

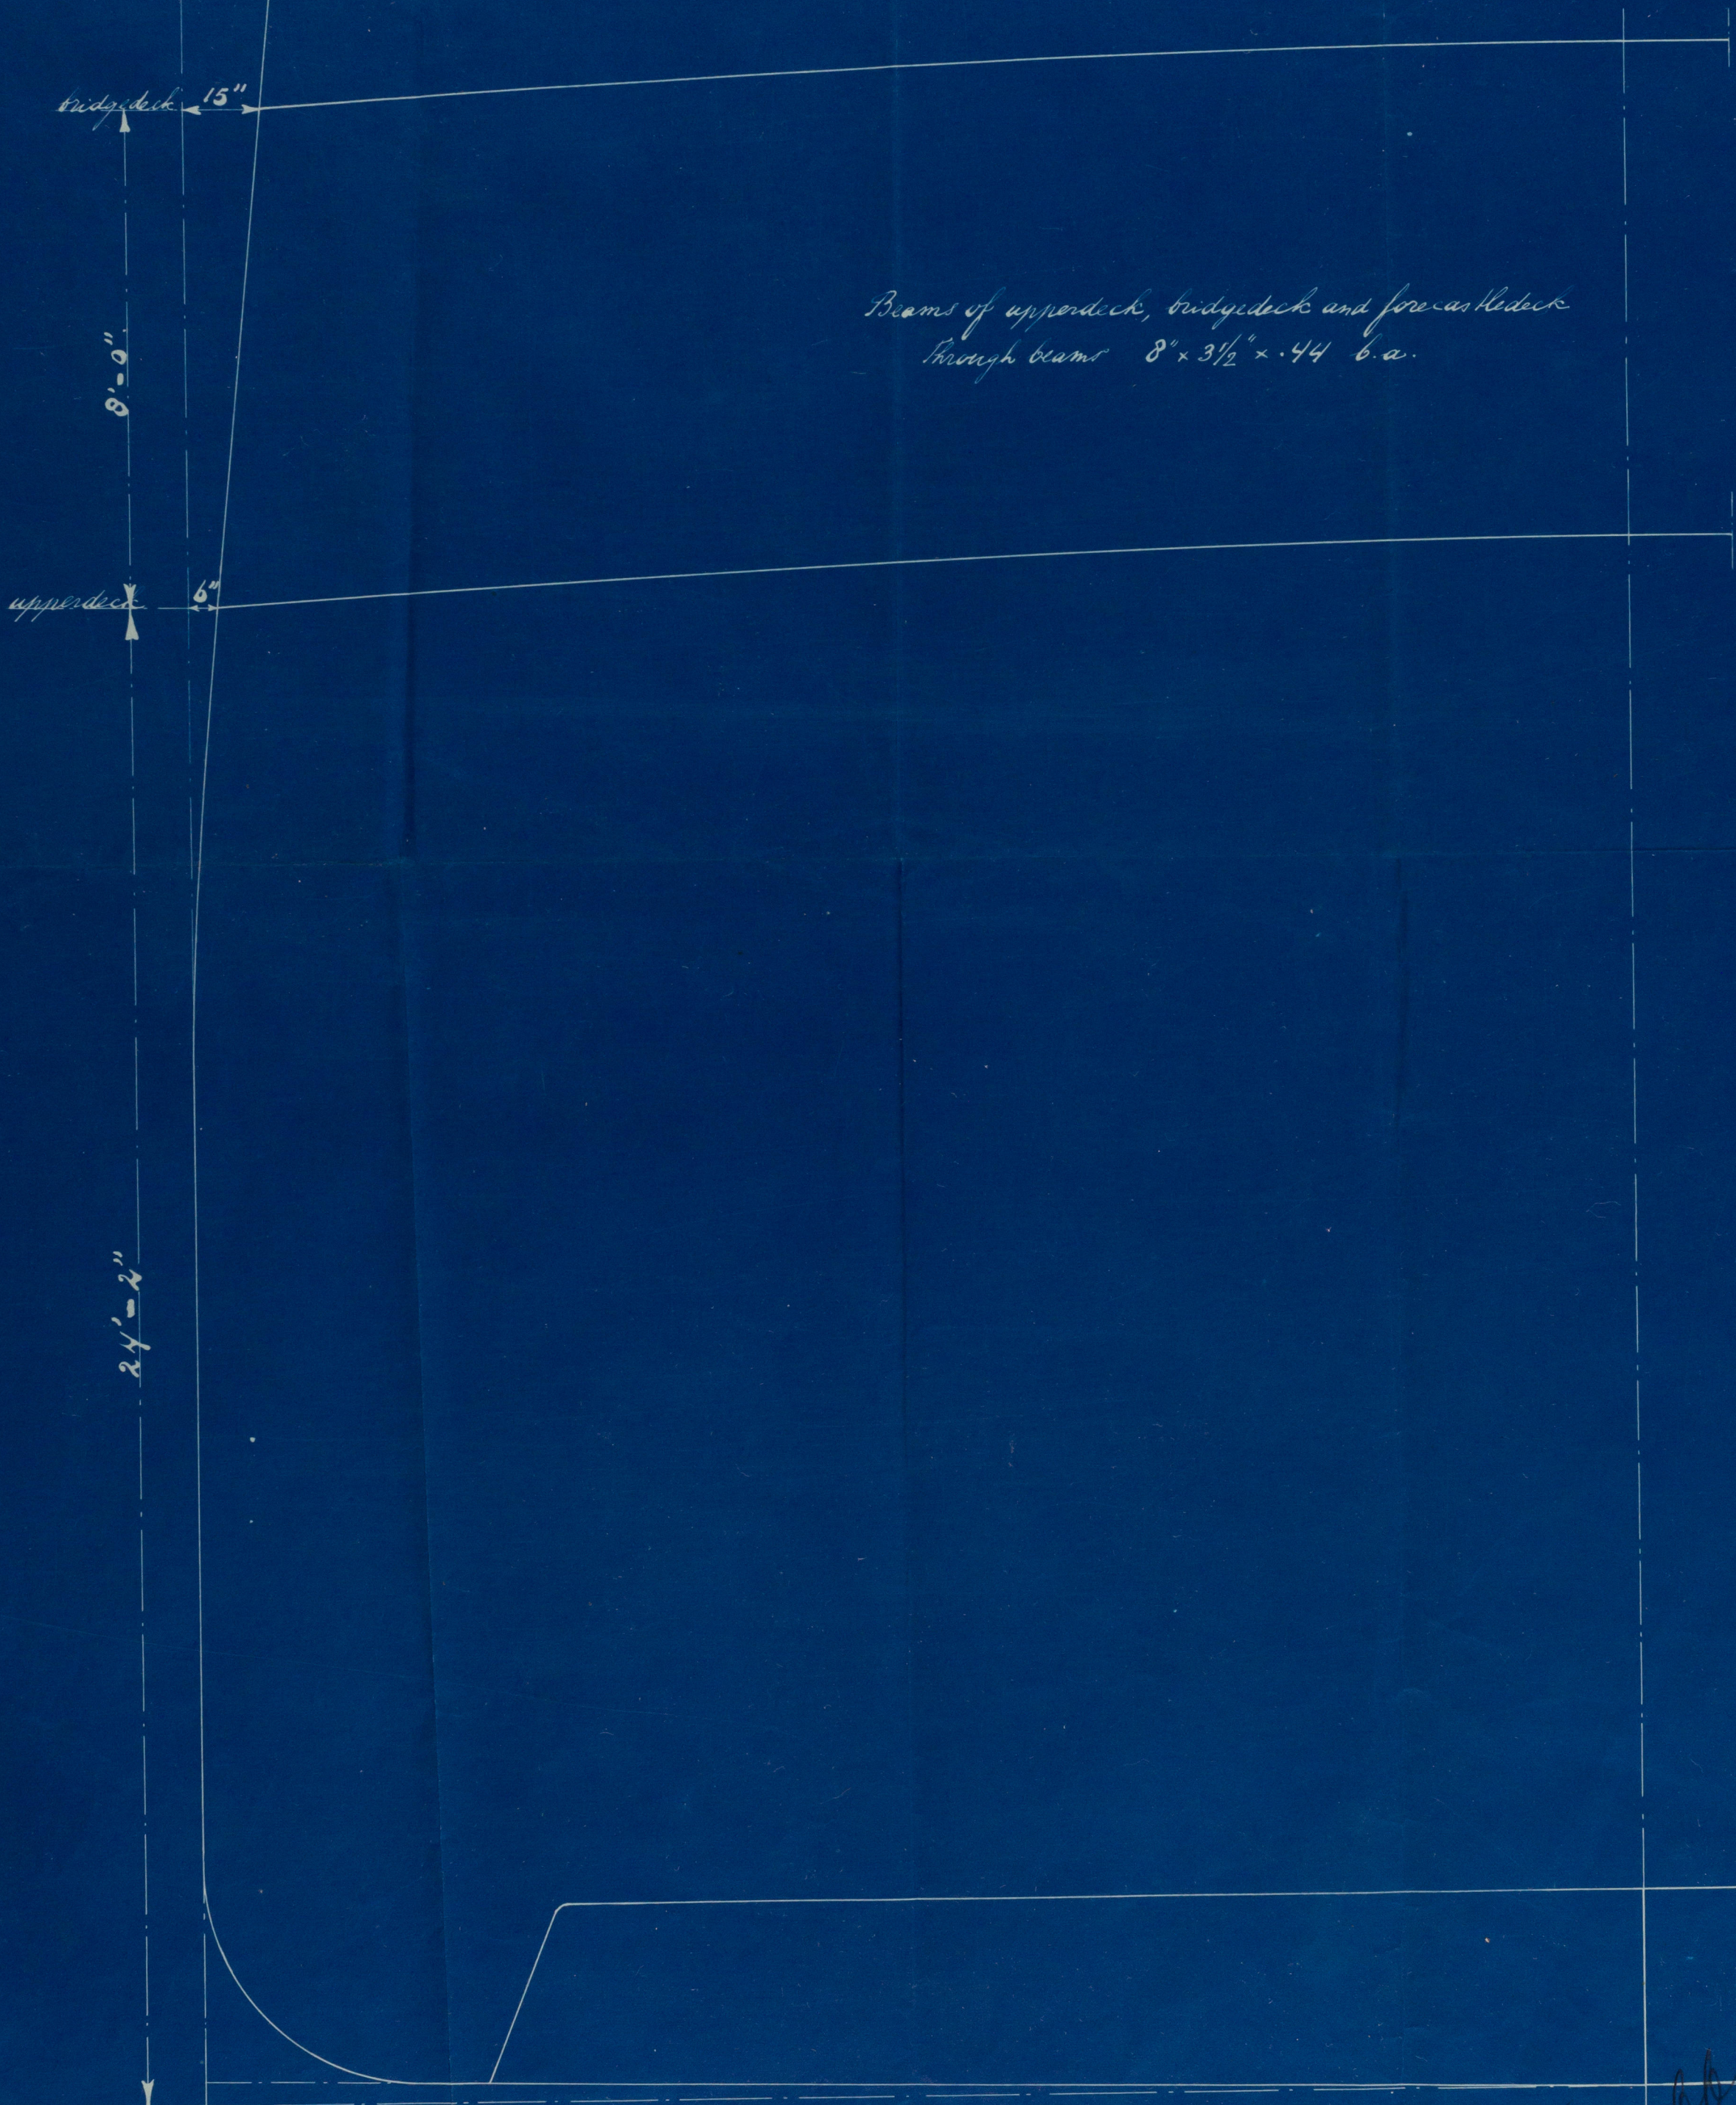

N.V. "Boele's Scheepswerken en Machinefabriek." Bolnes (Holland)



Lloyd's Register
27.10.17.
- 0033

Box 116

(More to come)

S/S "Merak"

Outline Midship
Section

Rotterdam


Report No. 11244



© 2020

Lloyd's Register
Foundation

W1111 - 0033

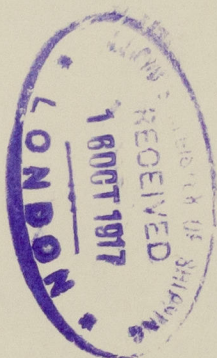

© 2020

Lloyd's Register
Foundation