

21/9
 16.10.00
 LONDON

— No 1279 Multitubular Boiler for —

— Working Pressure 180 lbs per sq. inch —

Scale 1" = 1 foot.

— Tested to Lloyds Requirements —

Material


All plates, rivets & stays of steel

Tubes of iron



Steel Rivetting


1 1/16 Rows 6 apart.

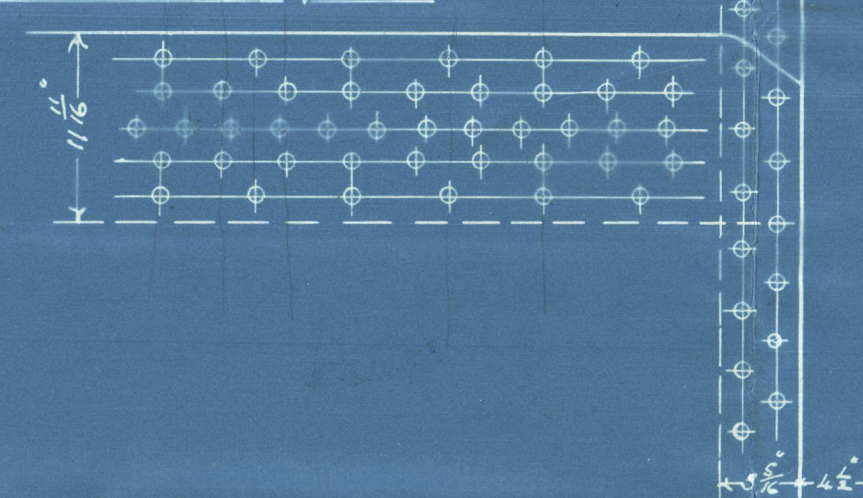

Heating Surface

Tubes	904	Sq. ft.
Furnaces	102	" "
C. Chambers	130	" "
Tube Plates	39	" "
	1175	" "

1 1/16 Rows
3 1/2" apart.

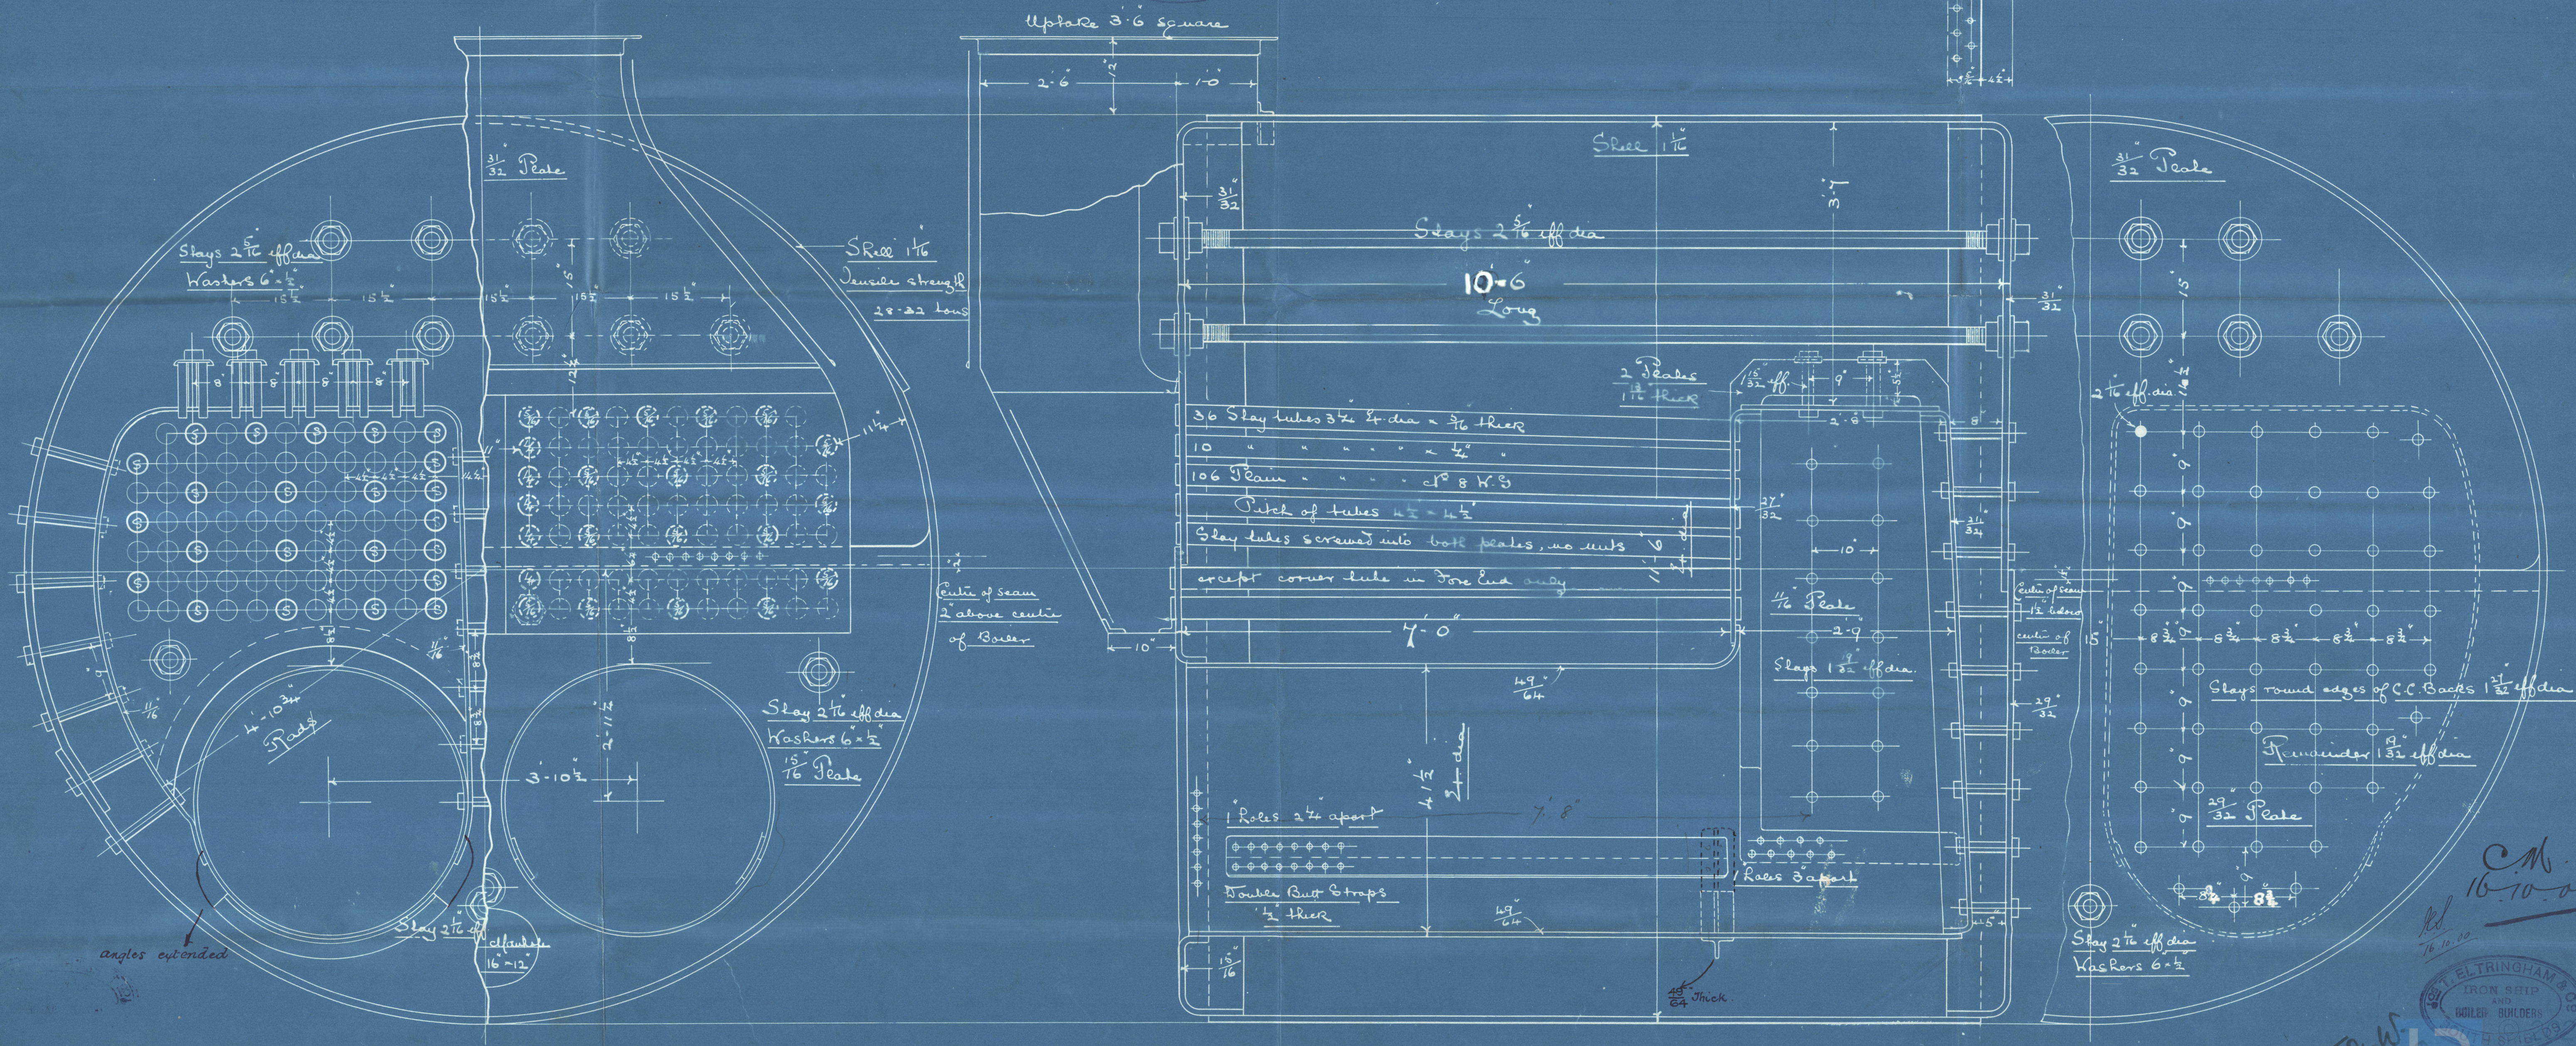

C.M.
 16.10.00
 16.10.00




Jos. T. Eltringham &
Newcastle.

Boiler No. 1279

W-P = 180^{lbs}

RETAIN

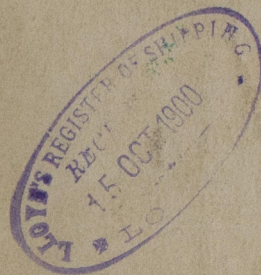

5996 Listed to 360 lbs 8-2-01 A.R.F.
--

RETAIN

J. J. Speedy

Newcastle Report

J. N. W.

12.10.00

No. 420271

Ref. Report No. 3164

W1111-8126



© 2020

Lloyd's Register
Foundation