

11.5-00
23.7-00
22-11.00

Dimensions :
145'0" x 23'0" x 10' m^{ld}
Scale 1/4" = 1 foot

of ⁴Speedy

Rob. Report 3164.

$\frac{1}{2}$ Breadth	11.5	
Depth	10.479	10.979
$\frac{1}{2}$ Girth	20.021	20.521
	<u>42.000</u>	
	185	Frame N ^o =
	<u>570</u>	
	168	
	<u>42</u>	
	6090	Plating N ^o =

Raised quarterDeck	82' 6"
Bridge	10' 6"
Fore Castle	22' 0"
	<u>115' 0"</u>


Anchors & Cables
Equipment N: 6693 - 6882 ✓

2 Bower anchors Stockless 984, Out ✓
1 Stream ex Stock 24 ✓
1 Kedge
45 Fathoms 1/4" Stud link cable chain
60 " 2 3/4" Steel Wire
75 " 1/2" Hemp Towline
90 " 5/8" Hawser

Frames 3' x 2" 3" Spaced 21" apart
 of ship alternate second from each side Double engine backspace.
 Floors 12' x 4'0" 3 1/2" Length 8' Ends under Engine
 7'0" to Boilers 9'0"
 Bulkheads 7'0" Stiffeners 5' x 3' x 4"
 Stern frame 6'0"x5' Stem 6'0"x12'
 Rudders head 4' Diam. pintles 2 1/2"
 Coiling 2"

Bridge Stringer	20 x 7/20	} butts overlapped double riveted.
Forecastle	20 x 6/20	

Stringer at side of Engine room full width and $\frac{3}{4}$ thick butts treble riveted in way of some.

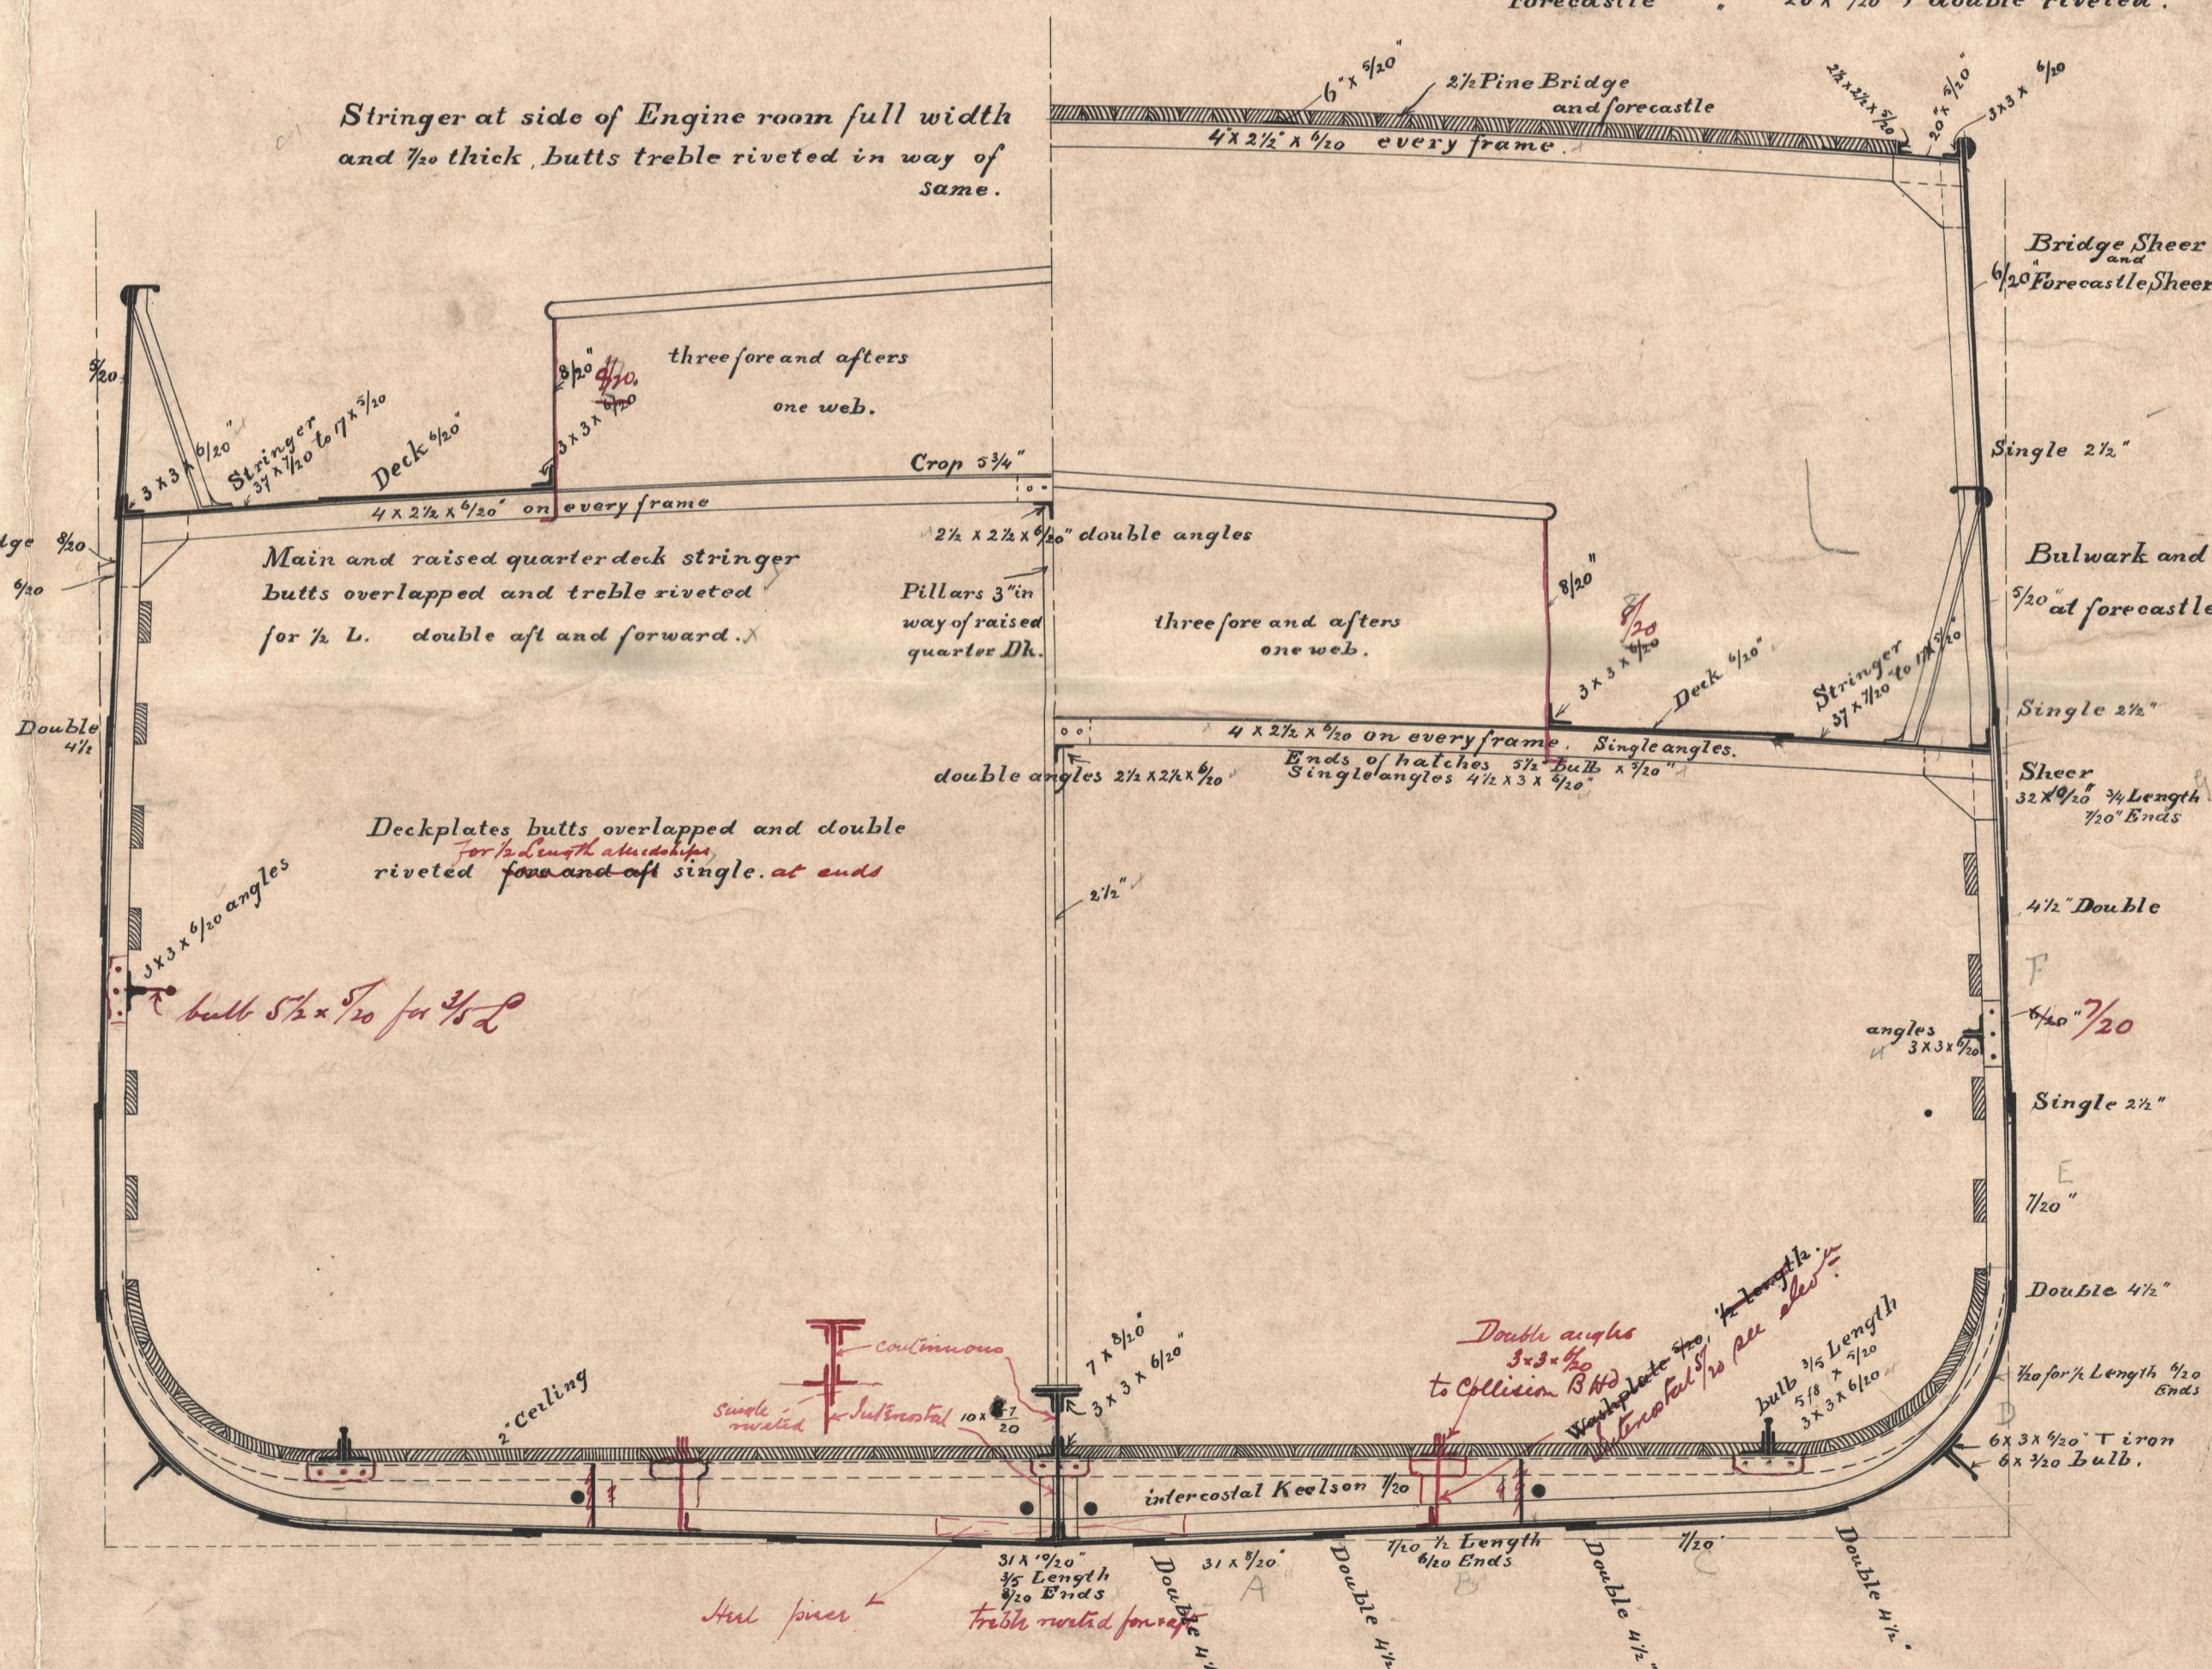

Angles on floors $3 \times 3 \times \frac{1}{2}$ L
Intercoastal keelson fitted over a
length of 10 frames between ^{CD 137}
centre and bilge keelson ^{this implies rule 3}

11/5/00
12/6/00
22.11.00

RETAIN

RETAIN

Wm - 0127



RETAIN

RETAIN



© 2020

Lloyd's Register
Foundation