






M11-0458

2  
1 1/2  
3 1/2

Donkey Boiler for  
G Black's N<sup>o</sup> 252

S<sup>r</sup> Speedy  
Bot. Report 3164

Working pressure 100 lbs.

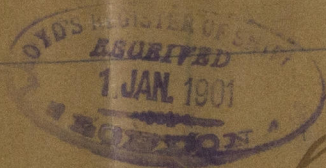

S. I. Speedy

Newcastle Report

N<sup>o</sup> 42024

No 490  
Hoyds Lect  
200 lbs  
14-3-01



© 2020  
Lloyd's Register  
Foundation