


11.7.19

Building No 5

Profile

Decks, shell expansion and W.T. bulkheads.


Length between P.P. 170'-0"
 Breadth moulded 31'-0"
 Depth to maindeck 14'-3"
 Height of forecastle 6'-9"
 ———— poopdeck 7'-0"
 To obtain Class: British Lloyd's 100.A.1.
 $L \times (B+D) = 170(31+14.25) = 7692$
 $B \times D = (31 \times 14.25) = 441.75$
 $d = 12'-10"$ $\frac{1}{4}D = 11.93$
 d in way of double bottom 11'-8"
 Scale $\frac{1}{8}" = 1'-0"$

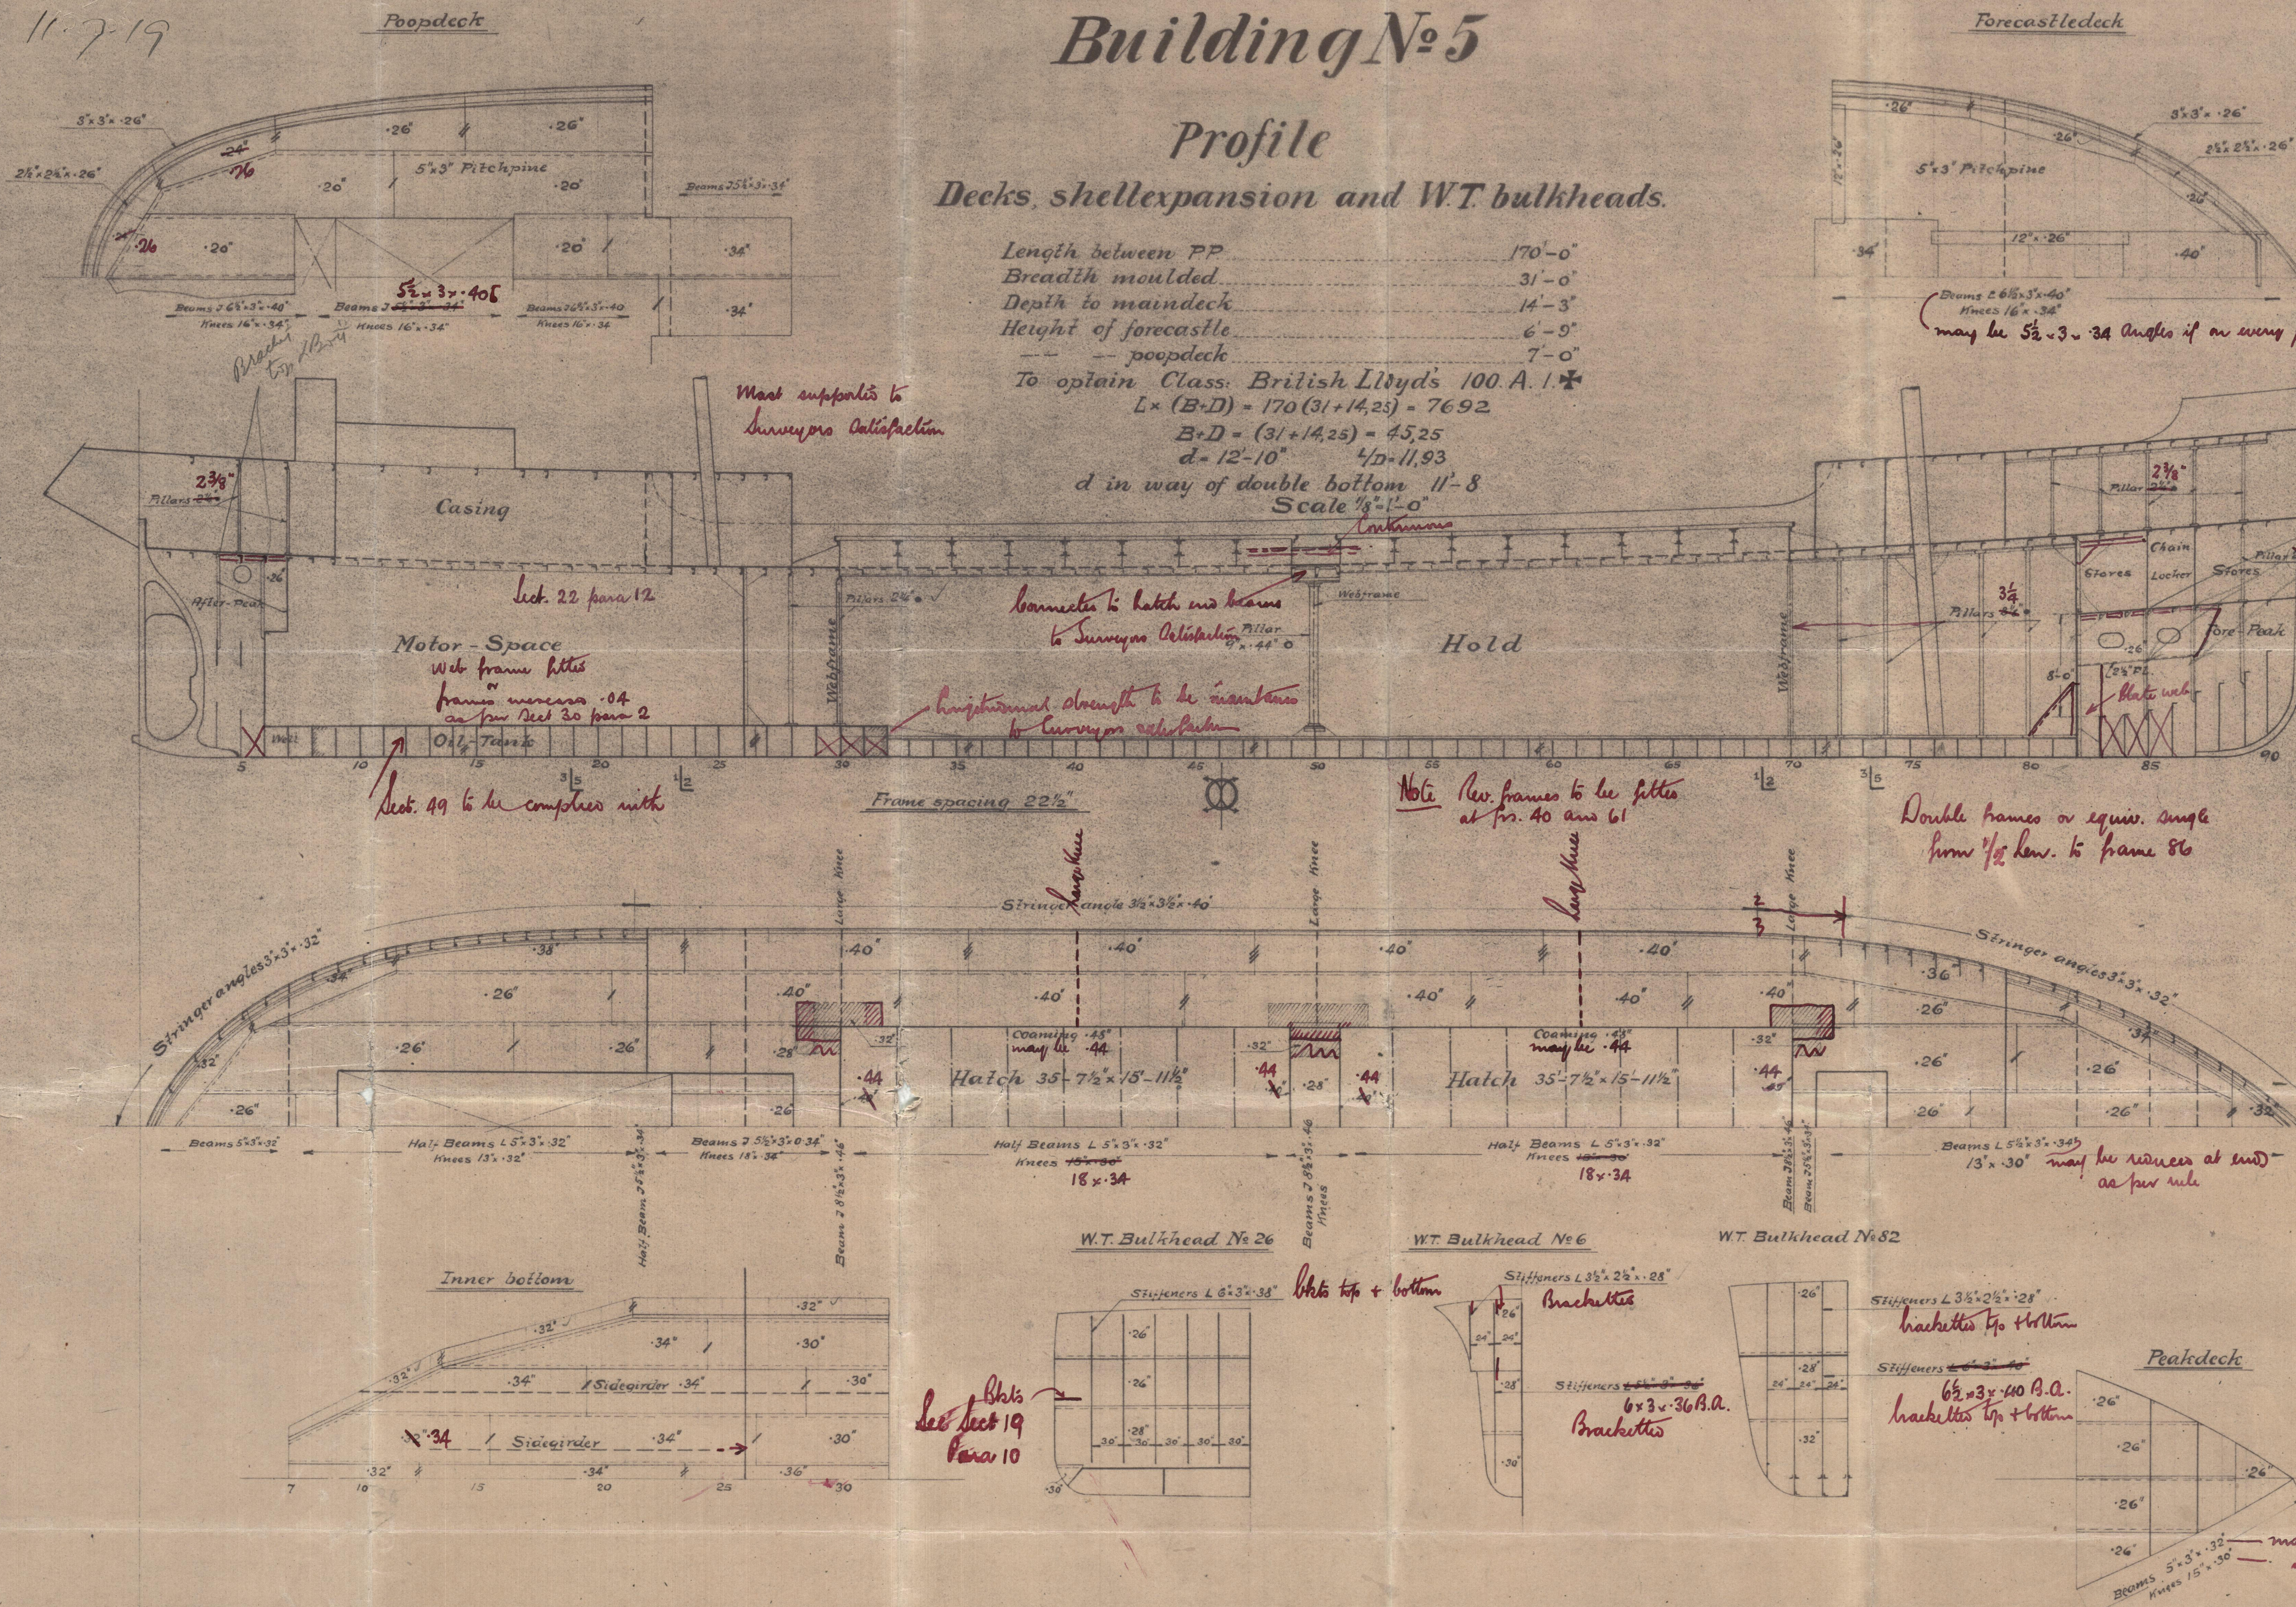


Shell expansion

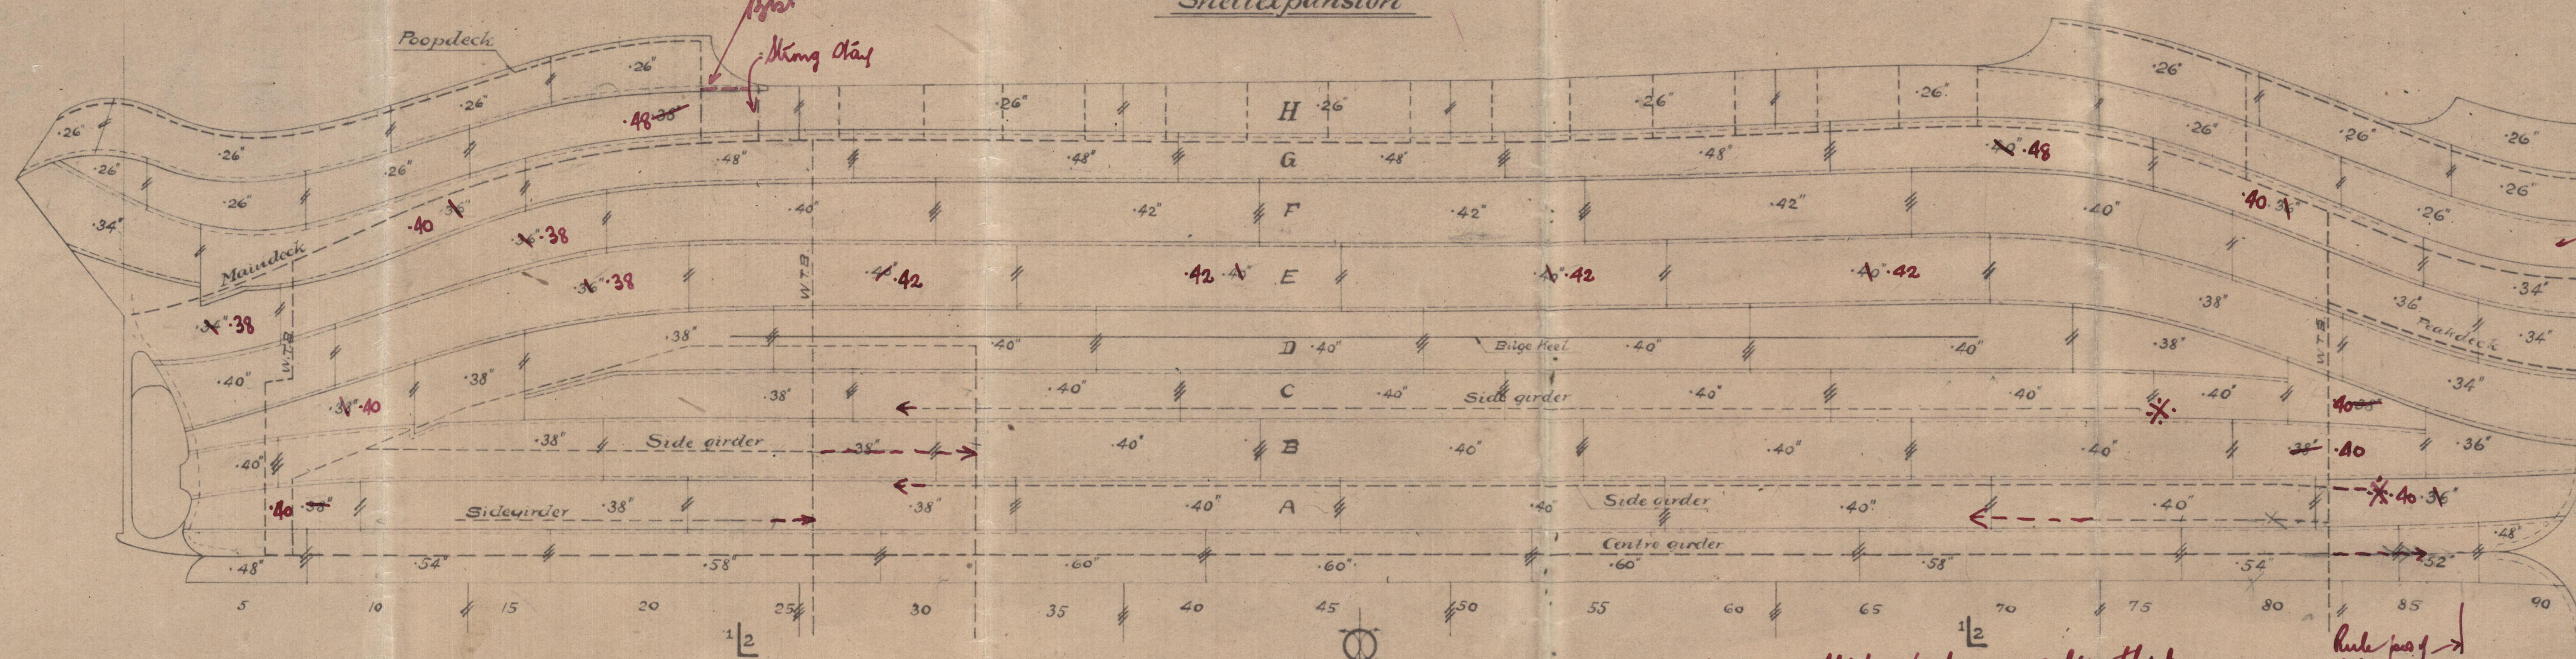


AKTIESELSKABET
 NAKSKOV SKIBSVÆRFT
 28. 1919
 Thomsen
 * Side Keelsons to be carried
 as far forward as practicable
 Profile
 Decks, shell expansion
 and W.T. bulkheads
 170'-0"
 31'-0"
 14'-3"
 6'-9"
 7'-0"
 11.7.19
 4074
 Lloyd's Register
 Foundation
 W111 - 0264

Nakshon Skisvart.
Danmark.

Newsmaking No 5.

Longitudinal Section
&

Deception.

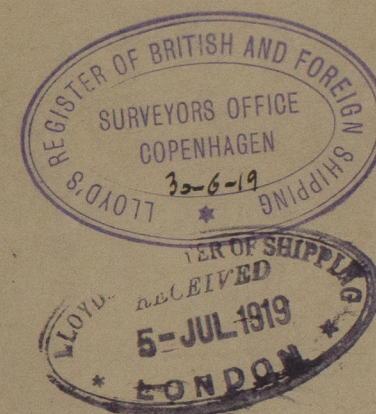

m/s Virginia Gpr. Rpt. No. 6244.

Will - 0204



© 2020

Lloyd's Register
Foundation