

— MIDSHIP SECTION — — STEEL SCREW TRAWLER —

— N^o 380-1-2-3&4. —


DIM^s LENGTH 117-0. BREADTH 22-0. DEPTH OF HOLD 11-9. MOULDED 12-6.

— SCALE $\frac{1}{2}$ INCH = ONE FOOT. —

TO BE CLASSED 100.A.I. FOR FISHING PURPOSES.

DECK PLATED OVER AT SIDES OF E & B. CASING

11.5.06
18.9.06

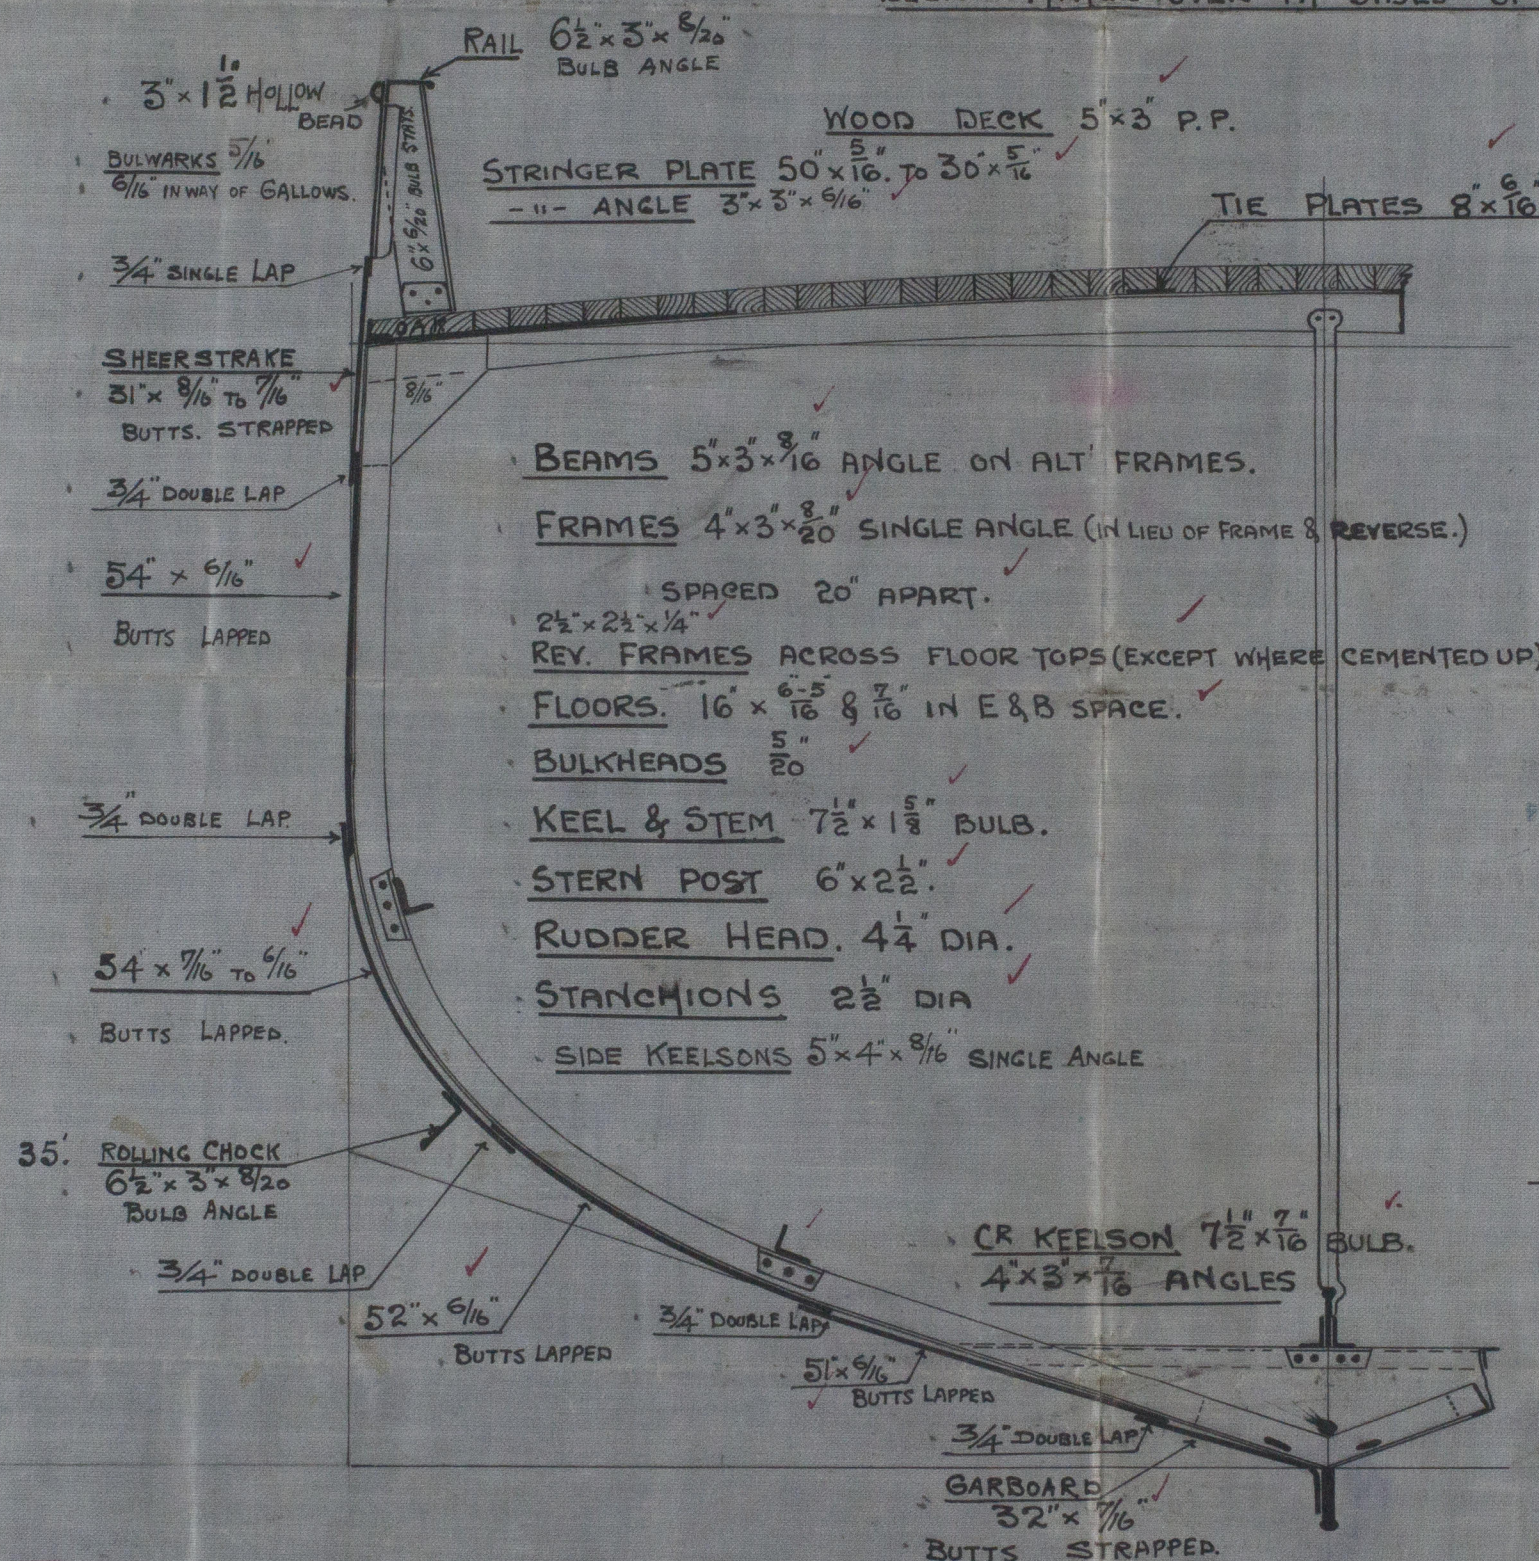

LLOYD'S NUMERALS

$\frac{1}{2}$ GIRTH	19.33	43.25
BREADTH	10.95	
DEPTH	12.96	
	43.24	1 ST N ^o
	115.87	
	5010.2188	2 ND N ^o

D to L ----- 8.9 ✓
B to L ----- 5.2 ✓


EQUIPMENT.

1 ST	BOWER ANCHOR	54	CWTS Ex STOCK
2 ND	"	44	" " "
3 RD	"	2 1/2	" " "
90 FATHOMS		1	SHORT LINK CABLE
60 "		6	HAWSER
60 "		4 1/2	WARP.

MESS^{RS} COCHRANE & SONS

SHIPBUILDERS

SELBY

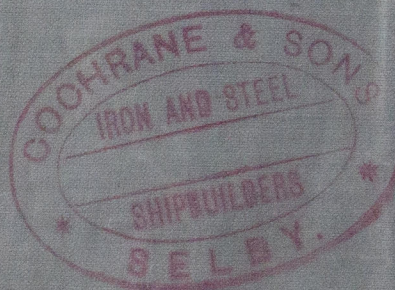

C.B.
11.5.06

Cochran & Sons.

N^{os} 350. 351. 352. 353 & 354

Midship Section.

s/s "Aurora"

Hull Report No. 18458

s/s Anadine.

Hull Report No. 18475

s/s "Achilles" 18538

Hull Report No. —

s/s Agamemnon 18646.

Hull Report No.

s/s Argonaut

Hull Report No 18719

LR

© 2021

Lloyd's Register
Foundation

W 112-0141