

ER

Heating Surface  
634 #

FURNACE FRONTS TO STD DRAWING N<sup>8</sup>



SCALE 3" = 1 FOOT

TENSILE STRENGTH OF SHELL PLATES 28 TO 32 TONS PER SQ



60 PLAIN TUBES  $3\frac{1}{4}$ " EX DIA N° 10WG

28 STAY - - - - - 1/4 THICK MARKED

SINGLE BUTT STRAP  $\frac{2}{8} \times \frac{2}{16}$  THICK

16 RIVET HOLES & FITTING

3\*3\*2 ANGLE



ENG N° 662 INTENDED FOR MESSRS J L THOMPSON & SONS SS N° 454 NOV 20<sup>TH</sup> 06

Eng. N<sup>o</sup> 719 — do — SS N<sup>o</sup> 483 Nov. 4. 10.

1039

— do — SS N<sup>o</sup> 490 Nov 6. 11.

\_\_\_\_\_

\_\_\_\_\_




J. Dickinson & Sons D. Dr. No 1039  
100 lb

for  
J. L. Thompson & Sons No. 490. 7/8

S. Shakespeare Sld Rpts. 25206.

RETAIN

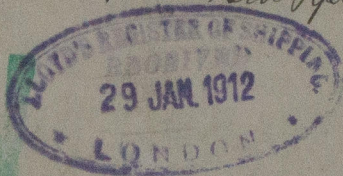

No 3000  
LLOYDS TEST  
200 LBS.  
4-3-12 W.B.

RETAIN



© 2021

Lloyd's Register  
Foundation

W1112-0170