

Received at



Lloyd's Register of British & Foreign Shipping.

(Report on Vessel No. 18475 Port Hull  
s/s *Ariadne*)

No. 720A SHIP FORGINGS OR CASTINGS.

The words FORGINGS or CASTINGS, IRON or STEEL, should be struck out as may be required.

I have to report that the undermentioned Iron or Steel Forgings or Castings, manufactured by *Mr. Thomas Ray* of *Pallam* for the Vessel No. *381*, being built by *Messrs. Cochrane & Sons* of *Selby* have been inspected by *Mr. S. Harrison and me* as set forth below and found to be, so far as can be seen, *Sound*.

Mark on Forgings.



Lloyd's  
No. 720A  
FC

*Frank Booth*

*Sunderland*  
*27-9-06*

	STERN FRAME.	RUDDER FRAME.	STEM.
Material*	<i>Scrap.</i>	<i>Scrap.</i>	
How made	<i>Forged.</i>	<i>Forged.</i>	
Dimensions	<i>6 x 2 1/2</i>	<i>4 1/4 to 3 1/2 x 2 1/2</i>	
Progress on Inspection	<i>Forged &amp; smithed.</i>	<i>Forged &amp; smithed.</i>	
Date when Inspected	<i>11/5/06 to 12/6/06.</i>	<i>31/5/06 to 5/7/06.</i>	

SKETCHES OF FRAMES SHOWING POSITION AND DESCRIPTION OF WELDS OF FORGINGS, OR PARTICULARS OF TESTS APPLIED TO CASTINGS.

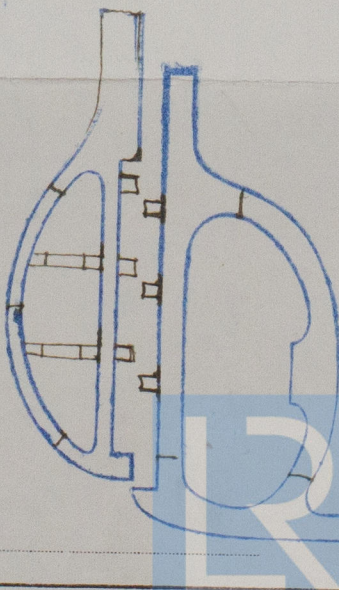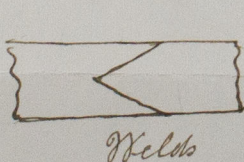

Fee (if any chargeable) £ :

To be paid at :