
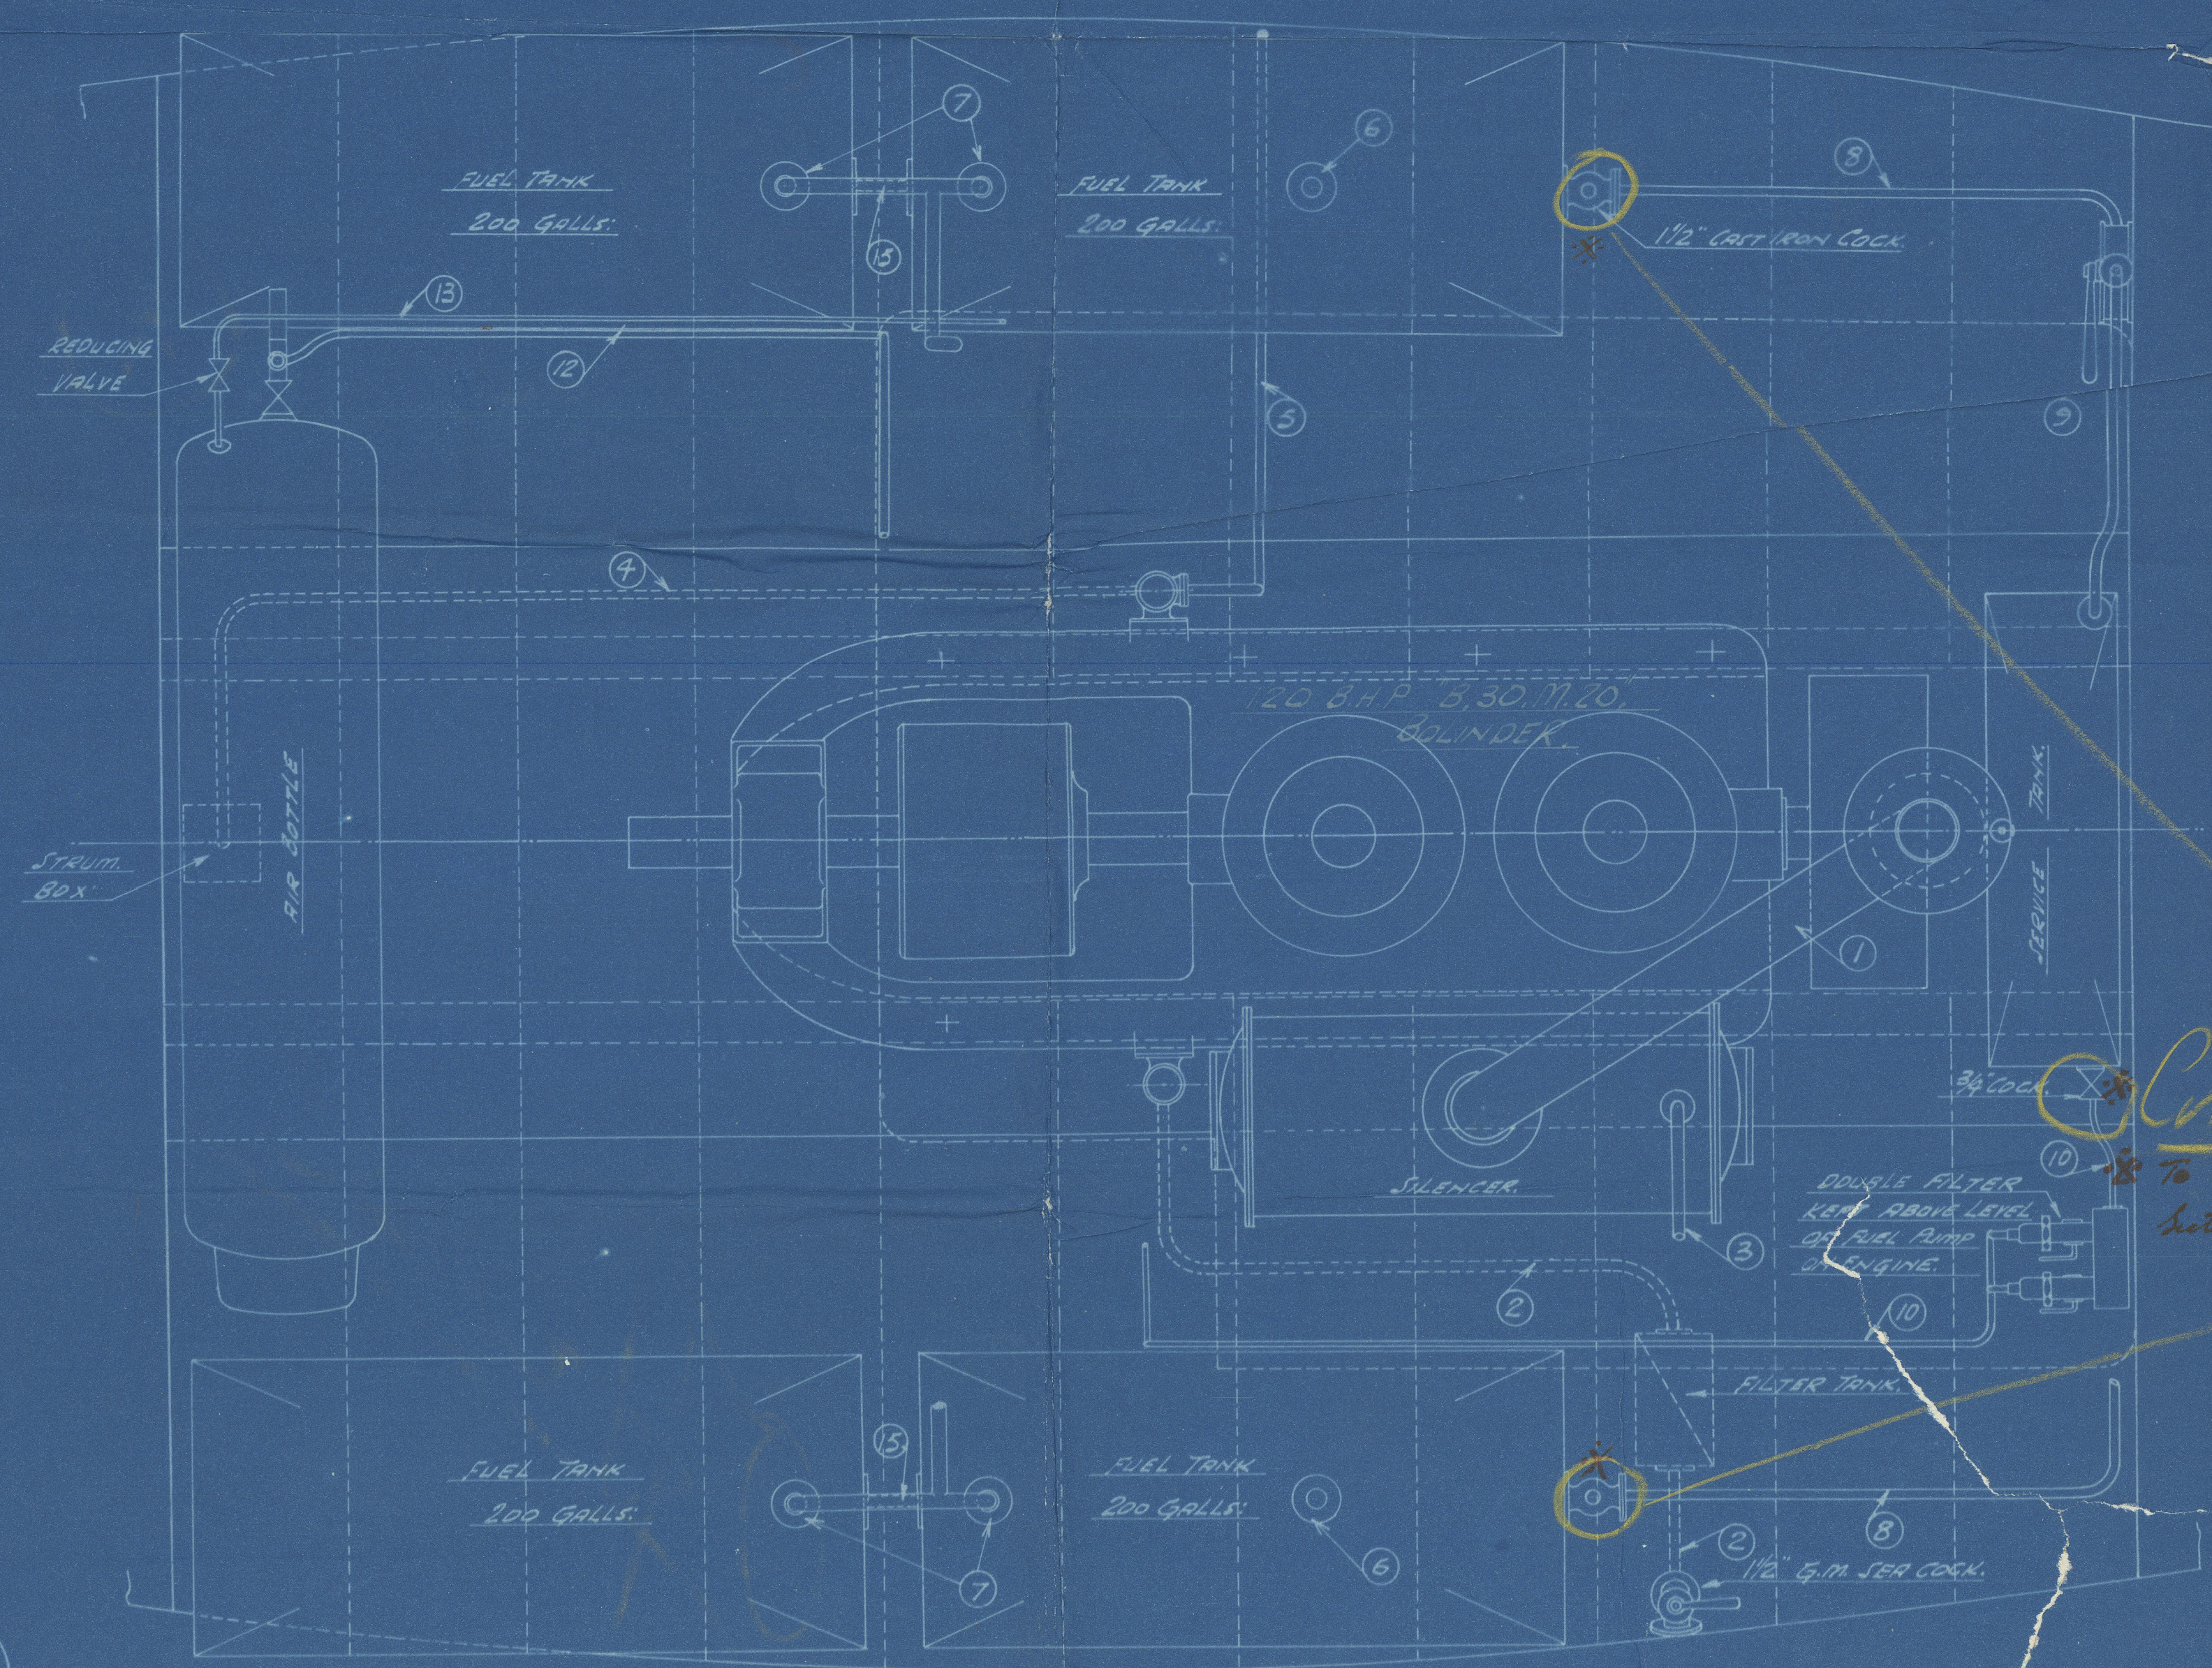
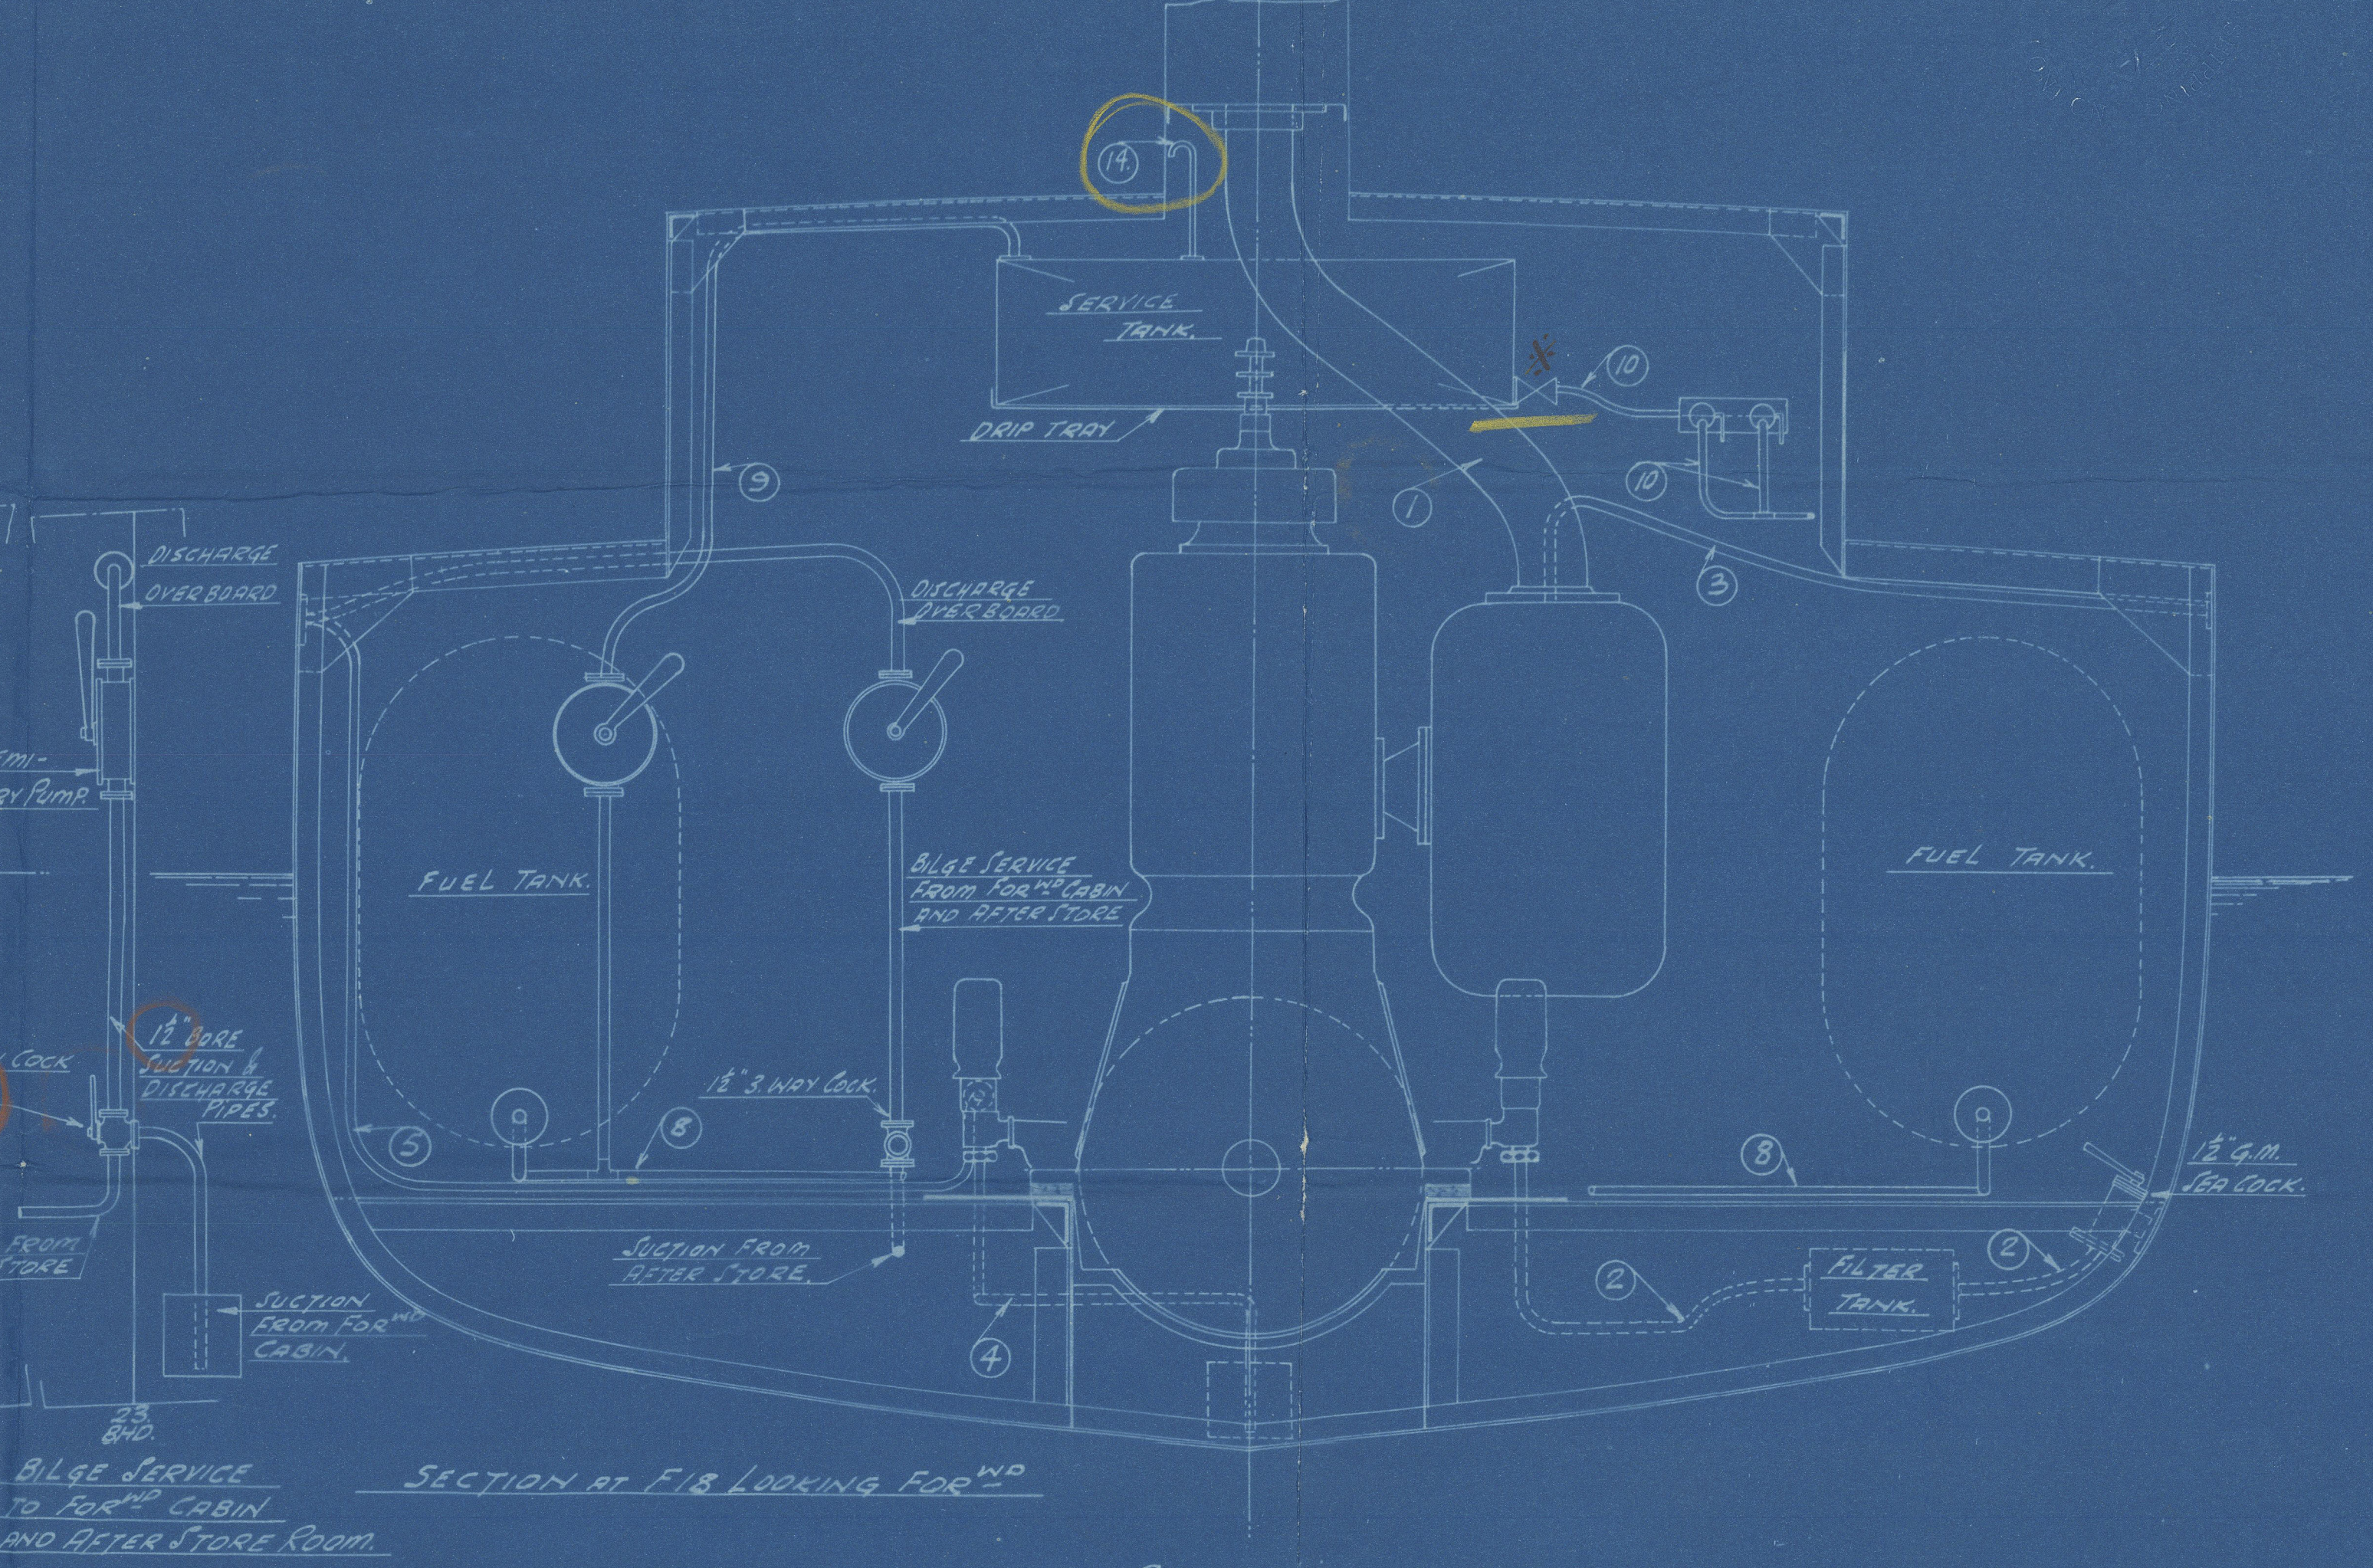


9/6/27

SHIPS Nos 1290/1.
STEEL S. S. MOTOR TUGS.

INSTALLATION PLAN.
DRWG. N° 1136. SCALE 1" = 1 FOOT.

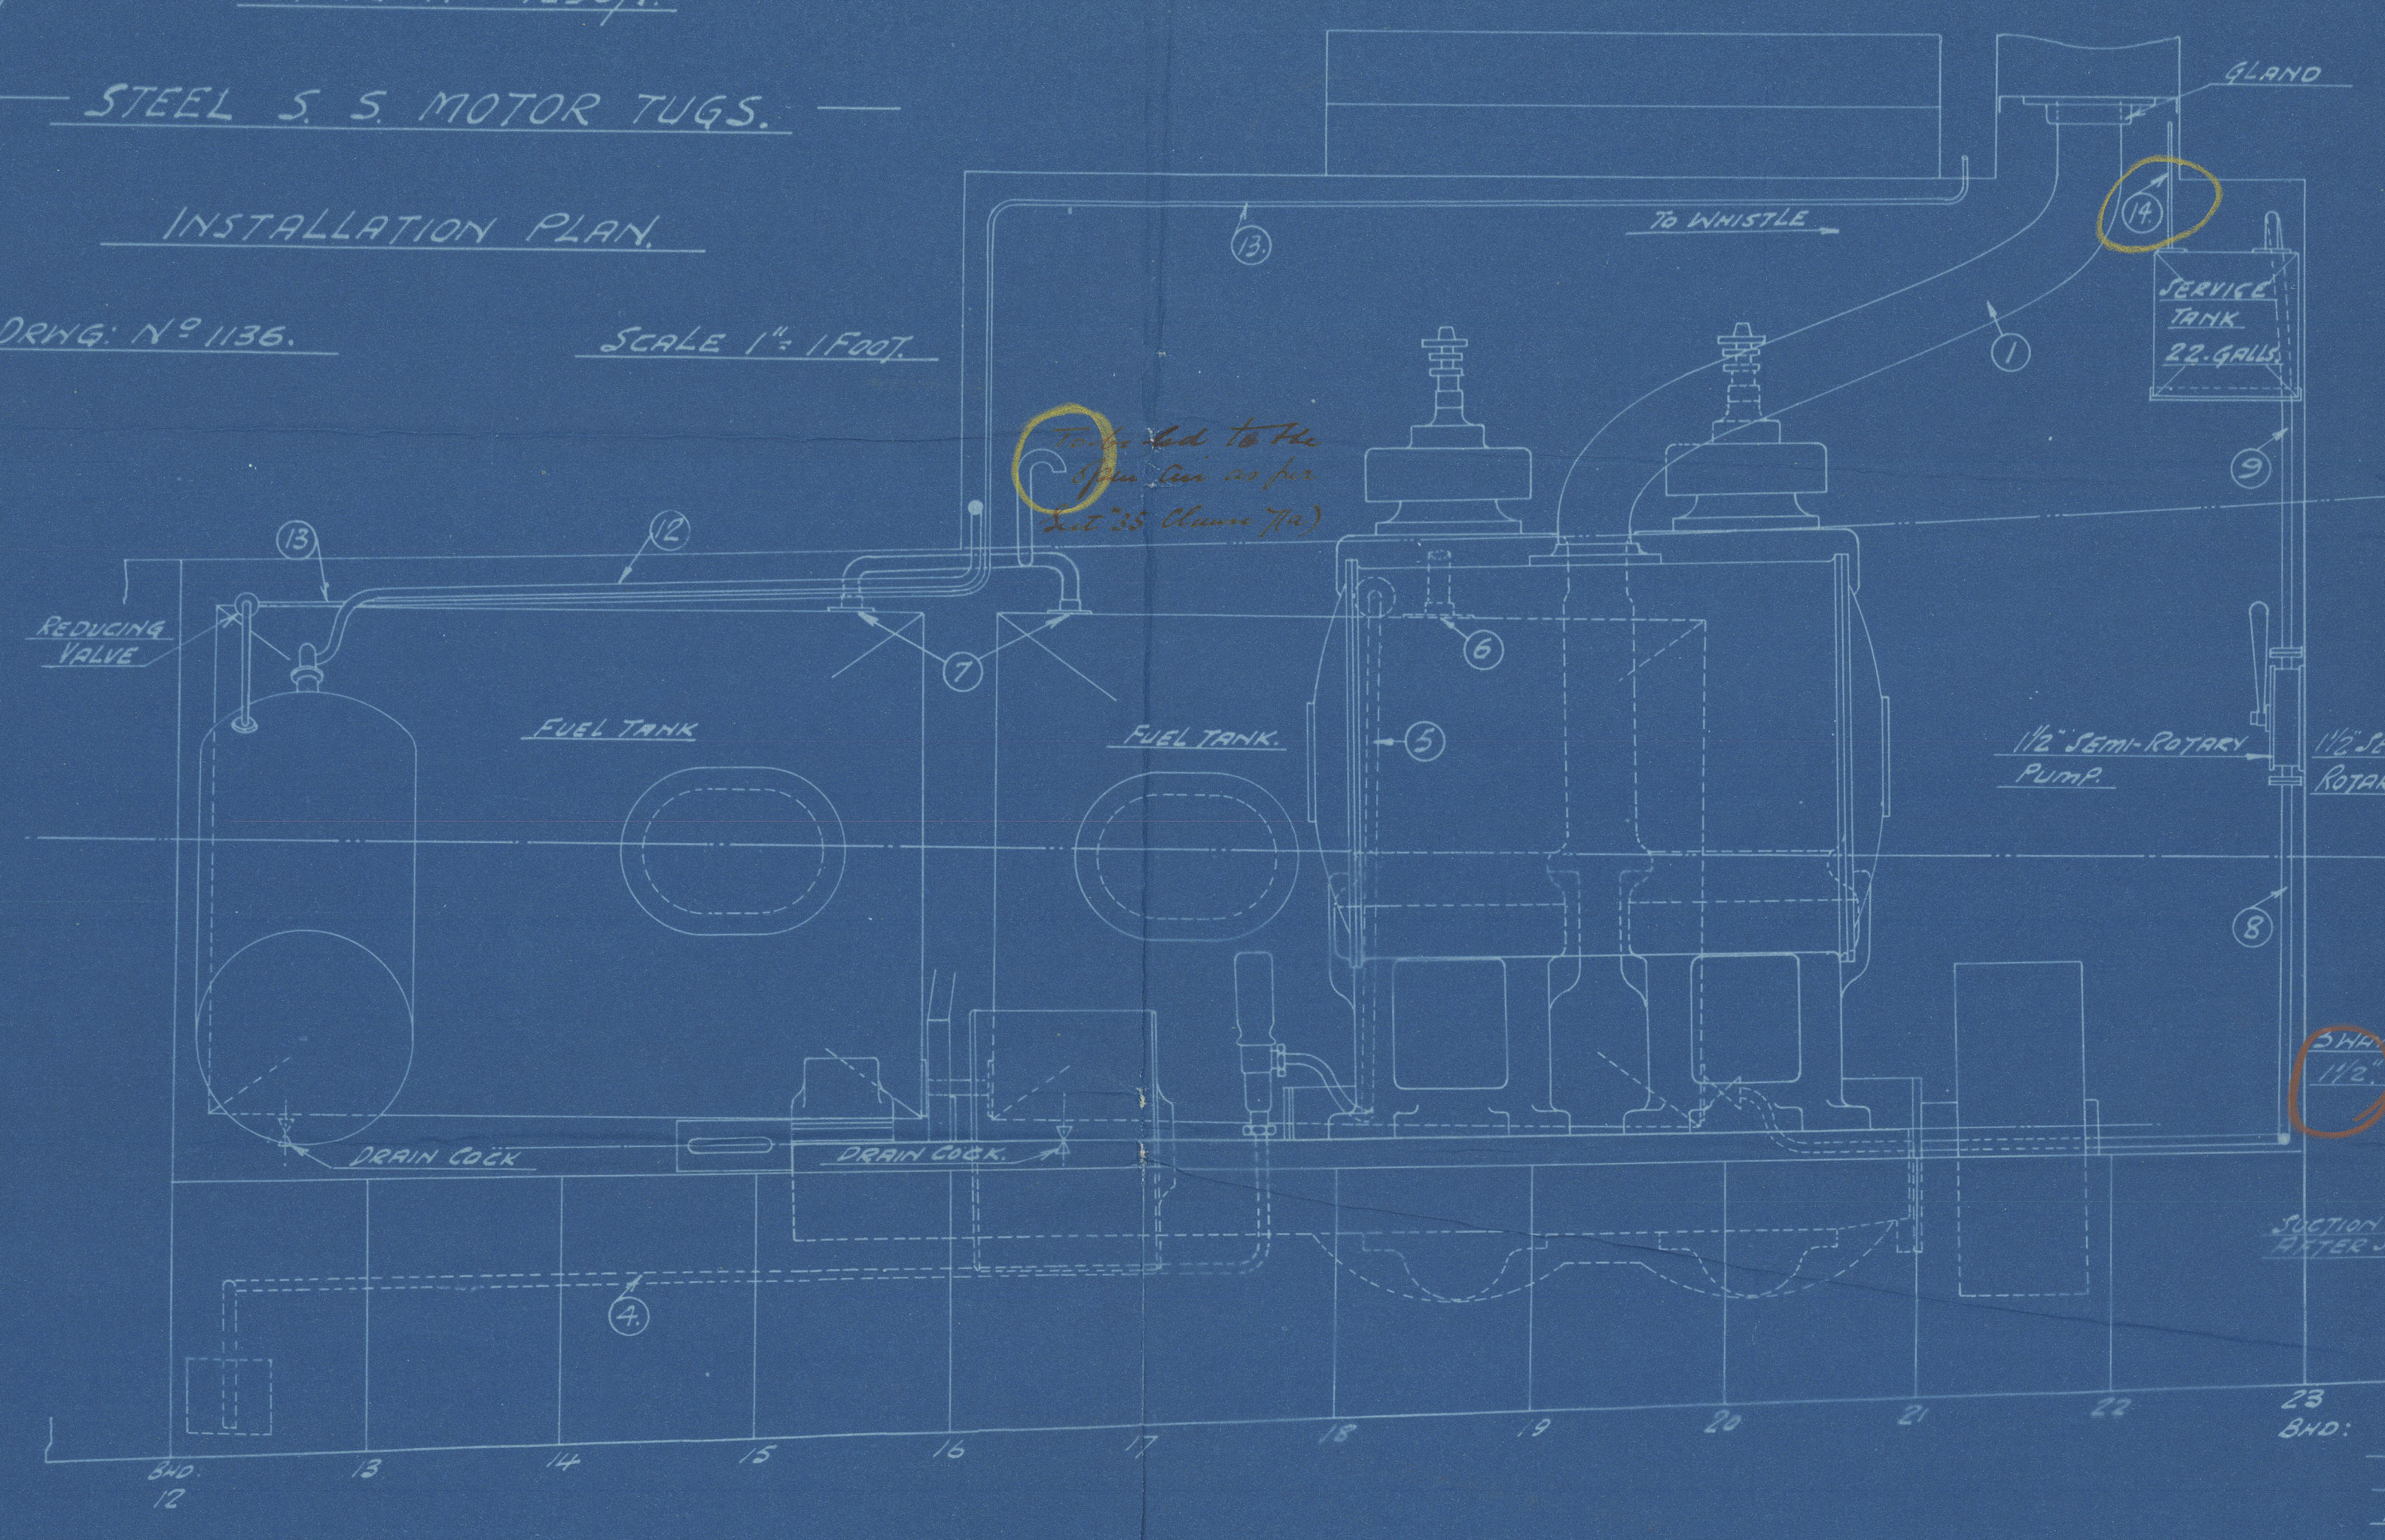

PIPE LIST

N°	DESCRIPTION	MATERIAL	BORE	GAUGE
1	EXHAUST	W. I.	5"	5.
2	CIRCULATING SUCTION FILTER TO PUMP	COPPER	1 1/2"	14
3	"	"	1 1/2"	14
4	BILGE SUCTION	W. I.	1 1/2"	14
5	" DISCHARGE OVERBOARD	"	2"	14
6	FUEL TANK FILLING PIPES	"	2"	14
7	" VENT PIPES	"	2"	14
8	" TO SEMI-ROTARY PUMP	"	1 1/2"	14
9	SEMI-ROTARY PUMP TO SERVICE TANK	"	1 1/2"	14
10	SERVICE TANK FILTERS TO ENGINE	"	3/4"	14
11	AIR STARTING & CHARGING	COPPER	1"	14
12	PIPE TO WHISTLE THROUGH REDUCING VALVE	"	3/8"	16
13	SERVICE TANK VENT PIPE	W. I.	1 1/2"	16
14	LEVELLING PIPE TO TANKS	"	1 1/2"	16

Control

To be controlled as per
Set 35 Class 11(6).


Aldous Ltd

1290-1

Installation

Lm 91743

TUGS. "IPACARY" & "ISIRY"

LON.-91742-91743.



© 2020

Lloyd's Register

Wfouy-0050