

"MEREDITH" PATENT VERTICAL MULTITUBULAR STEEL BOILER 17'-0" HIGH X 8'-0" DIAM. LLOYD'S SURVEY 100 LBS W.P.

No 3534 43510

SCALE 1" = 1 FT

STEEL PLATES & RIVETS.



ALL HOLES DRILLED IN POSITION AFTER BENDING

PLATES NOT LESS THAN 2" TONG TENSILE.

RETAIN

No 3534 & 3510
Naley Bous for
Meredith patent
for
Capps & Son $\frac{2}{3}$ No 199

100 lbs m.p.

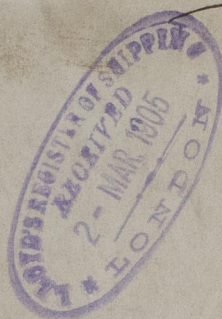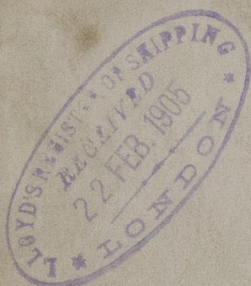

RETAIN

No. 3464
LLOYD'S TEST.
200 lbs.
47m
8-6-05

3510 " $\frac{2}{3}$ Kinnwood"

Mdb report No. 4169

No. 3488
LLOYD'S TEST.
200 lbs.
RDS
21-7-05

26 plates
 $\frac{2}{3}$ Nuttwood
Mdb report No. 4262

W1114 -0134



© 2020

Lloyd's Register
Foundation