




S.S. 199.

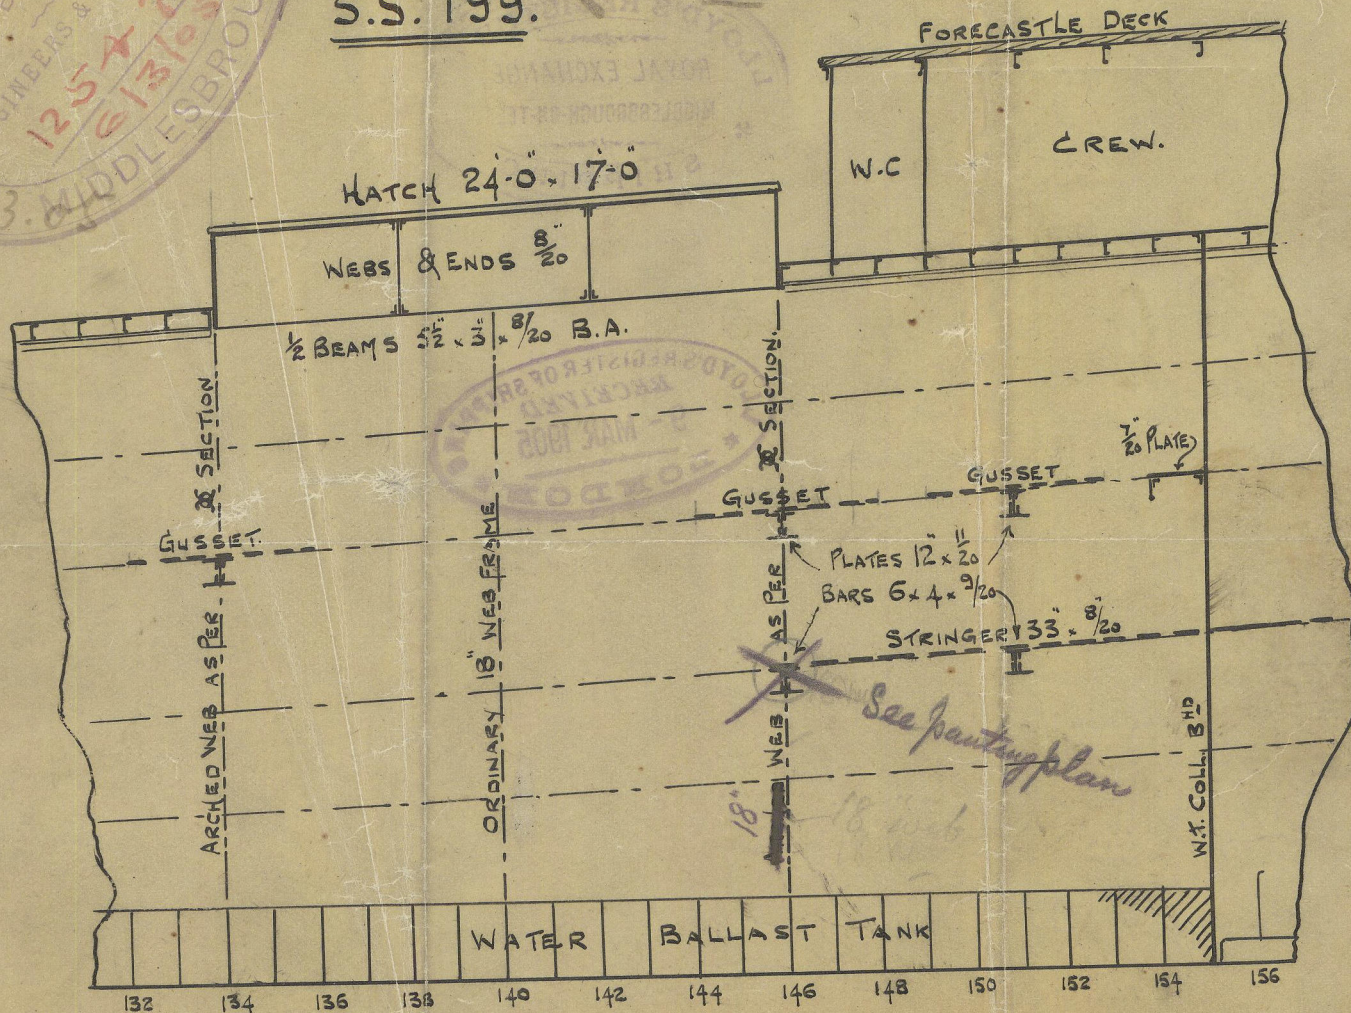

PROPOSED ALTERNATIVE ARRANGEMENT  
IN WAY OF FORE HATCH.




© 2020  
Lloyd's Register  
Foundation

W1114 0136

CP  
10.3.05



Mr R. Craggs Esq  
S. S. No 199.  
Re-arrangement of  
framing in way of  
No 1 Hatchway

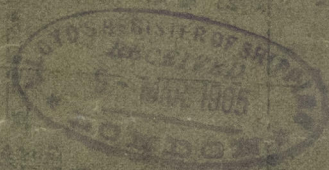

© 2020

Lloyd's Register  
Foundation