




18.1.05



Messrs J. L. THOMPSON & SONS

PROFILE

Nos. 434 & 435

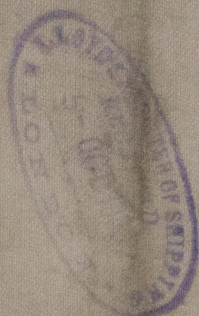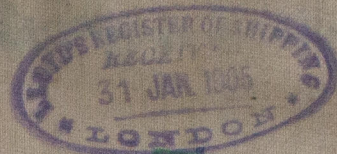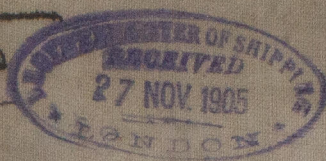

RETAIN

434 SS HERMES  
435 SS HEKTOR  
See Profile as built

Sld. 3. & No. 22435  
Sld. F.E. No. 22532

To be returned for

Sld. F.E. No. 22532

RETAIN



W1115-0018

W1115-0018

W1115-0018

